PARENT PARCEL: 07-00-044-102-011
CHILD PARCEL: AC. CORR. PER SURVEY WILFREDO BARBOSA
STARTING POINT: CL OF CASE RD. & BURNS RD.

22-04935-A

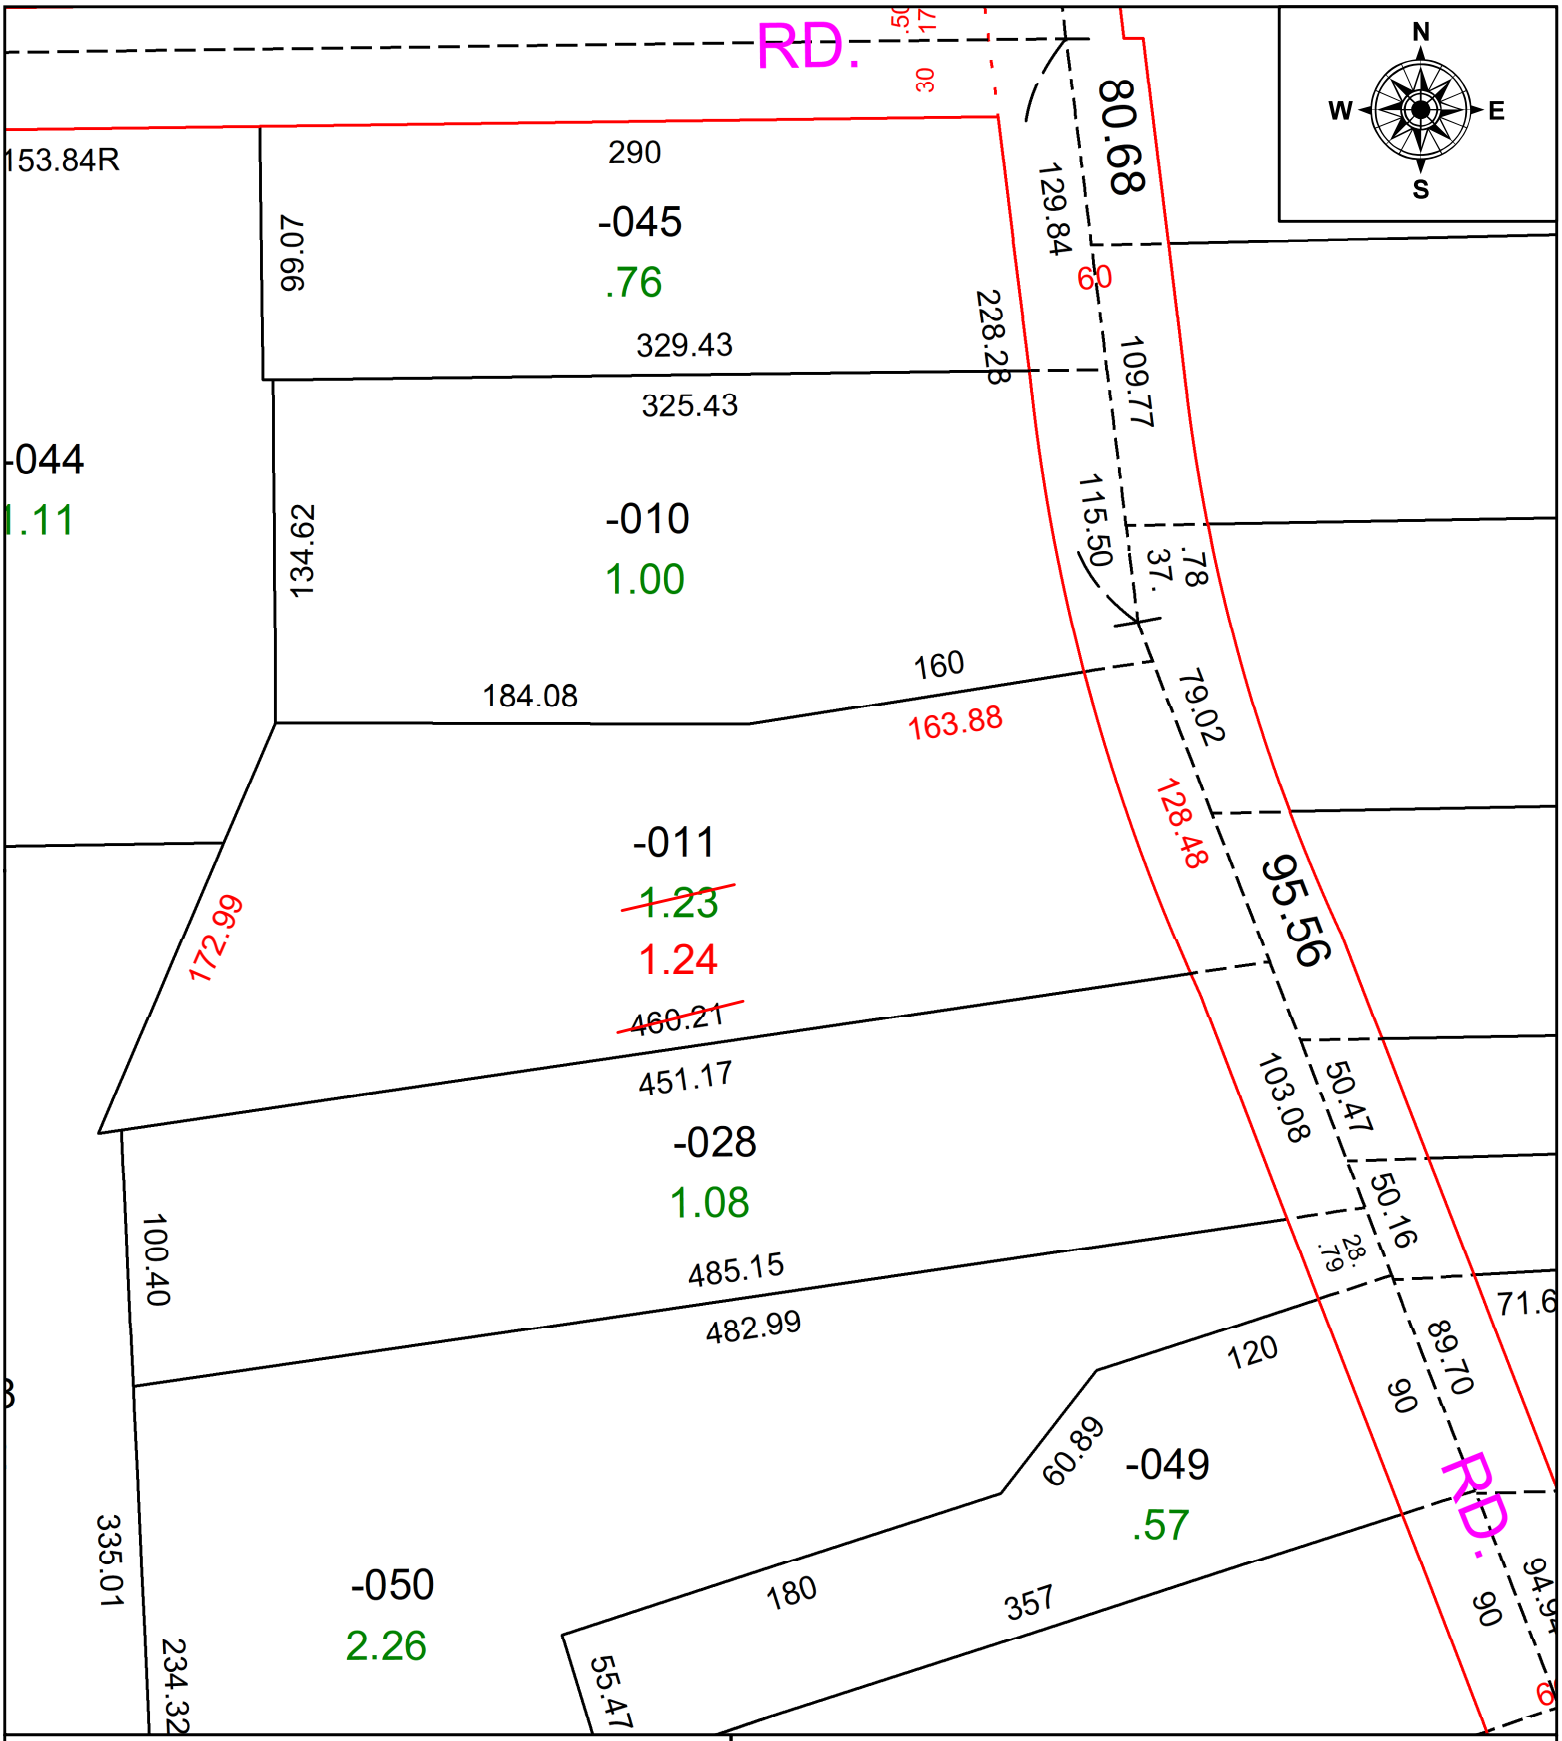

SPLITS/DEEDS PROCESSED
LORAIN COUNTY TAX MAP DEPARTMENT
226 MIDDLE AVE. ELYRIA, OH

SURVEYED BY: WILFREDO BARBOSA **SURVEY #:** 50723
CLOSURE: 1:75387
MAP PAGE(S): 07-00-044
APPOVED BY: DMA **DATE:** 8/19/2022
SCALE: 1" = 75' **PRIOR INSTRUMENT:** 20210851090