PARENT PARCEL: 04-00-022-102-048

CHILD PARCEL: AC CORR PER SURV BY SCOTT J. CASEY

STARTING POINT: C/L OF DETROIT RD AND NAGEL RD

22-04937-A

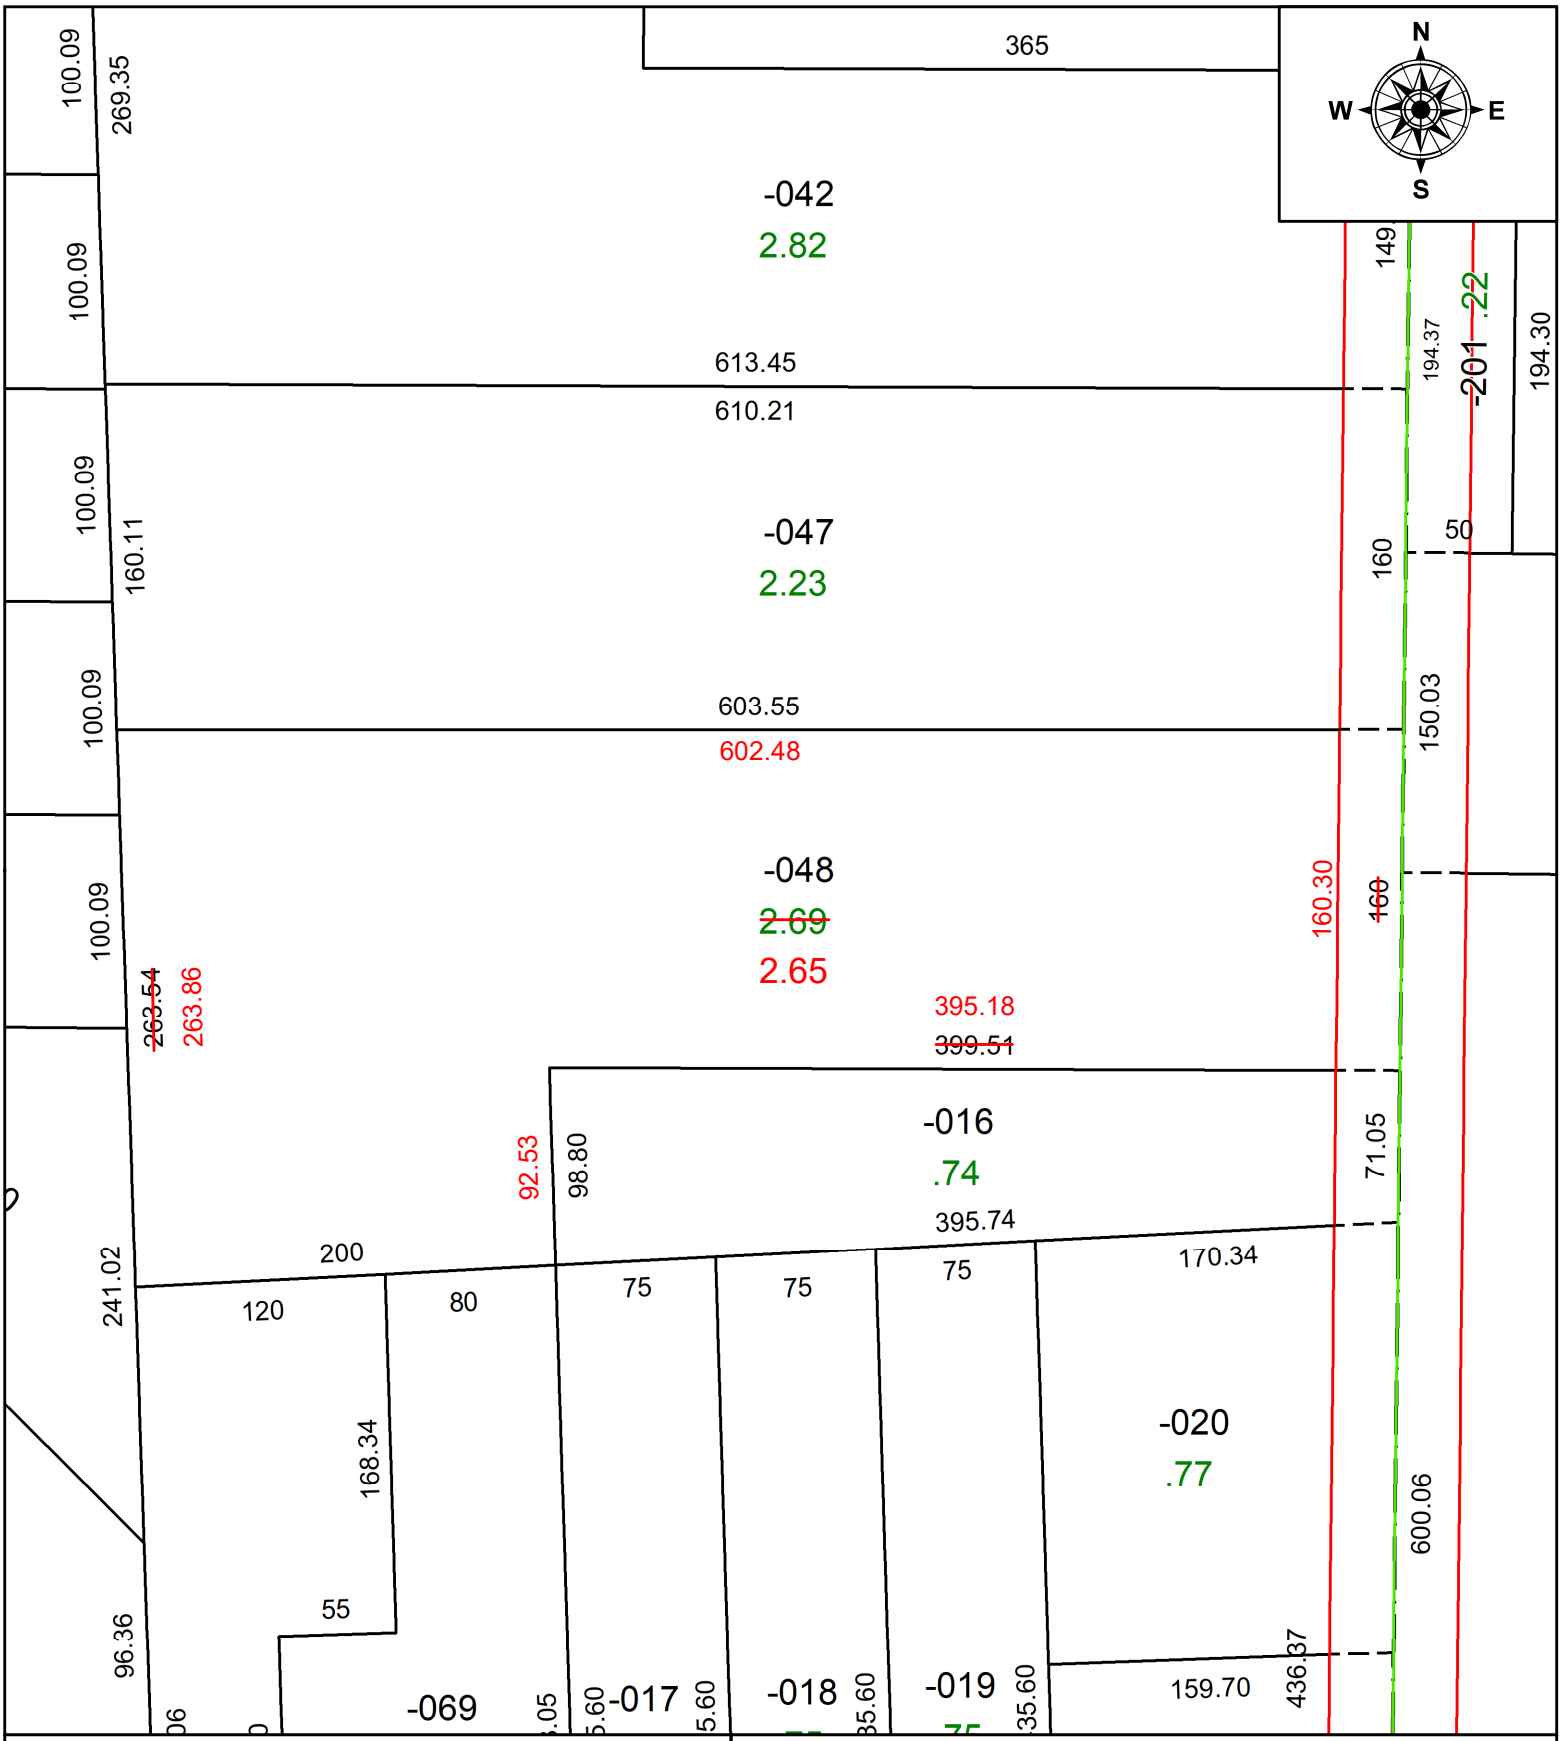

SPLITS/DEEDS PROCESSED

LORAIN COUNTY TAX MAP DEPARTMENT
226 MIDDLE AVE. ELYRIA, OH

SURVEYED BY: SCOTT J. CASEY
CLOSURE: 1: 11735
MAP PAGE(S): 04-00-022-H
APPOVED BY: AC **DATE:** August 23, 2022
SCALE: 1" = 90 **PRIOR INSTRUMENT:** 2022- 0867483