PARENT PARCEL: 05-00-037-110-040 & -016

CHILD PARCEL: 05-00-037-110-041

STARTING POINT: C/Ls OF SOUTH LEAVITT RD AND RICE INDUSTIAL PARKWAY

24-04938

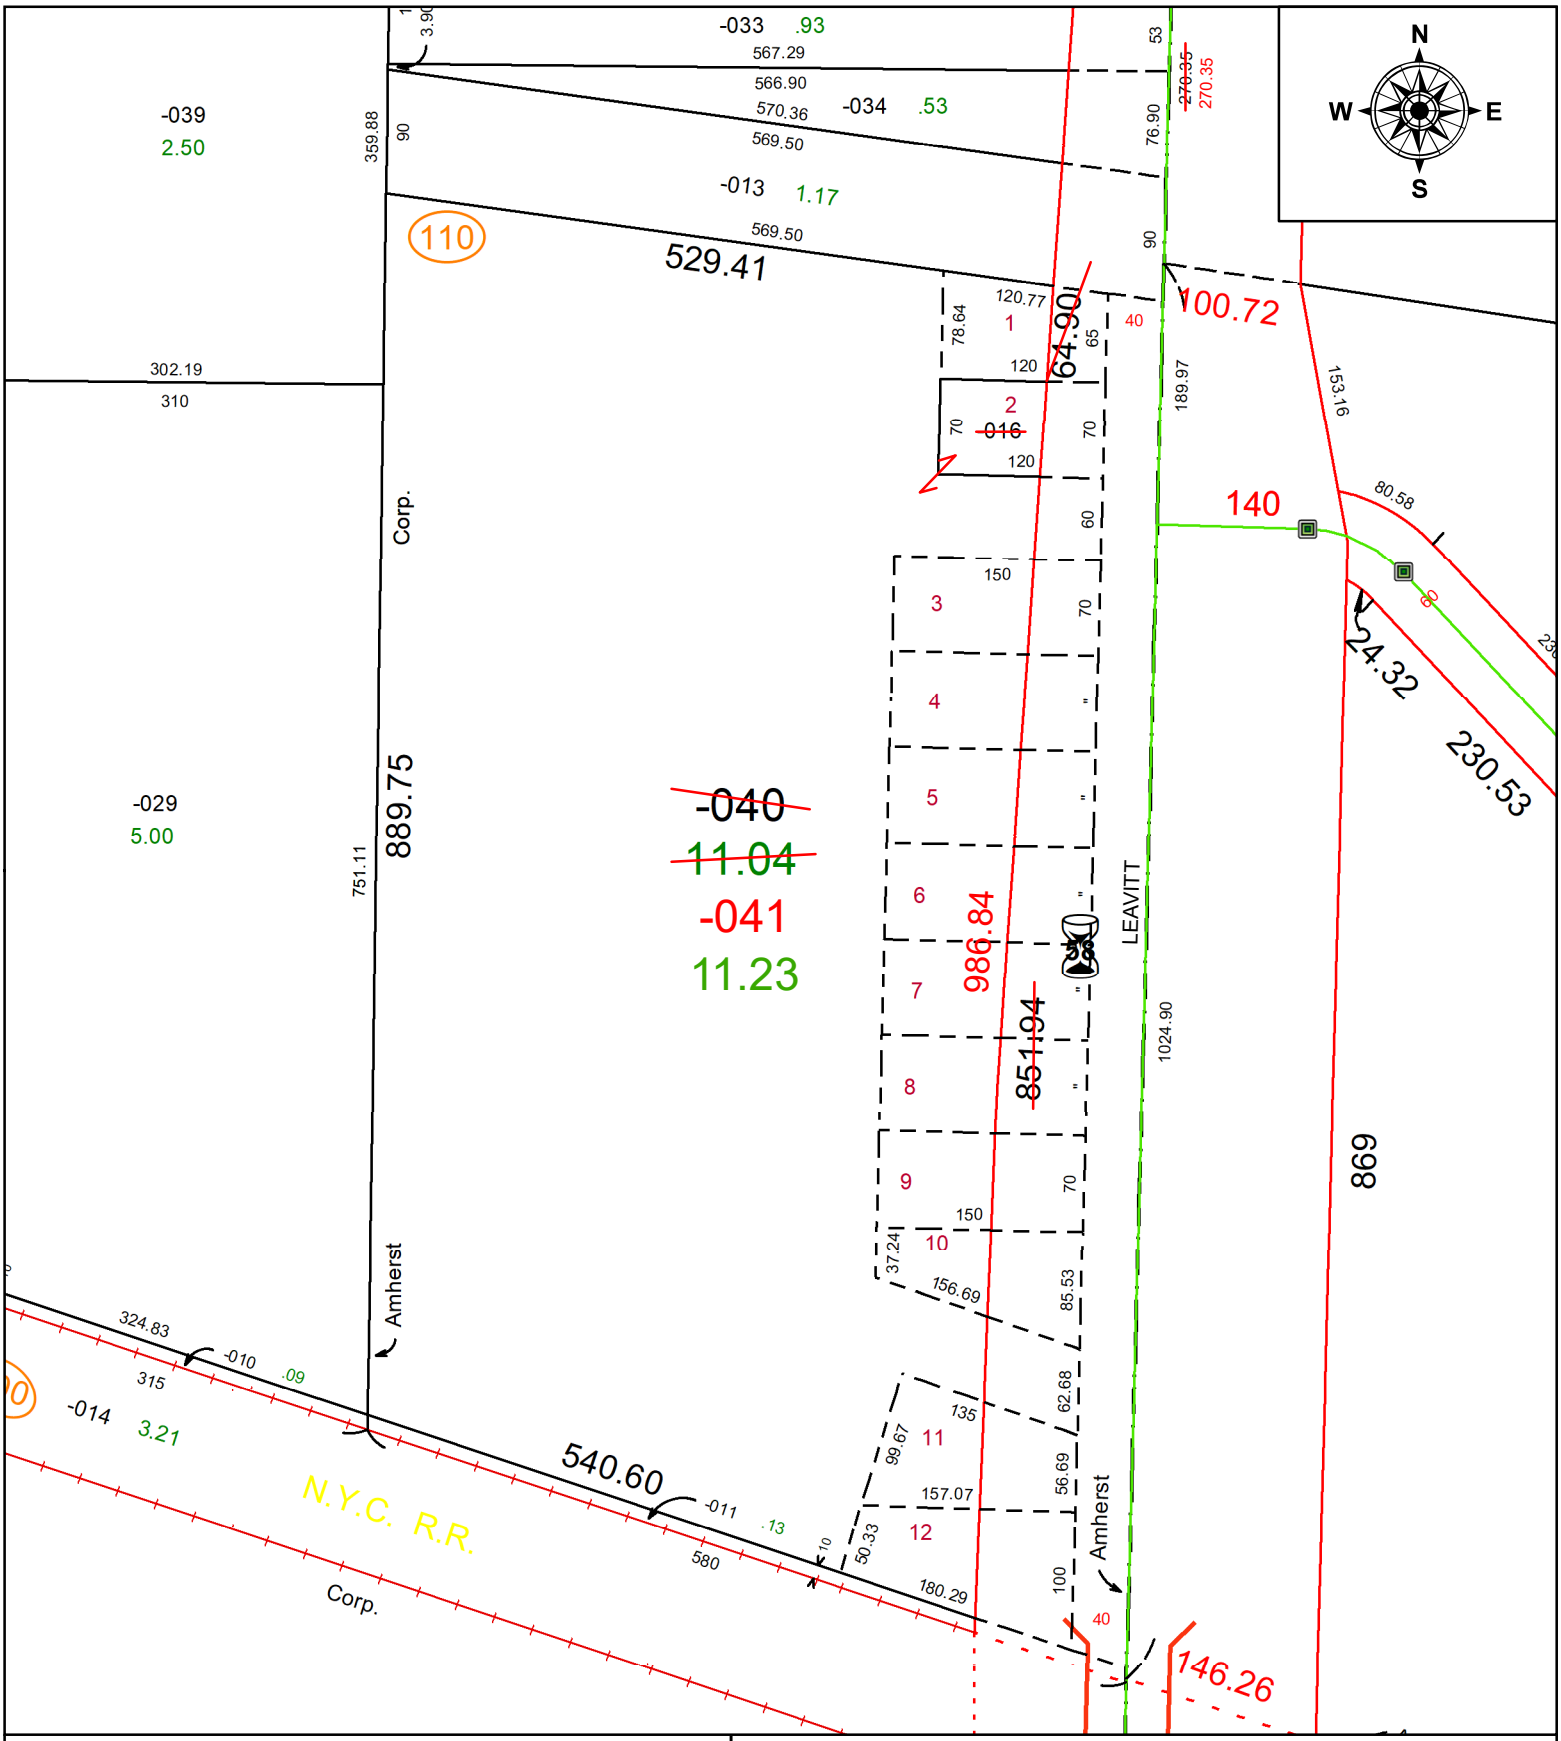

SPLITS/DEEDS PROCESSED

LORAIN COUNTY TAX MAP DEPARTMENT
226 MIDDLE AVE. ELYRIA, OH

SURVEYED BY: DANIEL P. ENGLE **SURVEY #:** 51323

CLOSURE: 1: 434046

MAP PAGE(S): 05-00-037

APPOVED BY: BB **DATE:** 11/13/2024

SCALE: 1" = 140' **PRIOR INSTRUMENT:** #20240025668