PARENT PARCEL: 16-00-006-000-005, 16-00-015-000-004, & 16-00-015-000-027

CHILD PARCEL: 16-00-006-000-005 & 16-00-015-000-043 COMBINATION PER PRIOR DEED DV 1036/700

STARTING POINT: N/A

22-04941-C

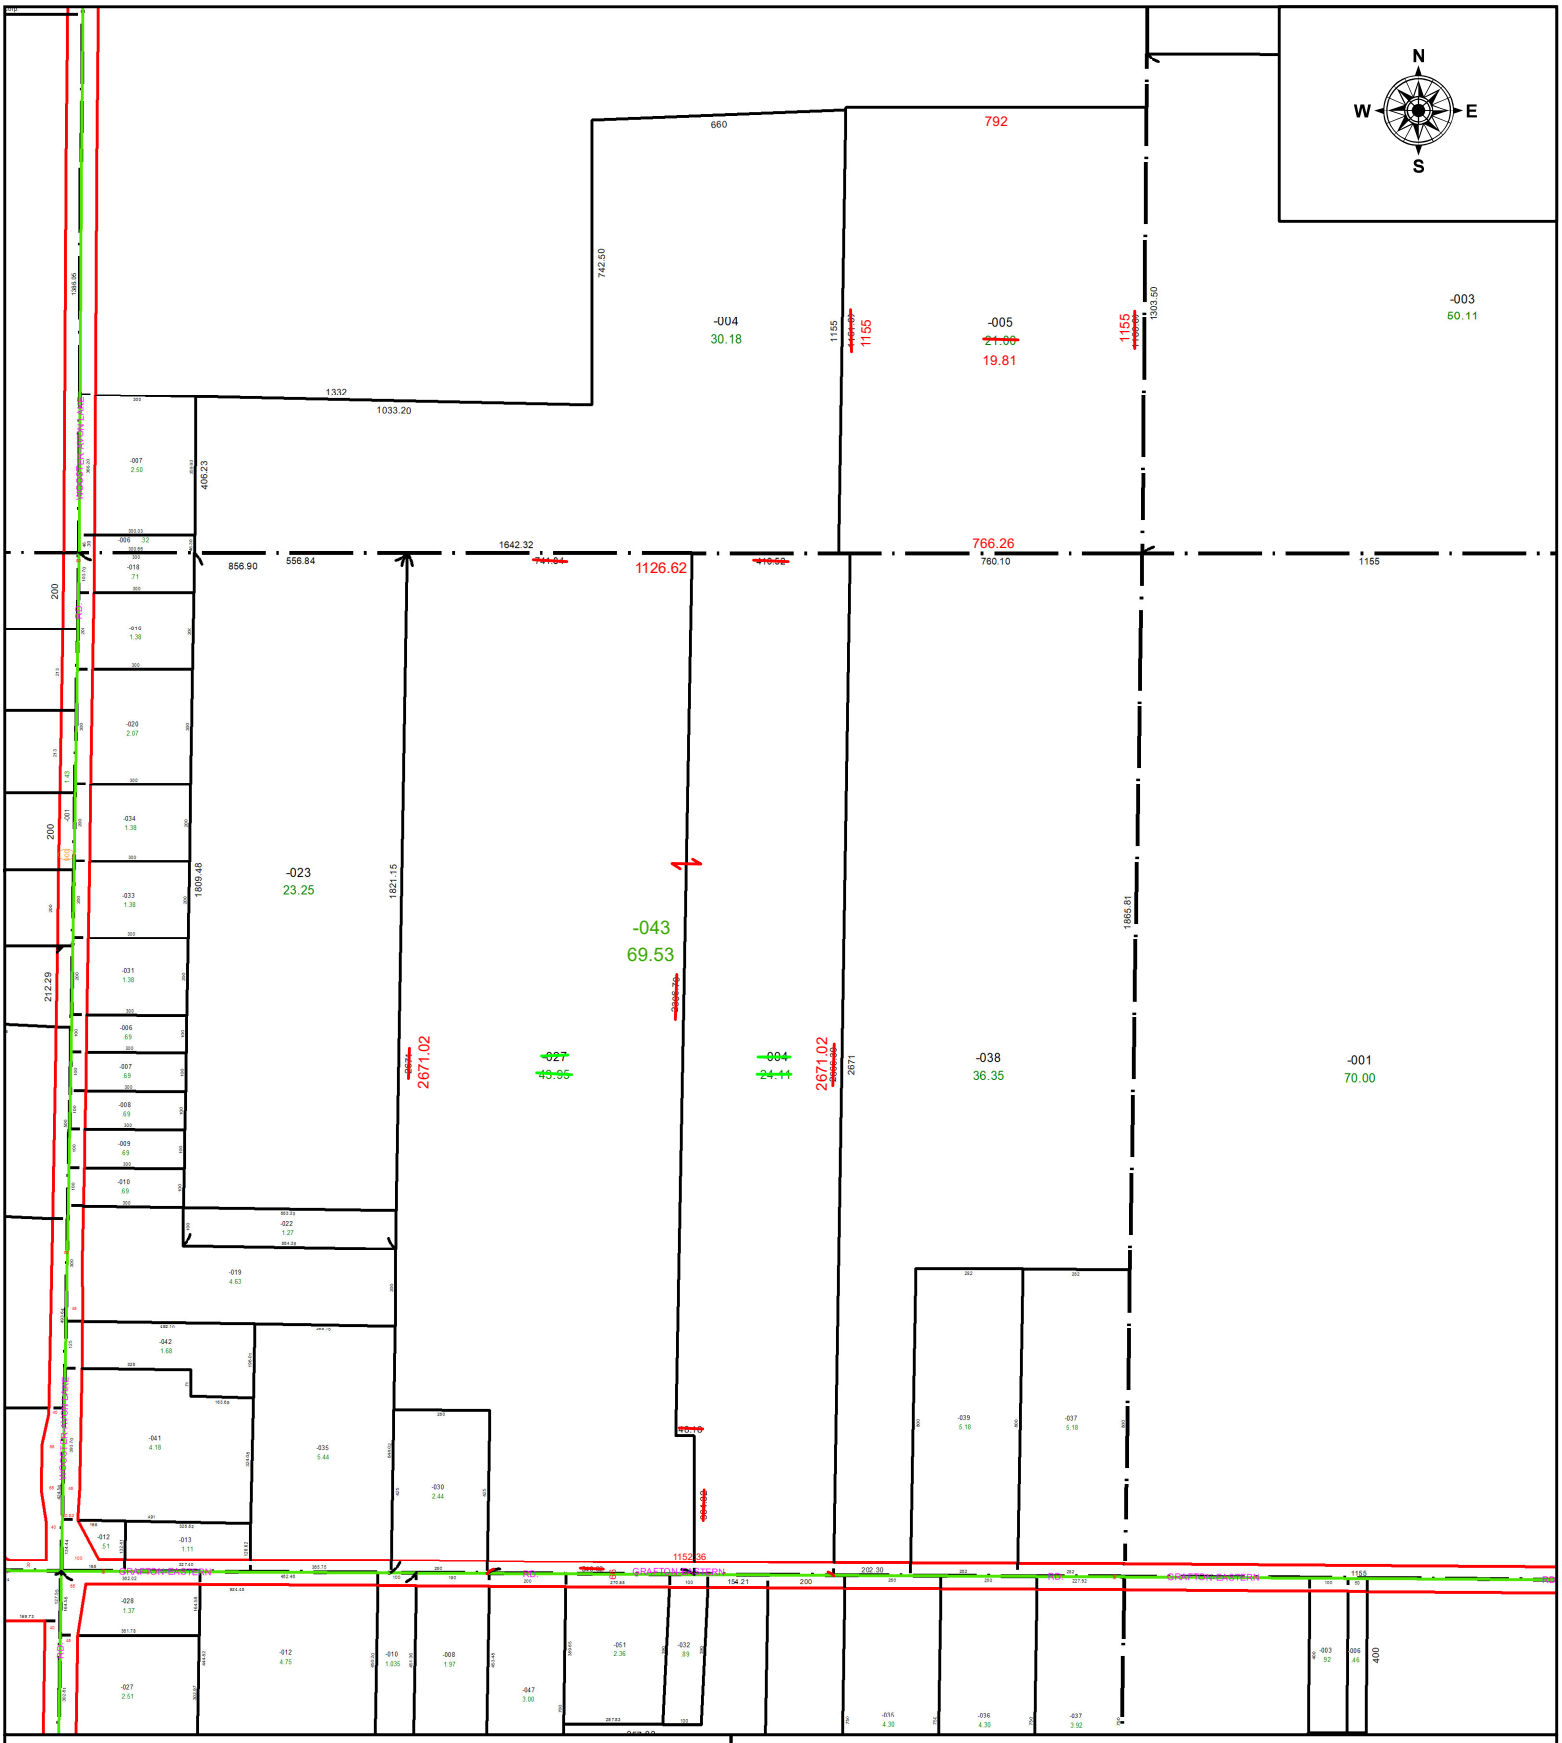

SPLITS/DEEDS PROCESSED

LORAIN COUNTY TAX MAP DEPARTMENT
226 MIDDLE AVE. ELYRIA, OH

SURVEYED BY: N/A SURVEY # N/A
CLOSURE: N/A
MAP PAGE(S): 16-00-006 & 16-00-015
APPOVED BY: WRZ **DATE:** 9/1/2022
SCALE: 1" = 500 **PRIOR INSTRUMENT:** DV 1036/700