PARENT PARCEL: 11-00-070-000-026 & -164

CHILD PARCEL: 11-00-070-000-172 & -173 & -174

STARTING POINT: CENTERLINE OF BUTTERNUT RIDGE RD AND ARCHER RD

24-04947

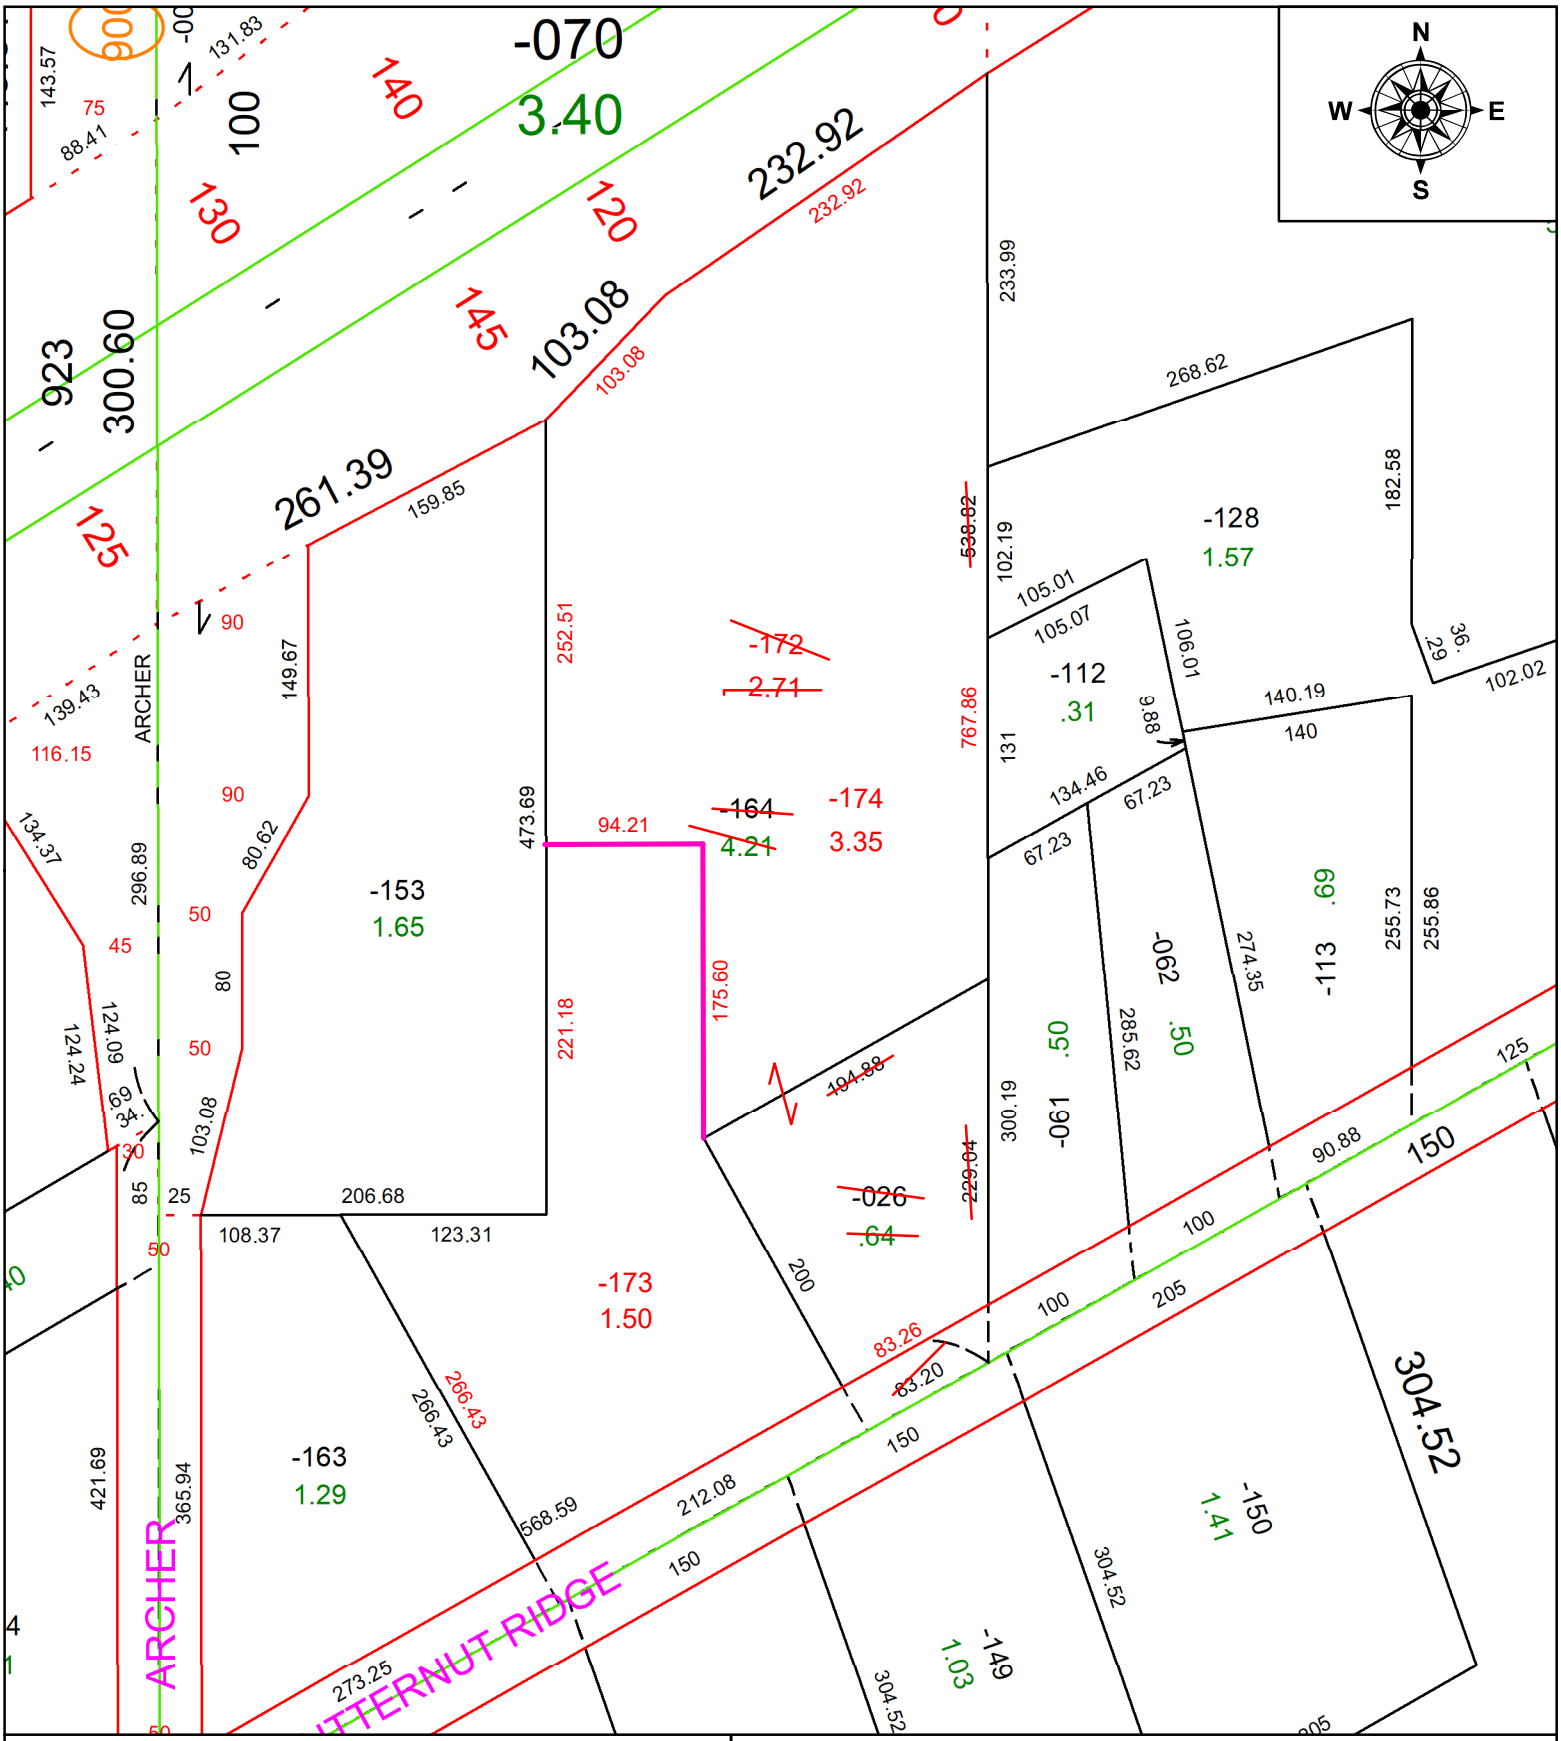

SPLITS/DEEDS PROCESSED

LORAIN COUNTY TAX MAP DEPARTMENT
226 MIDDLE AVE. ELYRIA, OH

SURVEYED BY: THOMAS M. SNEZEK **SURVEY #:** 51346
CLOSURE: 1: 864924
MAP PAGE(S): 1100070
APPOVED BY: BB **DATE:** 12/18/2024
SCALE: 1" = 115' **PRIOR INSTRUMENT:** #20210823616