PARENT PARCEL: 07-00-035-102-015 & -016

CHILD PARCEL: 07-00-035-102-212

STARTING POINT: INTERSECTION OF C/LS OF RACE RD & SUGAR RIDGE RD

24-04948

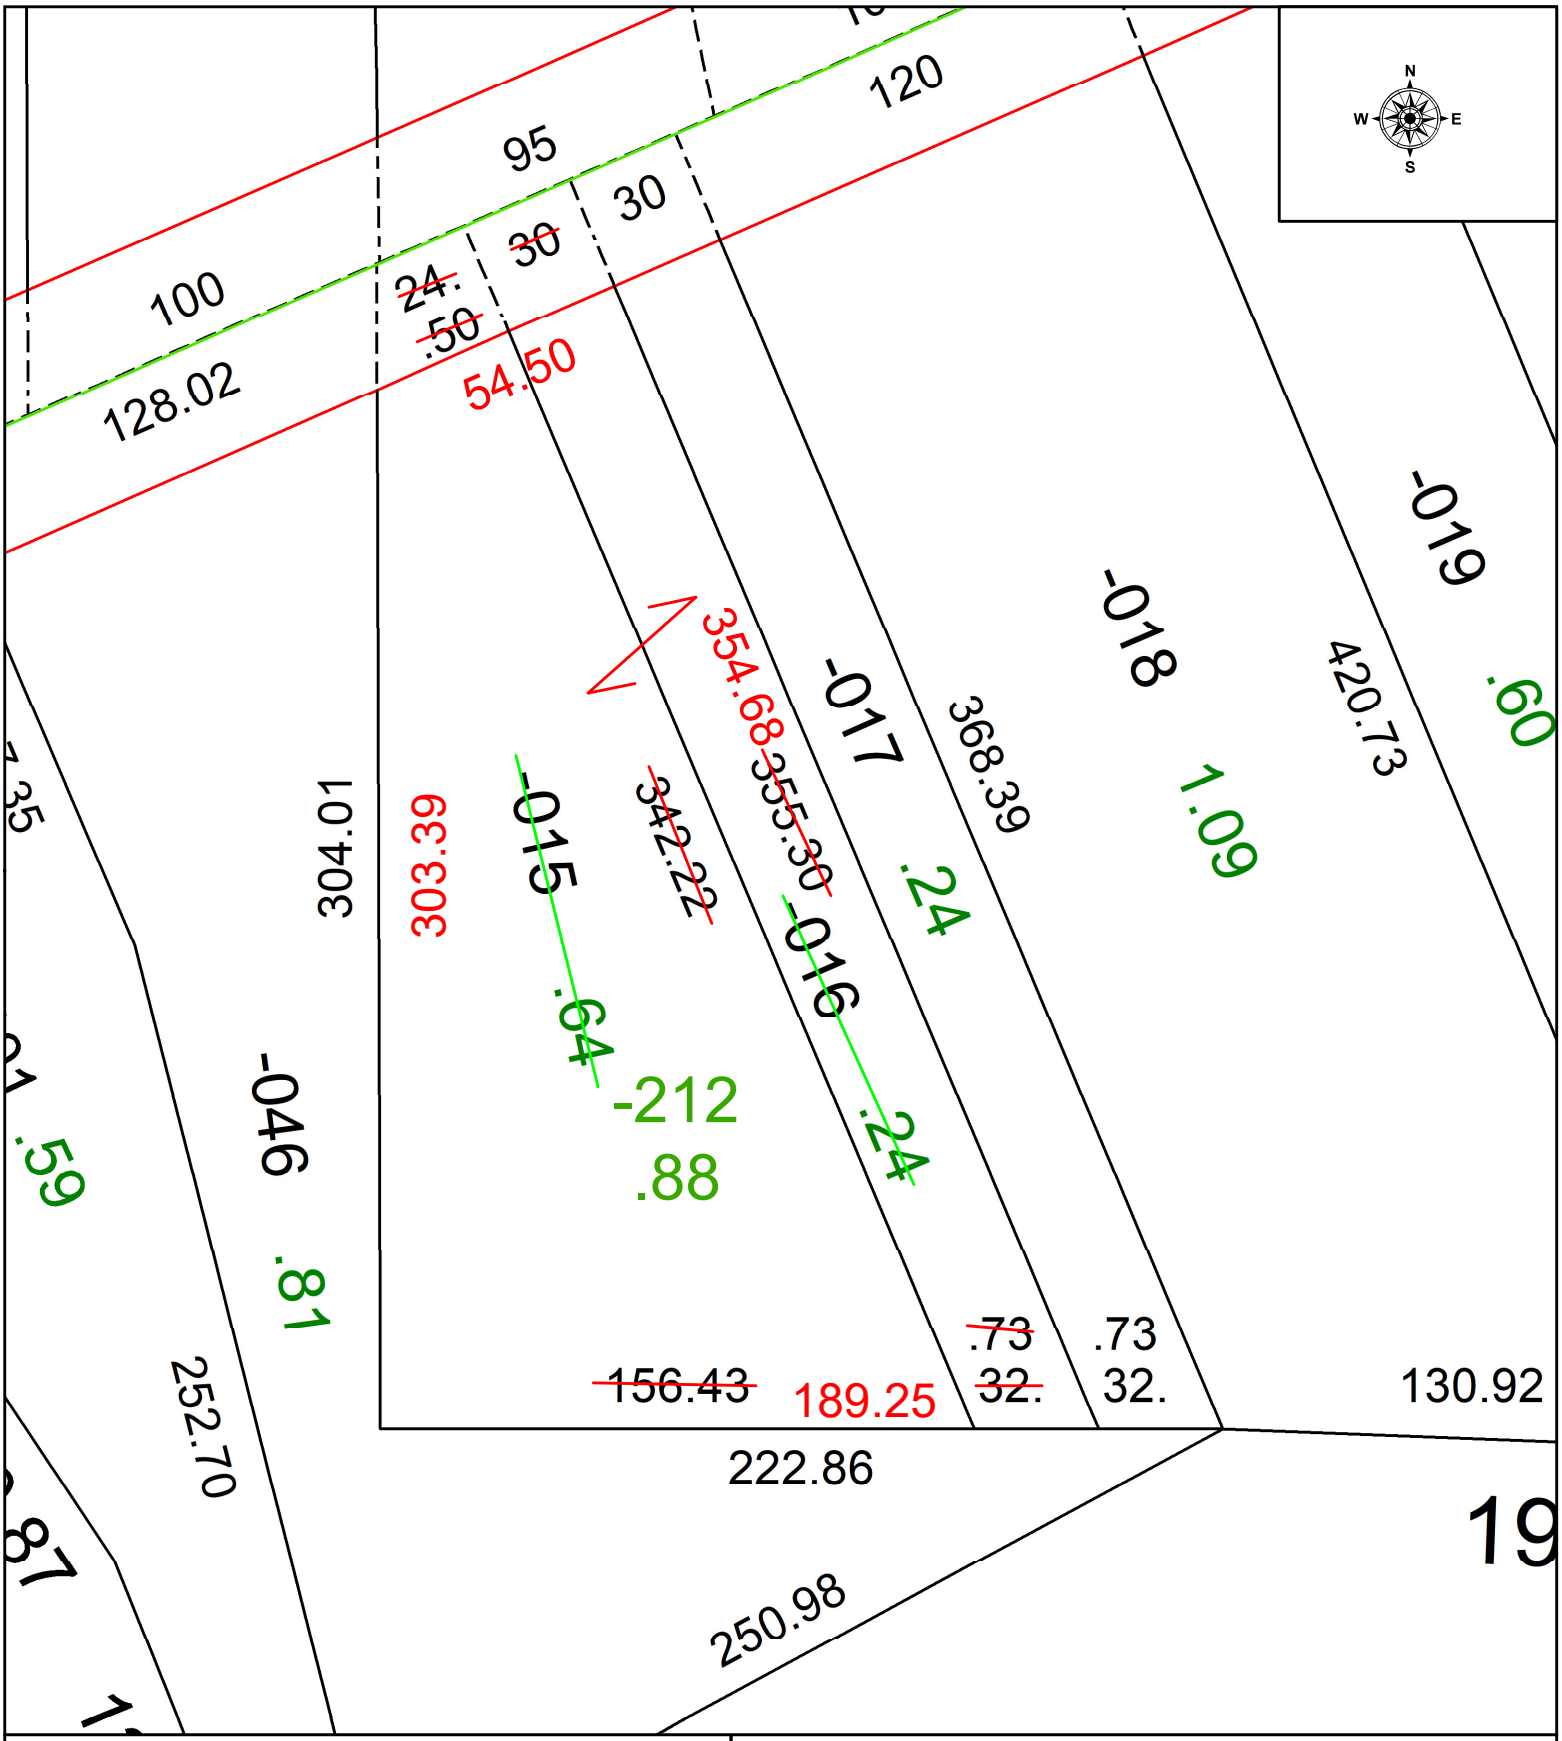

SPLITS/DEEDS PROCESSED

LORAIN COUNTY TAX MAP DEPARTMENT
226 MIDDLE AVE. ELYRIA, OH

SURVEYED BY: WILFREDO BARBOSA SURVEY # 51348

CLOSURE: 1: 53388

MAP PAGE(S): 07-00-035

APPOVED BY: WRZ **DATE:** 12/19/2024

SCALE: 1" = 50 **PRIOR INSTRUMENT:** #2022-0900711