PARENT PARCEL: 13-10-003-000-012

CHILD PARCEL: 13-10-003-000-032 & -033

STARTING POINT: AC CORR PER SURV BY WILFREDO BARBOSA

24-04952

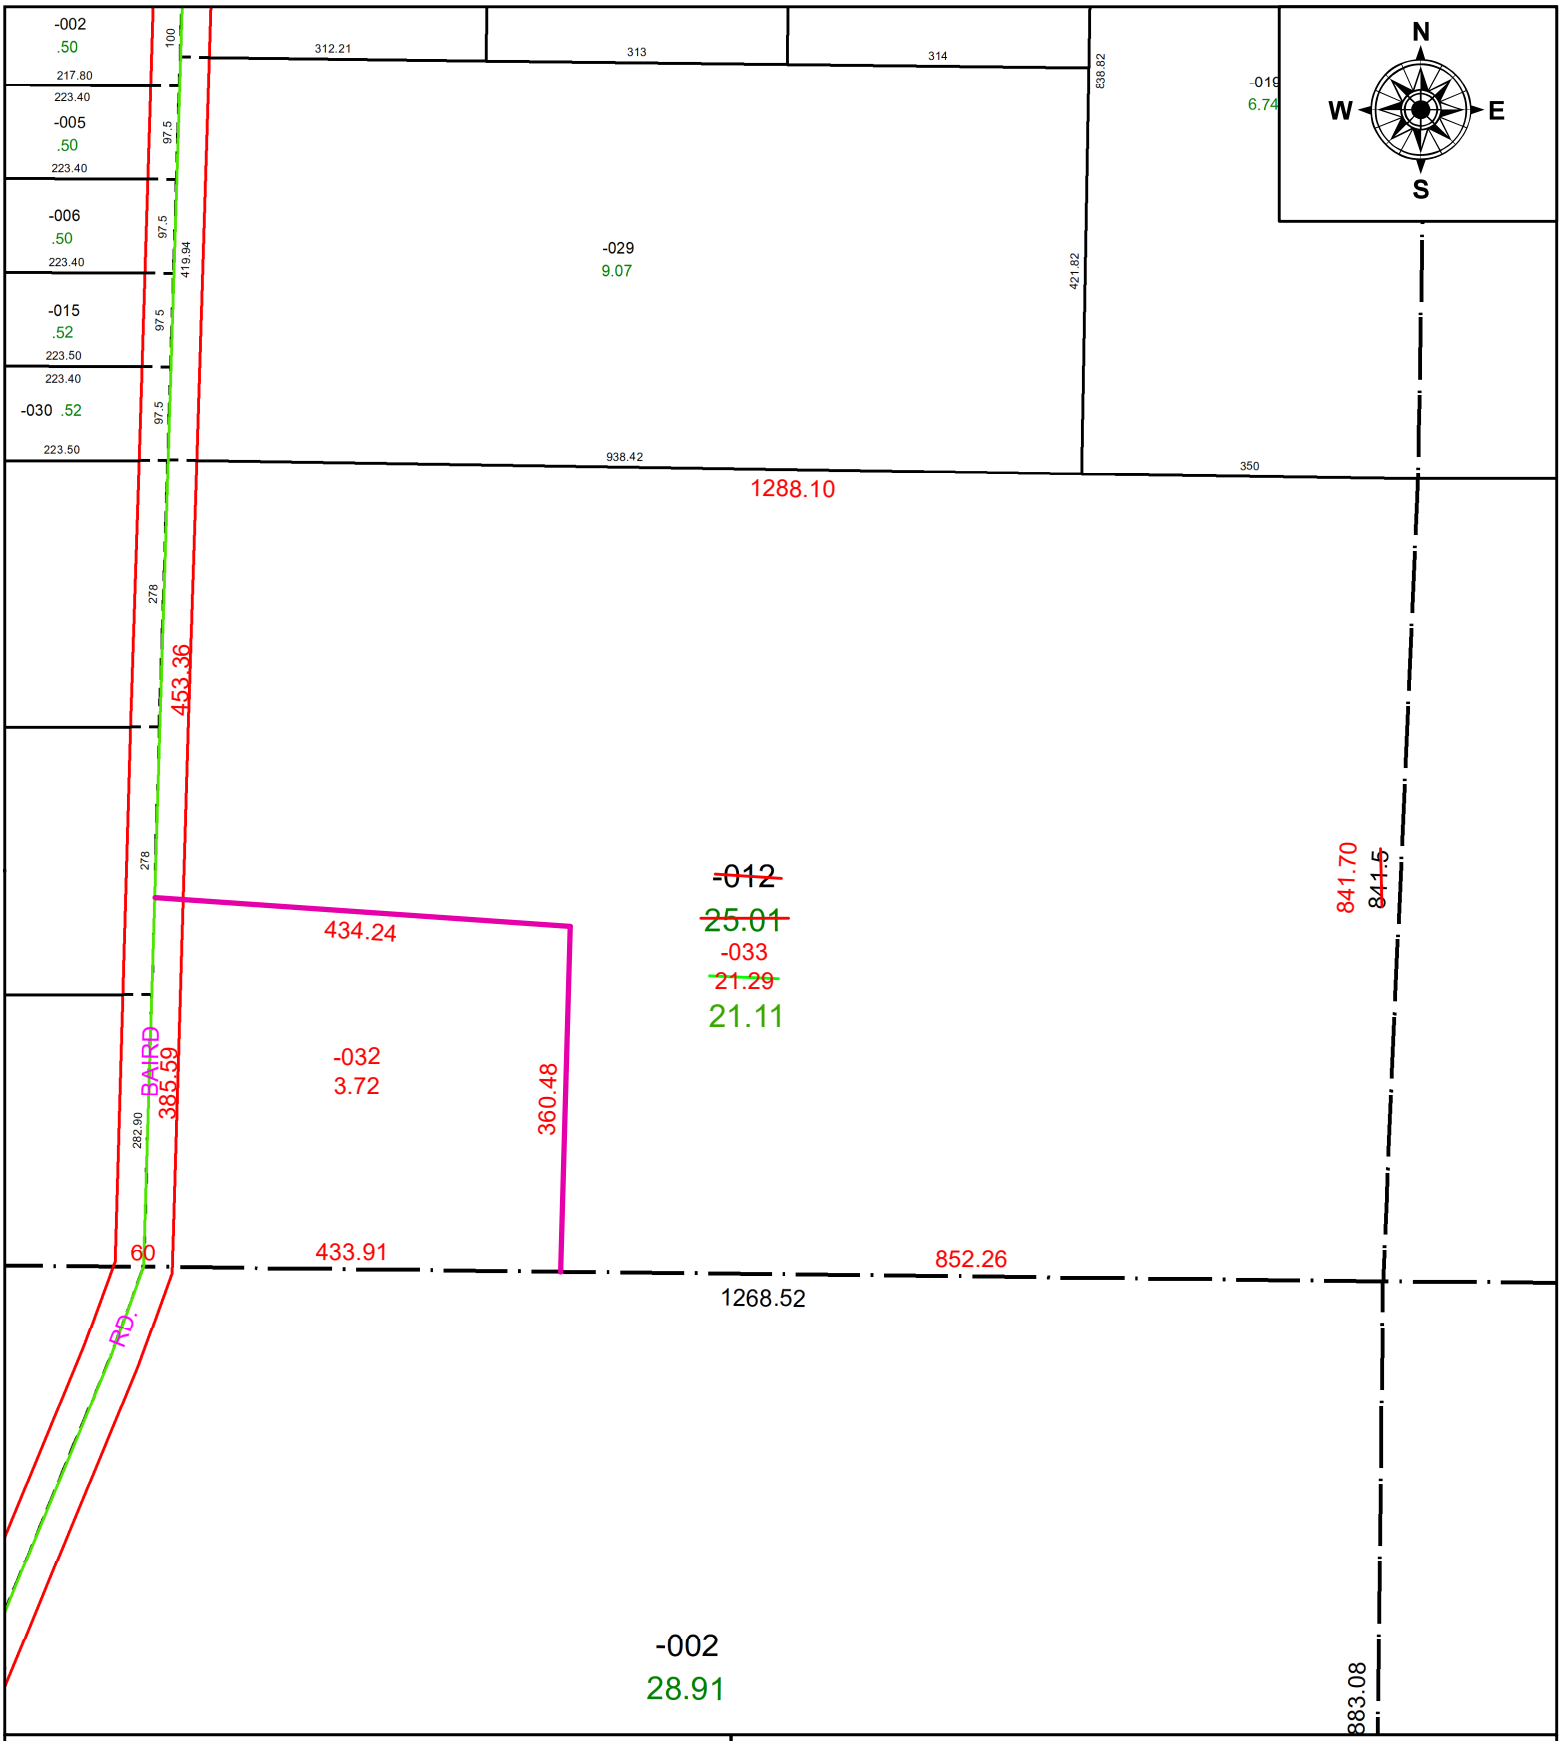

SPLITS/DEEDS PROCESSED

LORAIN COUNTY TAX MAP DEPARTMENT
226 MIDDLE AVE. ELYRIA, OH

SURVEYED BY: WILFREDO BARBOSA **SURV # 51354**

CLOSURE: 1: 100789

MAP PAGE(S): 13-10-003

APPOVED BY: AC **DATE:** December 26, 2024

SCALE: 1 in = 200 ft **PRIOR INSTRUMENT:** 2024- 0013635