PARENT PARCEL: 04-00-018-115-009

CHILD PARCEL: 04-00-018-115-062 & -063

STARTING POINT: INTERSECTION OF AVON BELDEN RD & GLENVIEW DR

25-04953

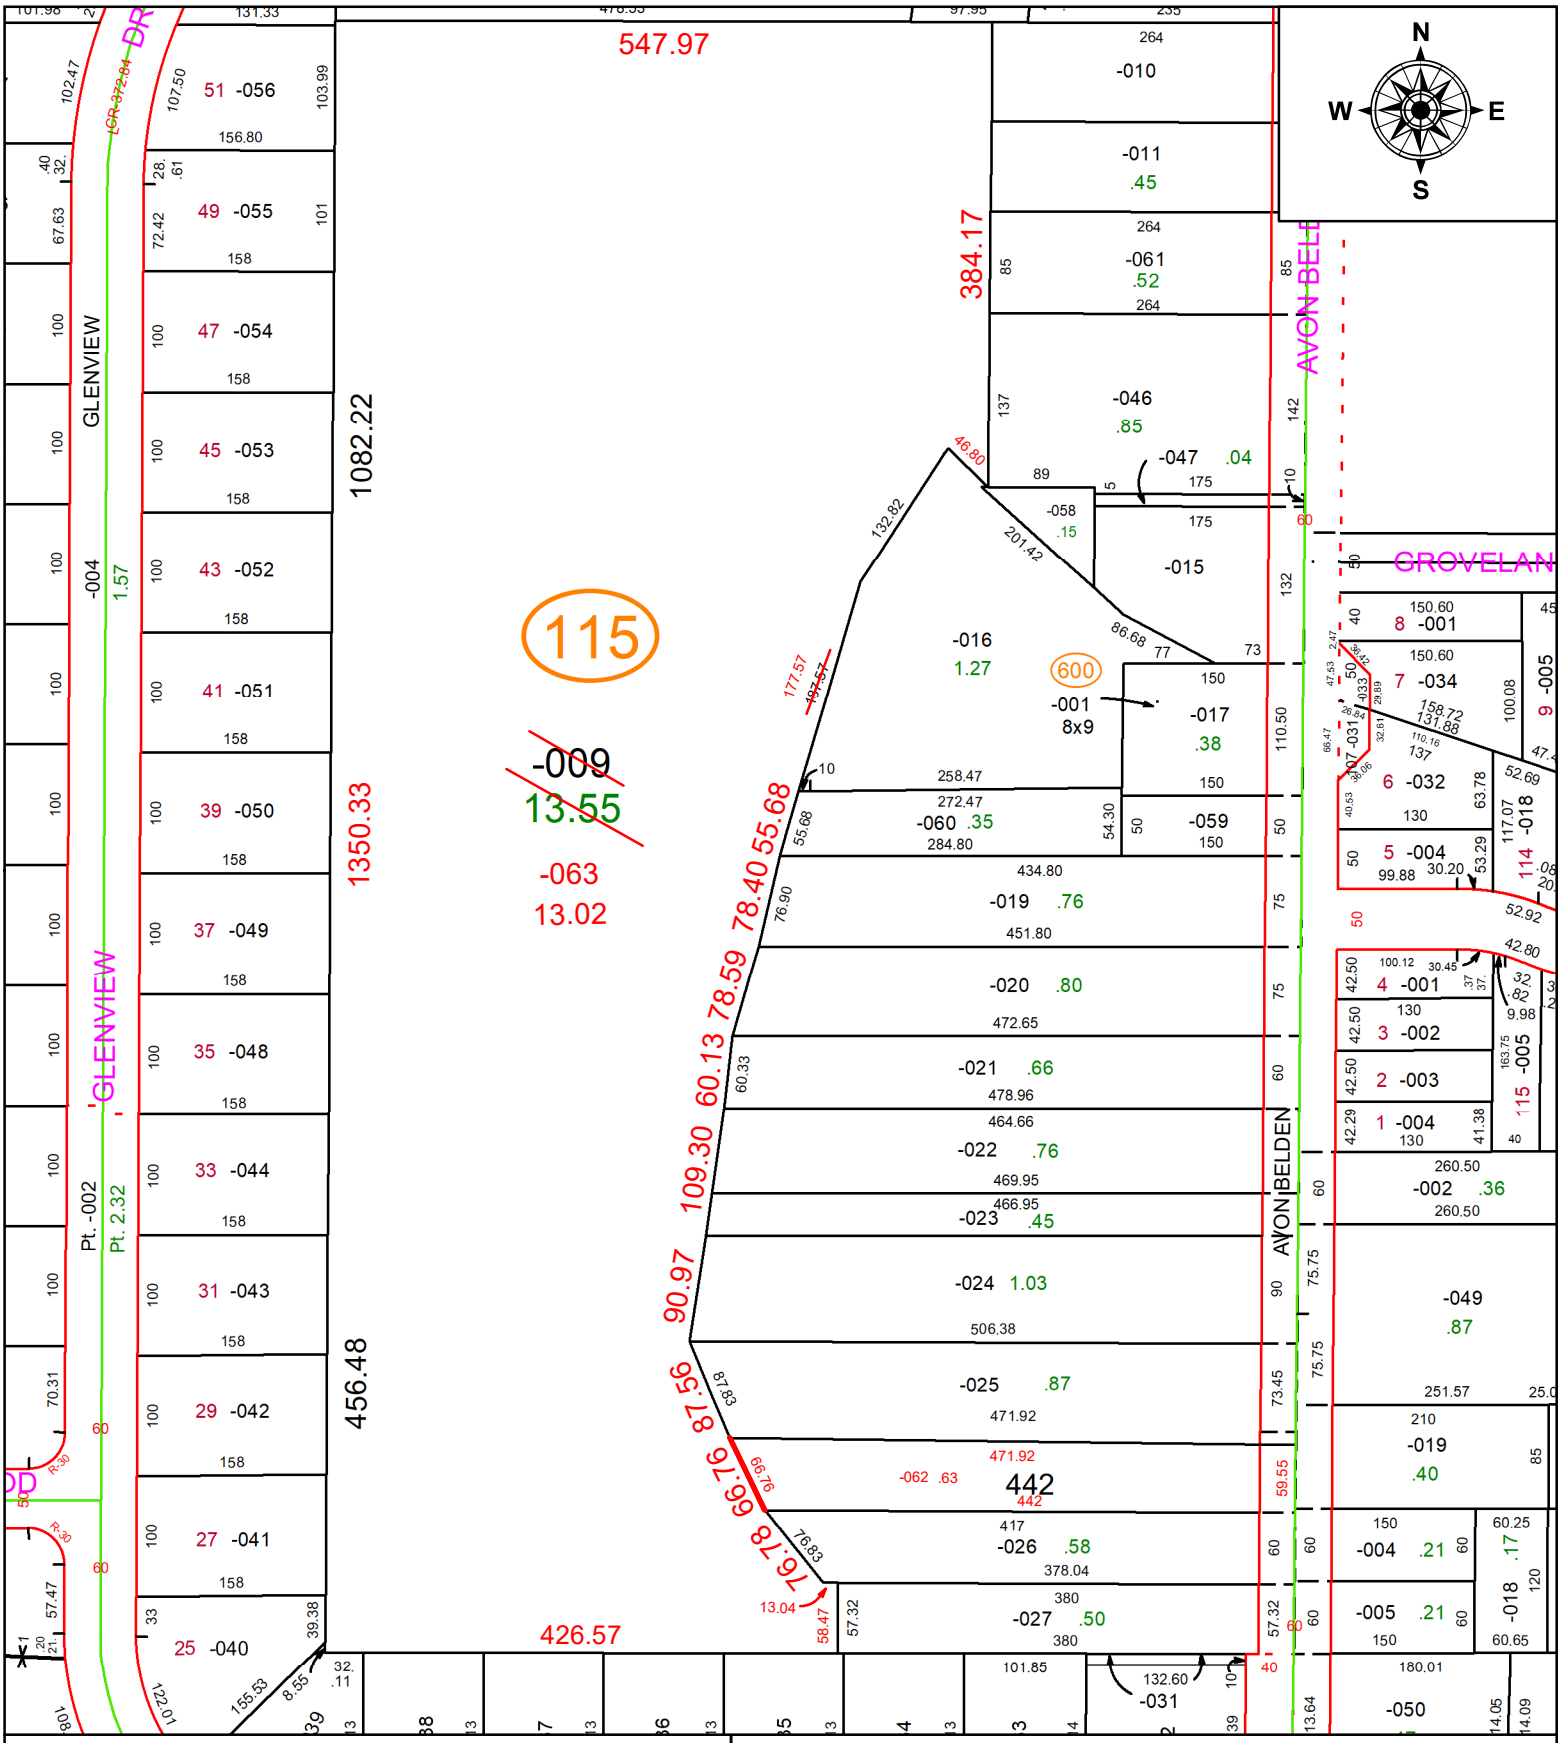

SPLITS/DEEDS PROCESSED

LORAIN COUNTY TAX MAP DEPARTMENT
226 MIDDLE AVE. ELYRIA, OH

SURVEYED BY: LOUIS J. GIFFELS **SURVEY #:** 51360

CLOSURE: 1: 199473

MAP PAGE(S): 04-00-018

APPOVED BY: BB **DATE:** 1/6/2025

SCALE: 1" = 160' **PRIOR INSTRUMENT:** #D.V 577 P. 481