PARENT PARCEL: 11-00-093-101-044 & -081

CHILD PARCEL: AC. CORR. PER PRIOR INSTR. # 2018-0666058

STARTING POINT: N/A

22-04956-A

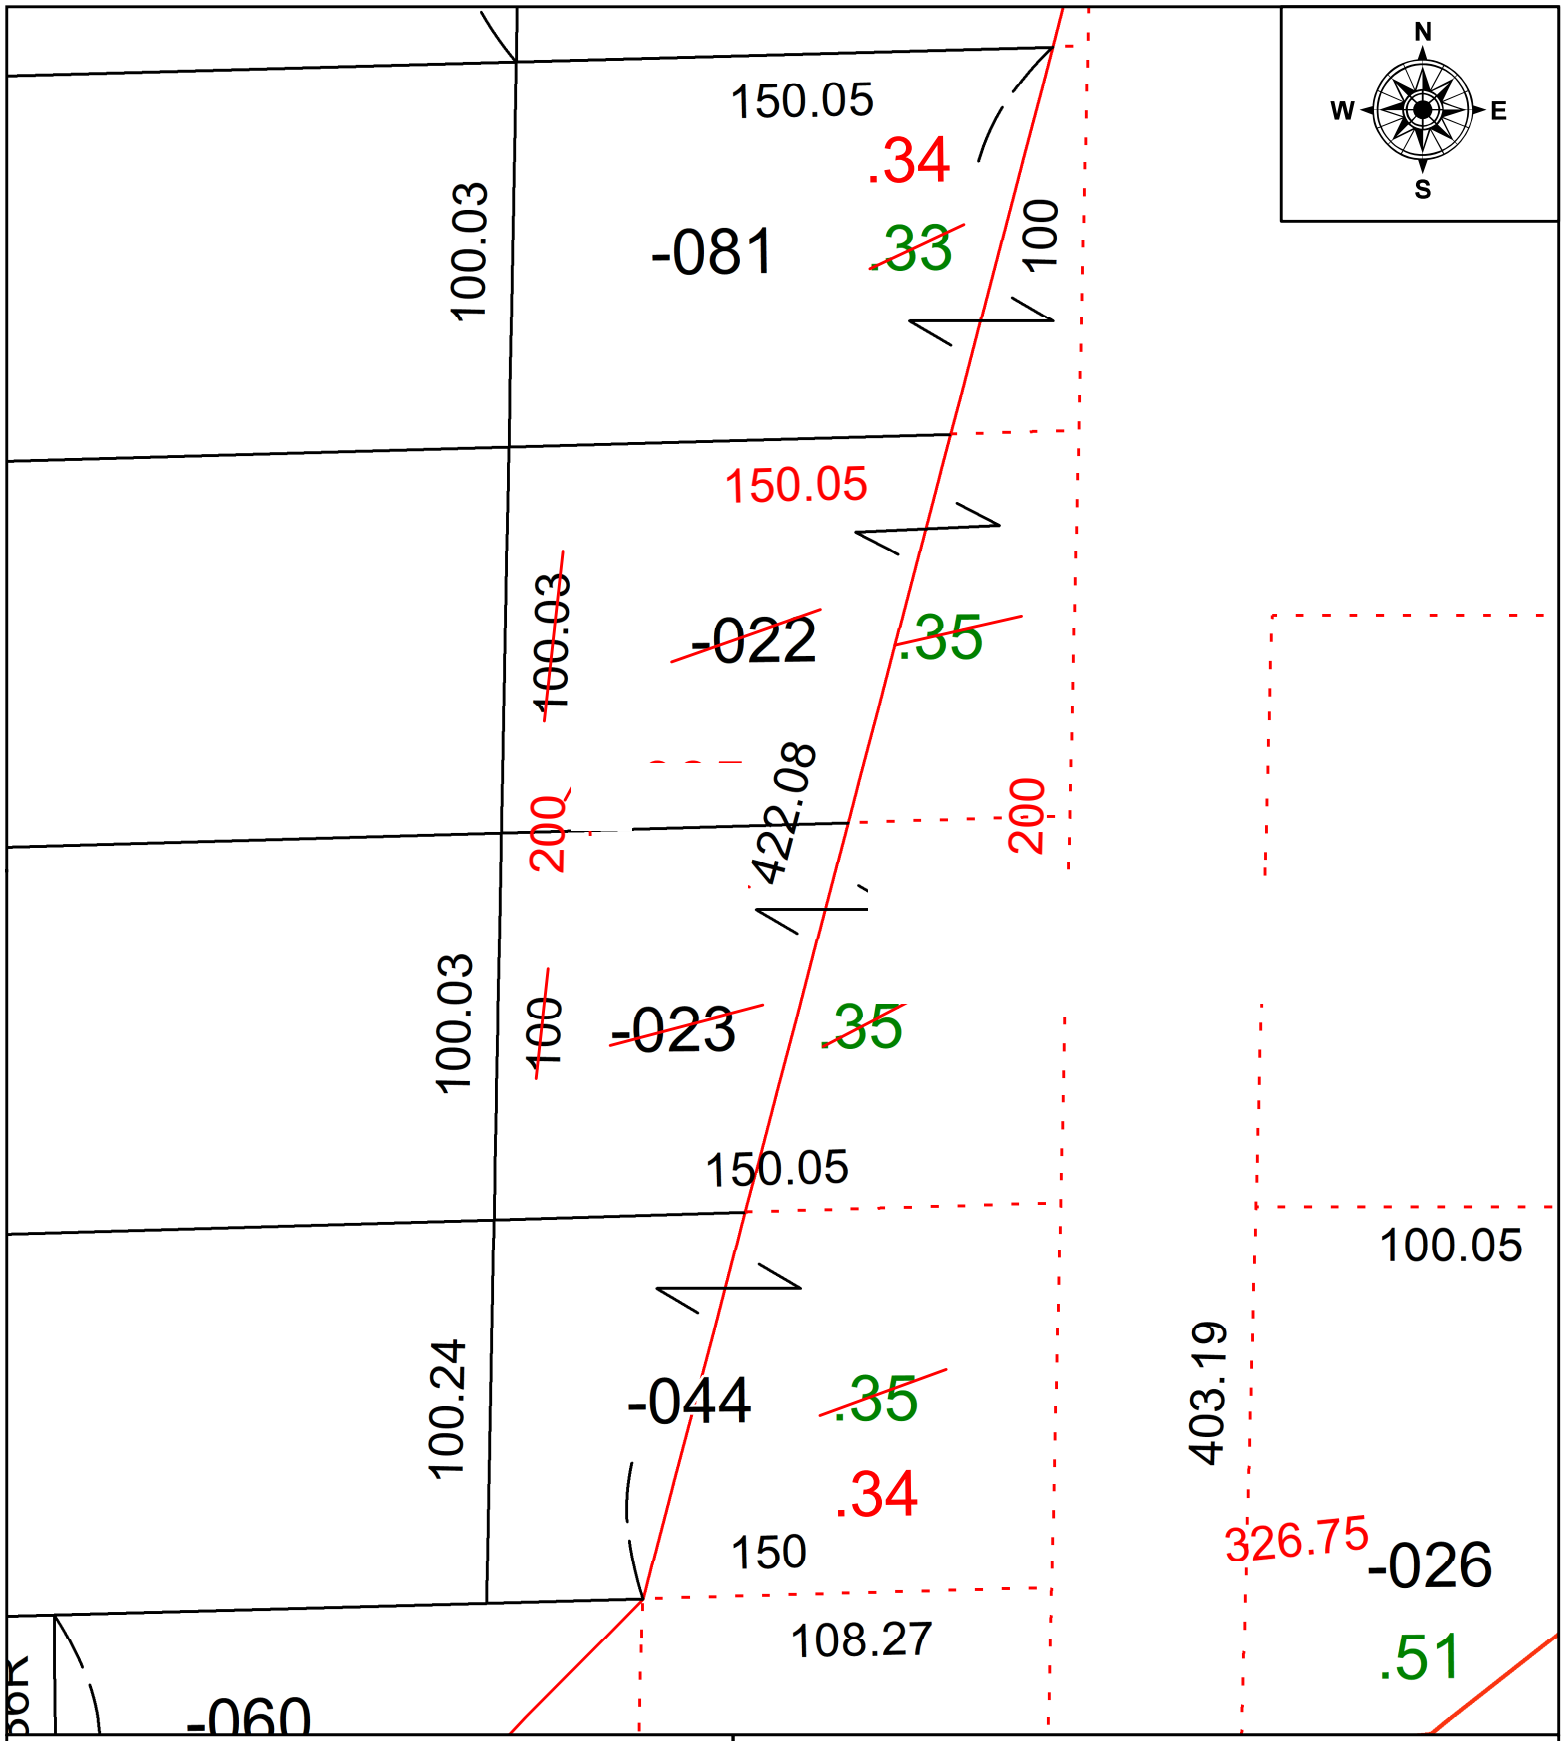

SPLITS/DEEDS PROCESSED

LORAIN COUNTY TAX MAP DEPARTMENT
226 MIDDLE AVE. ELYRIA, OH

SURVEYED BY: N/A **SURVEY #:** N/A

CLOSURE: N/A

MAP PAGE(S): 11-00-093

APPOVED BY: DMA **DATE:** 9/22/2022

SCALE: 1" = 50' **PRIOR INSTRUMENT:** 2018-0666058