PARENT PARCEL: 18-00-039-000-020 & -021 & -006

CHILD PARCEL: 18-00-039-000-034 & -035

STARTING POINT: INTERSECTION OF PITTS RD AND SE CORNER OF LOT 39

25-04959

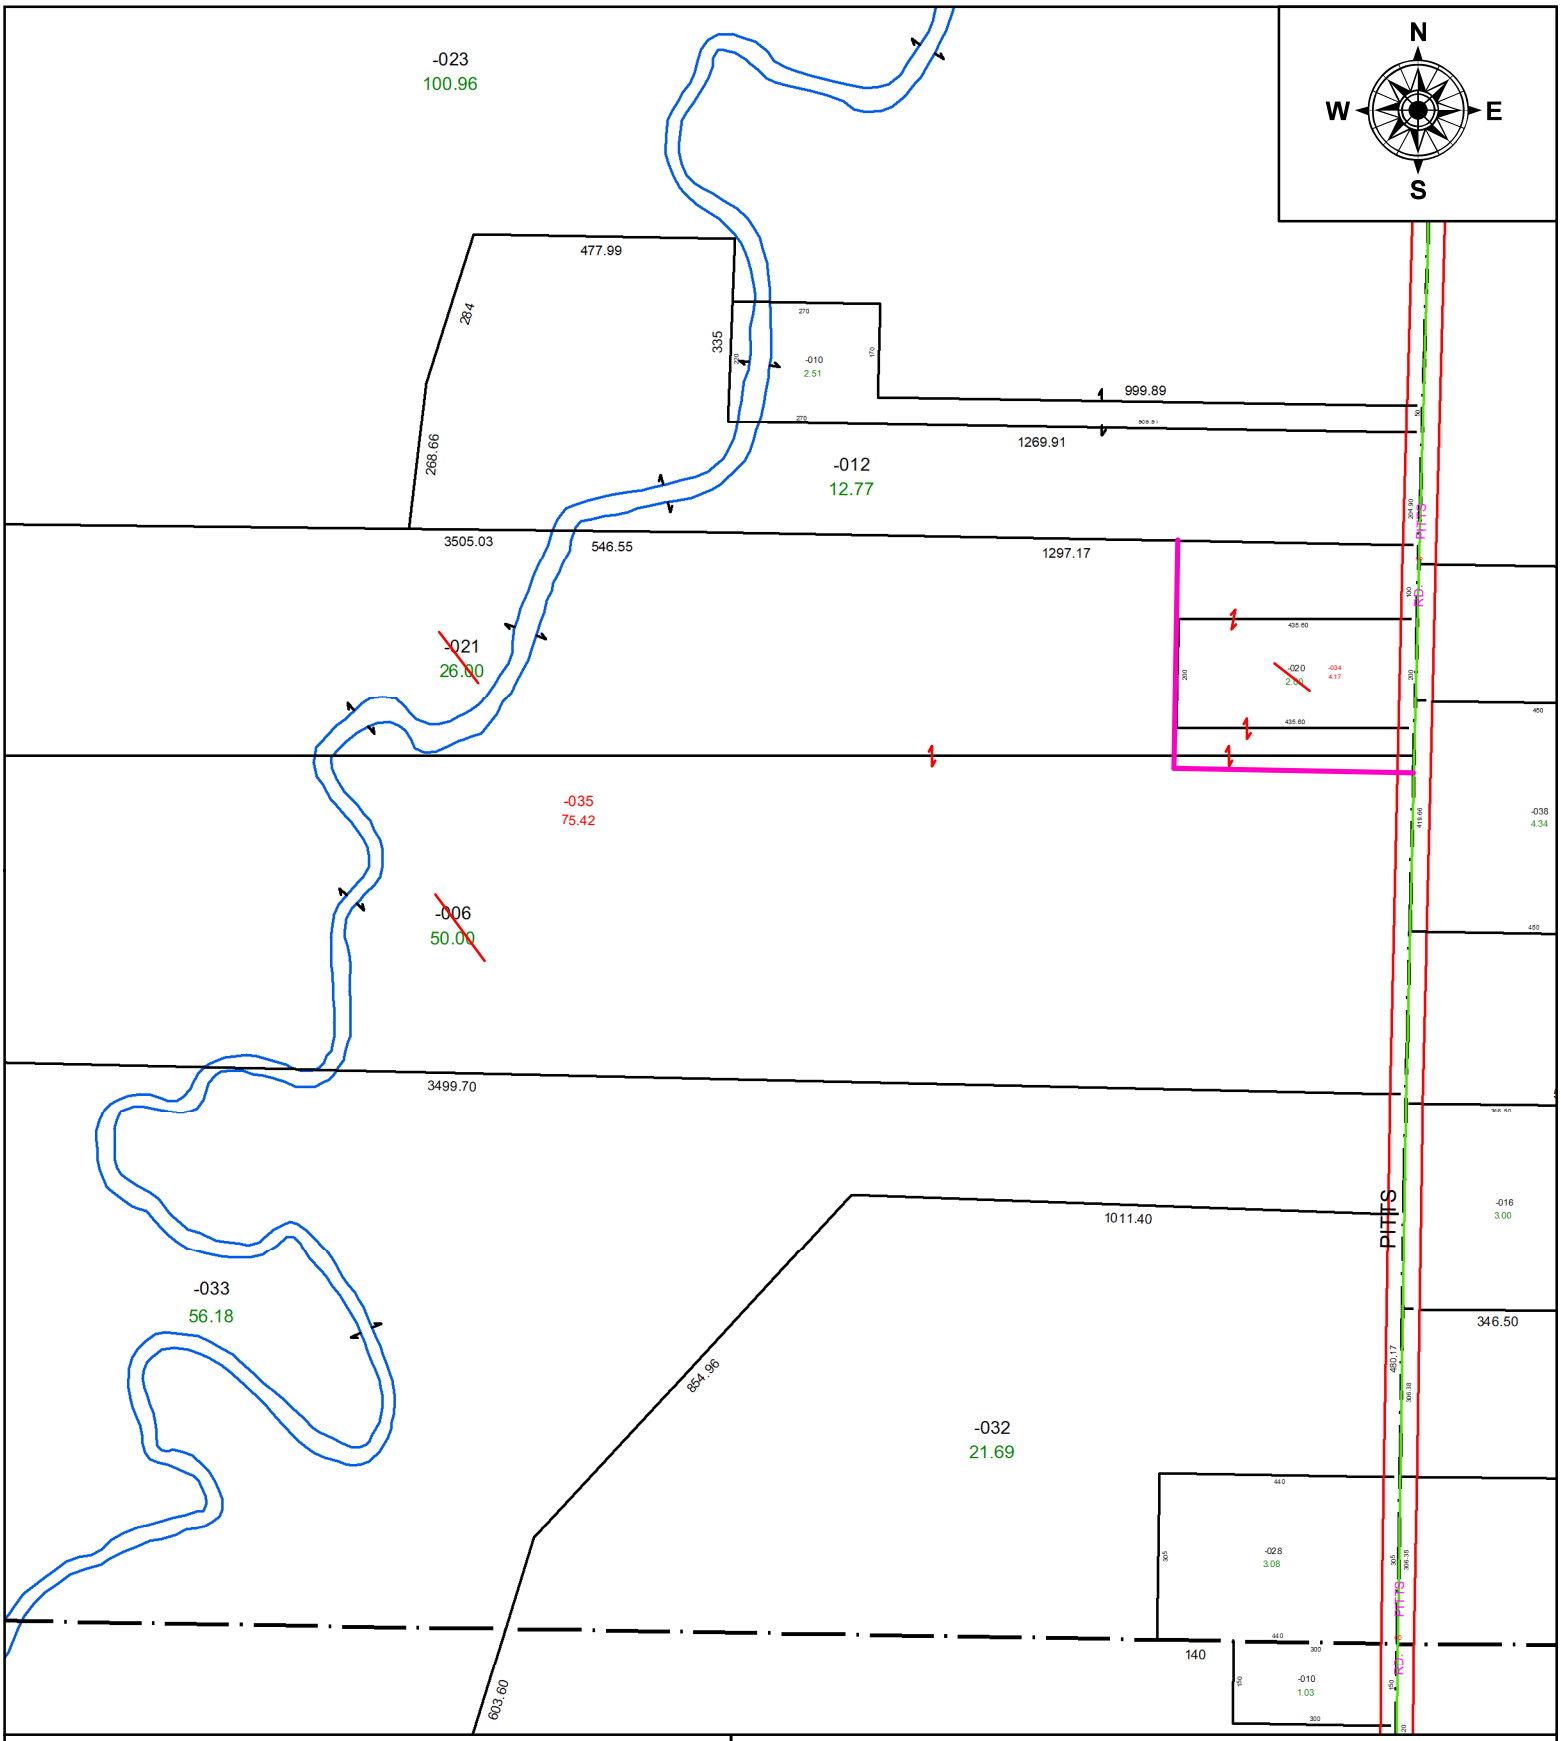

SPLITS/DEEDS PROCESSED

LORAIN COUNTY TAX MAP DEPARTMENT
226 MIDDLE AVE. ELYRIA, OH

SURVEYED BY: THOMAS M. SNEZEK **SURVEY #:** 51371

CLOSURE: 1: 43675

MAP PAGE(S): 18-00-039

APPOVED BY: BB **DATE:** 1/17/2025

SCALE: 1" = 230' **PRIOR INSTRUMENT:** #20110385662