PARENT PARCEL: 04-00-011-104-020

CHILD PARCEL: 04-00-011-104-022, -023, & -024 AC CORR PER SURVEYOR AMY KELLY

STARTING POINT: INTERSECTION OF NORTH LINE OF O.S. 11 & SOUTHWESTERLY CORNER OF JEROME FORTHOFER SUB.

25-04961

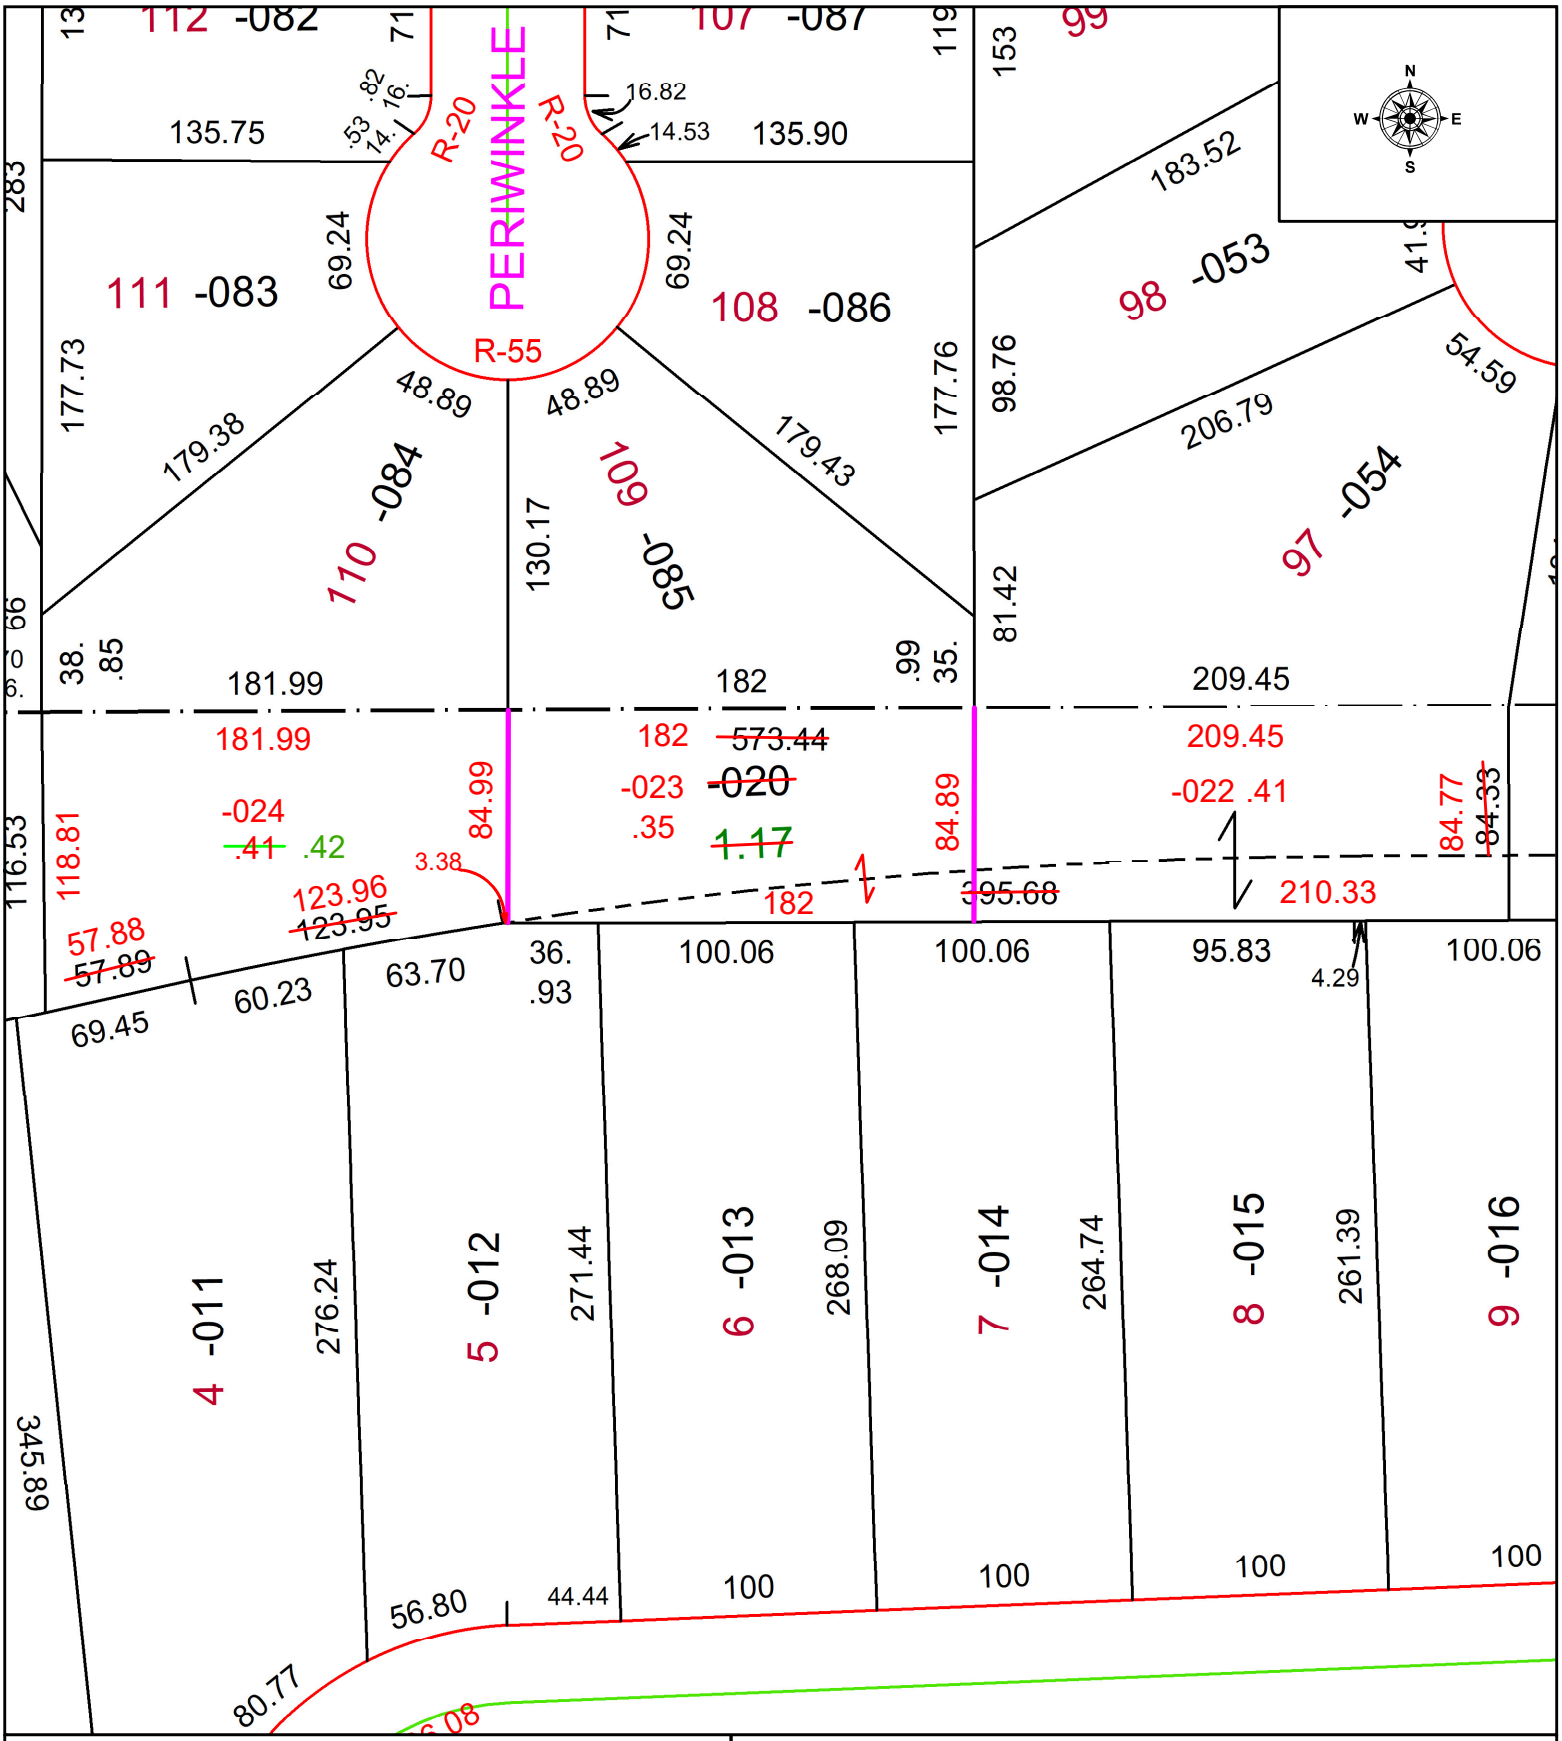

SPLITS/DEEDS PROCESSED

LORAIN COUNTY TAX MAP DEPARTMENT
226 MIDDLE AVE. ELYRIA, OH

SURVEYED BY: AMY KELLY SURVEY # 51372
CLOSURE: 1: 165707
MAP PAGE(S): 04-00-011
APPOVED BY: WRZ **DATE:** 1/17/2025
SCALE: 1" = 75 **PRIOR INSTRUMENT:** #2008-0248789