PARENT PARCEL: 10-00-004-132-011, -012, -024, -028, -032, -038

CHILD PARCEL: 10-00-004-132-039, AC CORR PER SURVEYOR FOR -038 ONLY

STARTING POINT: INTERSECTION FULLER RD AND EAST RIVER RD

25-04965

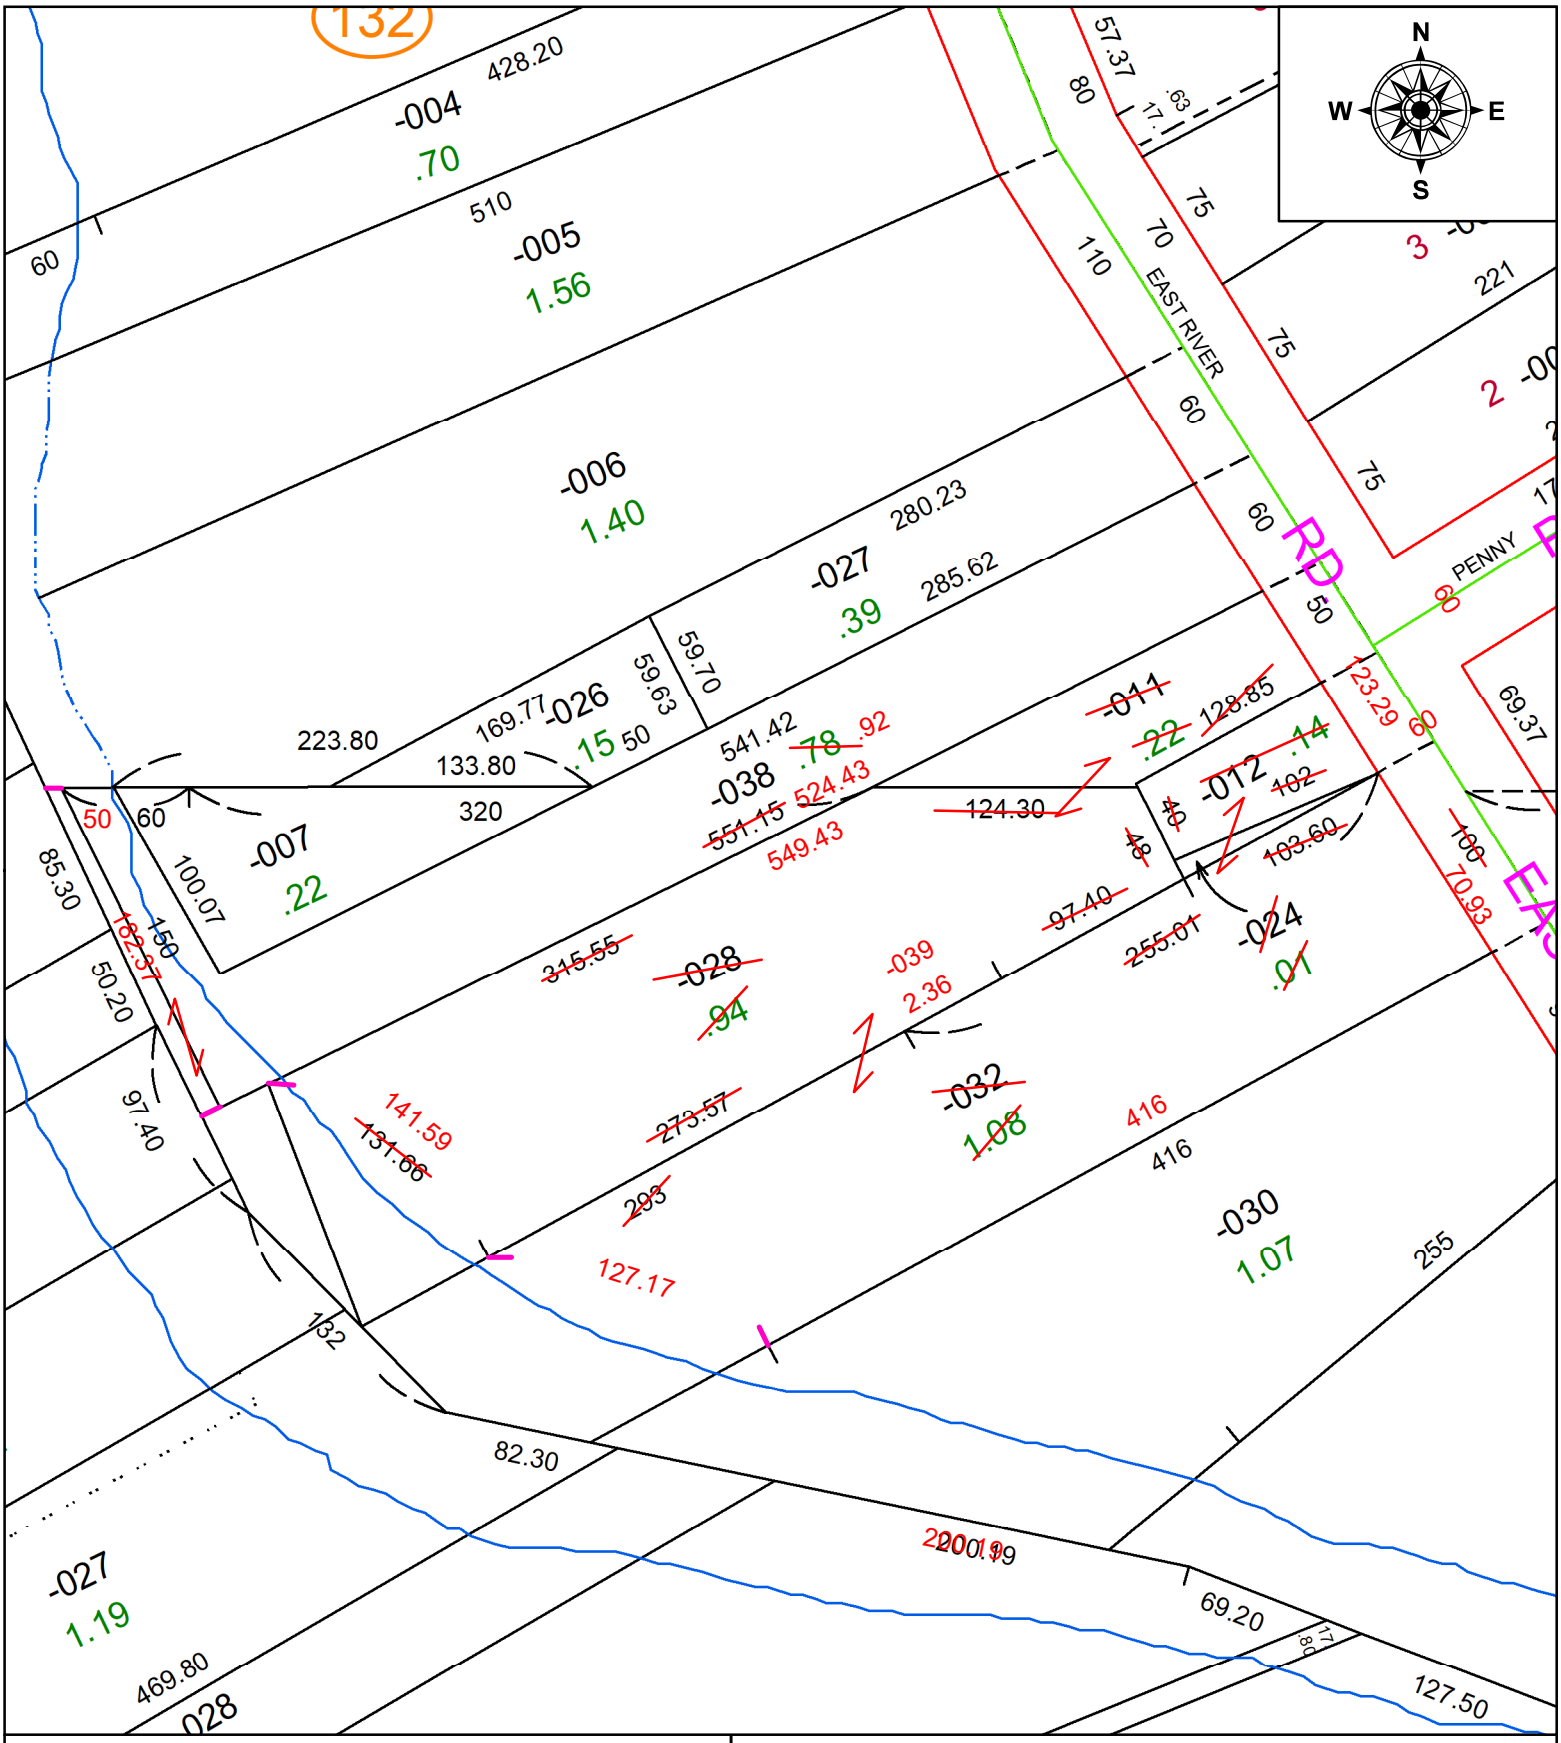

SPLITS/DEEDS PROCESSED

LORAIN COUNTY TAX MAP DEPARTMENT
226 MIDDLE AVE. ELYRIA, OH

SURVEYED BY: THOMAS A. SIMON **SURVEY #:** 51376
CLOSURE: 1: 279539
MAP PAGE(S): 10-00-004
APPOVED BY: BB **DATE:** 1/23/2025
SCALE: 1" = 90' **PRIOR INSTRUMENT:** #20240004870