PARENT PARCEL: 13-09-039-000-005 & 13-09-040-000-021

CHILD PARCEL: 13-09-039-000-005 & 13-09-040-000-022

STARTING POINT: C/L S BETTS RD AND SR 511 **AC CORR PER SURV BY WILLIAM R. WALLACE**

22-04972-A

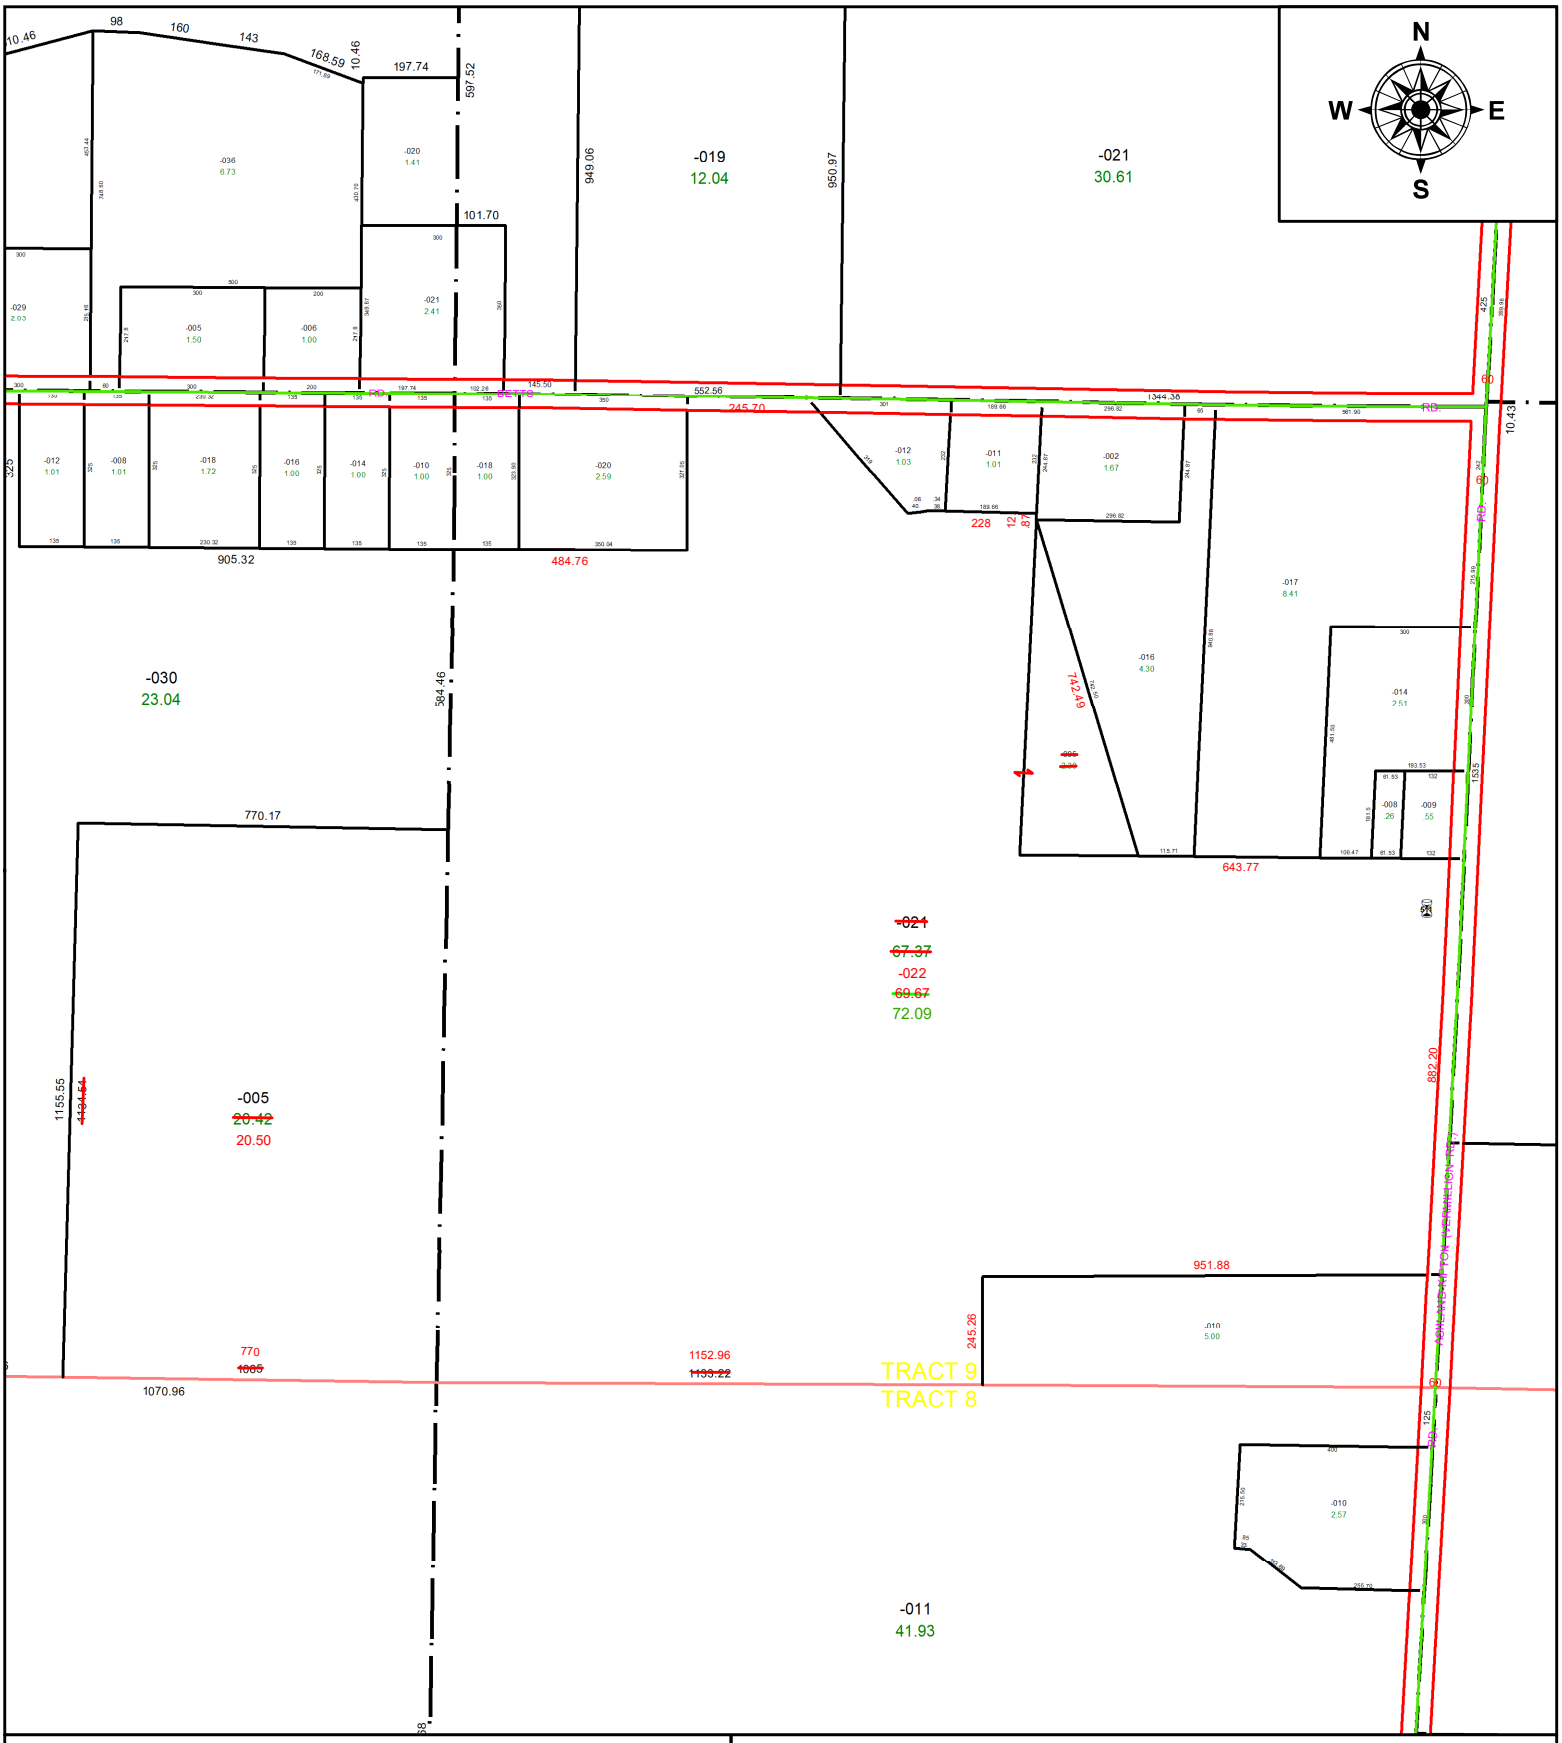

SPLITS/DEEDS PROCESSED

LORAIN COUNTY TAX MAP DEPARTMENT
226 MIDDLE AVE. ELYRIA, OH

SURVEYED BY: WILLIAM R. WALLACE **SURV # 50729**

CLOSURE: 1: 3894259

MAP PAGE(S): 13-09-039

APPOVED BY: AC **DATE:** October 31, 2022

SCALE: 1 in = 400 ft **PRIOR INSTRUMENT:** 2017- 0623557