PARENT PARCEL: 20-05-023-105-017

CHILD PARCEL: MAP CORRECTION PER SURVEY THOMAS SIMON

STARTING POINT: S.E. CORNER OF S/L 22 GILMORE, BARNS & BANNIN SUB.

22-04973-C

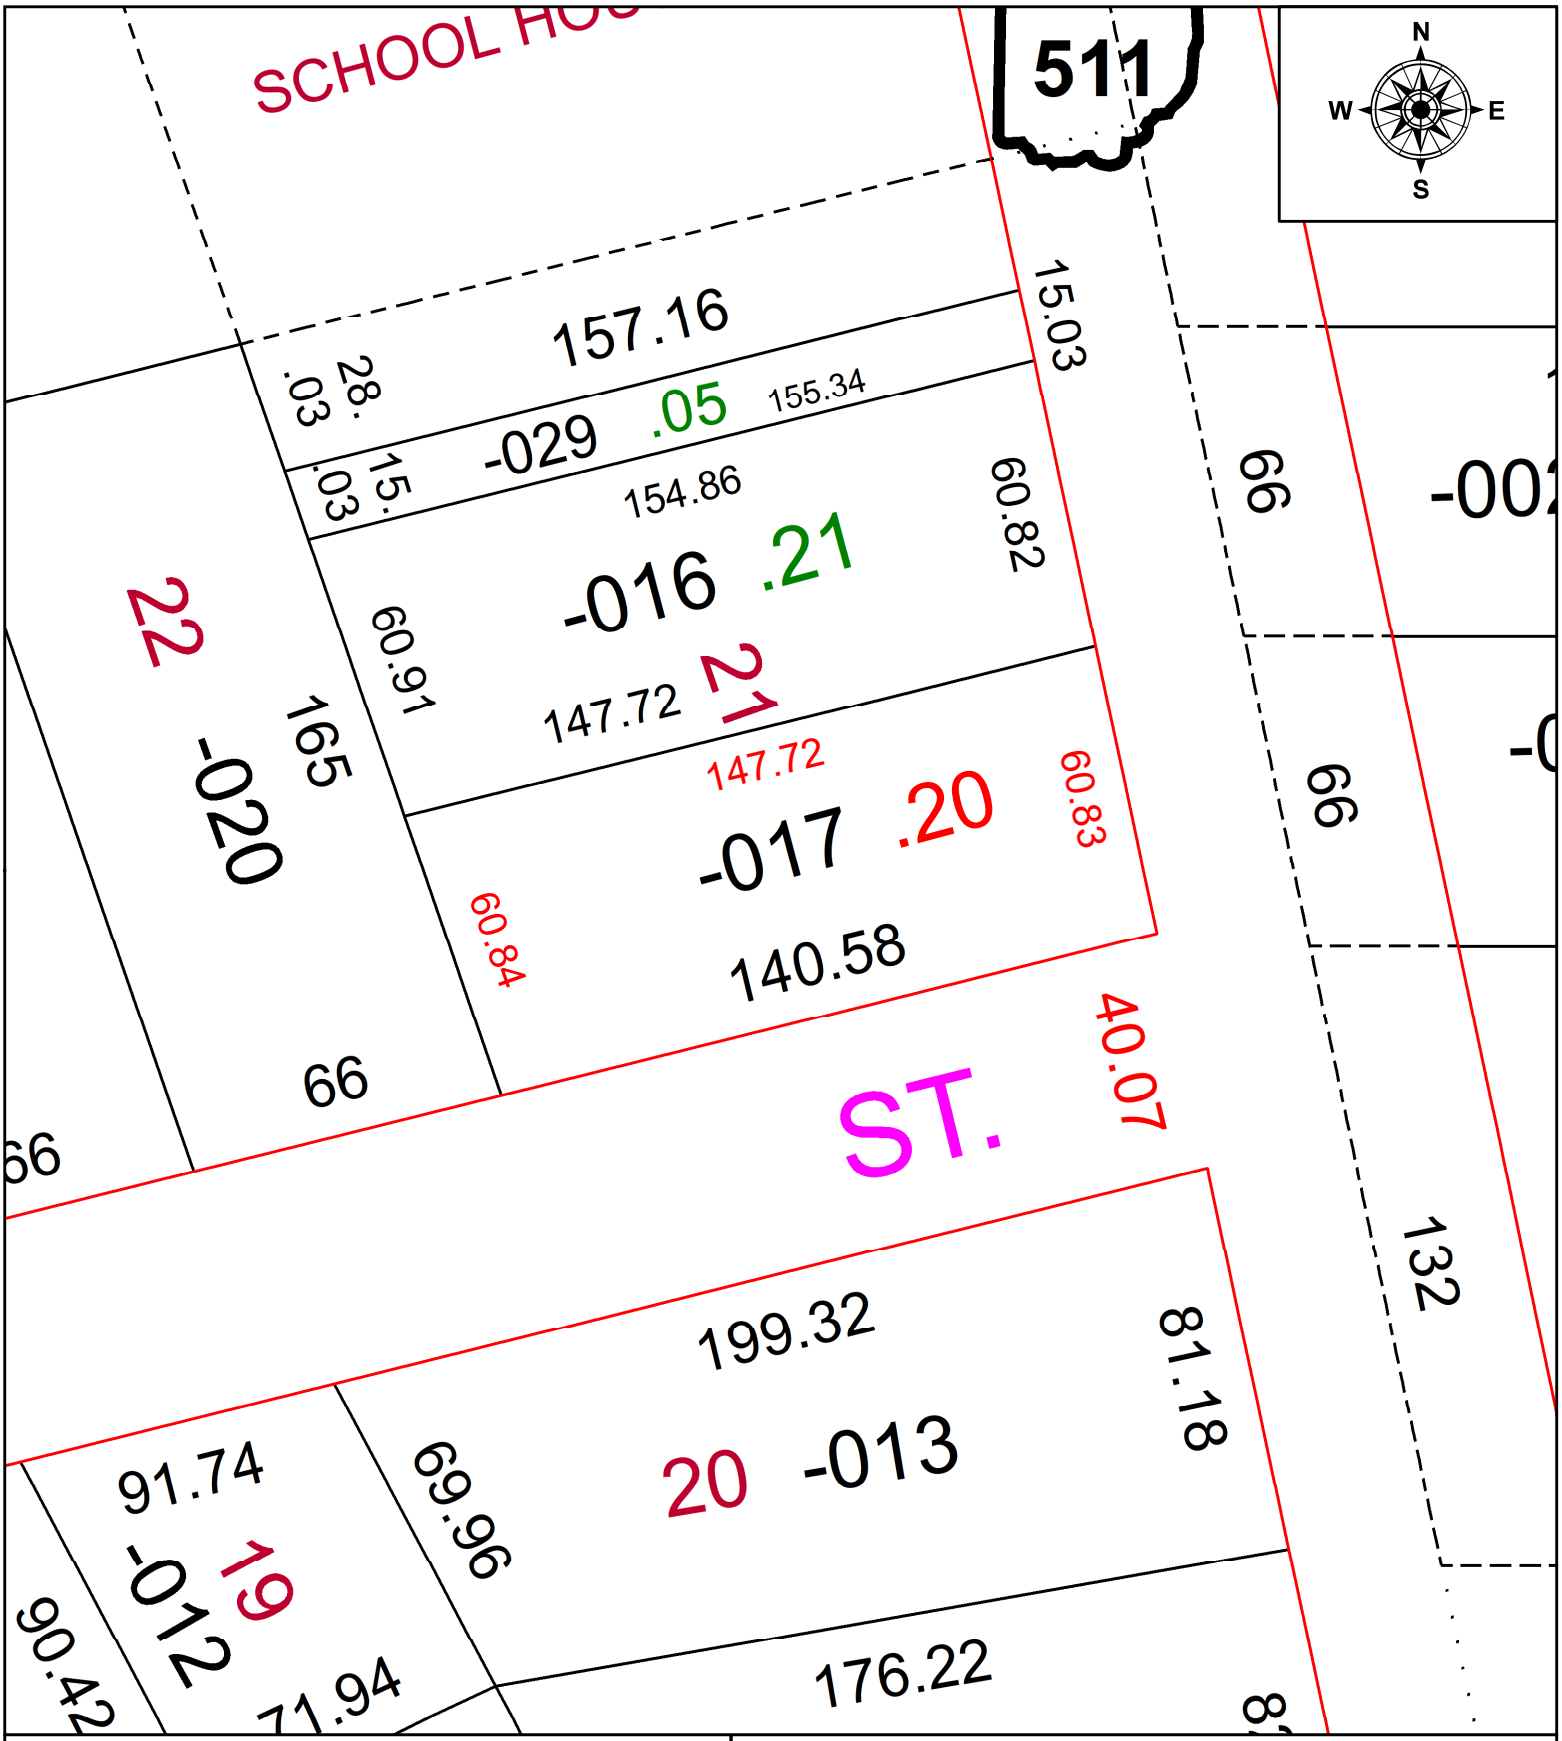

SPLITS/DEEDS PROCESSED

LORAIN COUNTY TAX MAP DEPARTMENT
226 MIDDLE AVE. ELYRIA, OH

SURVEYED BY: THOMAS SIMON **SURVEY #:** 50731

CLOSURE: 1:105063

MAP PAGE(S): 20-05-023

APPOVED BY: DMA **DATE:** 11/1/2022

SCALE: 1" = 40' **PRIOR INSTRUMENT:** 2022-0880377