PARENT PARCEL: 20-05-003-000-022 & -023

CHILD PARCEL: 20-05-003-000-024, -025, & -026

STARTING POINT: C/L OF BURSLEY RD AND QUARRY RD

25-04975

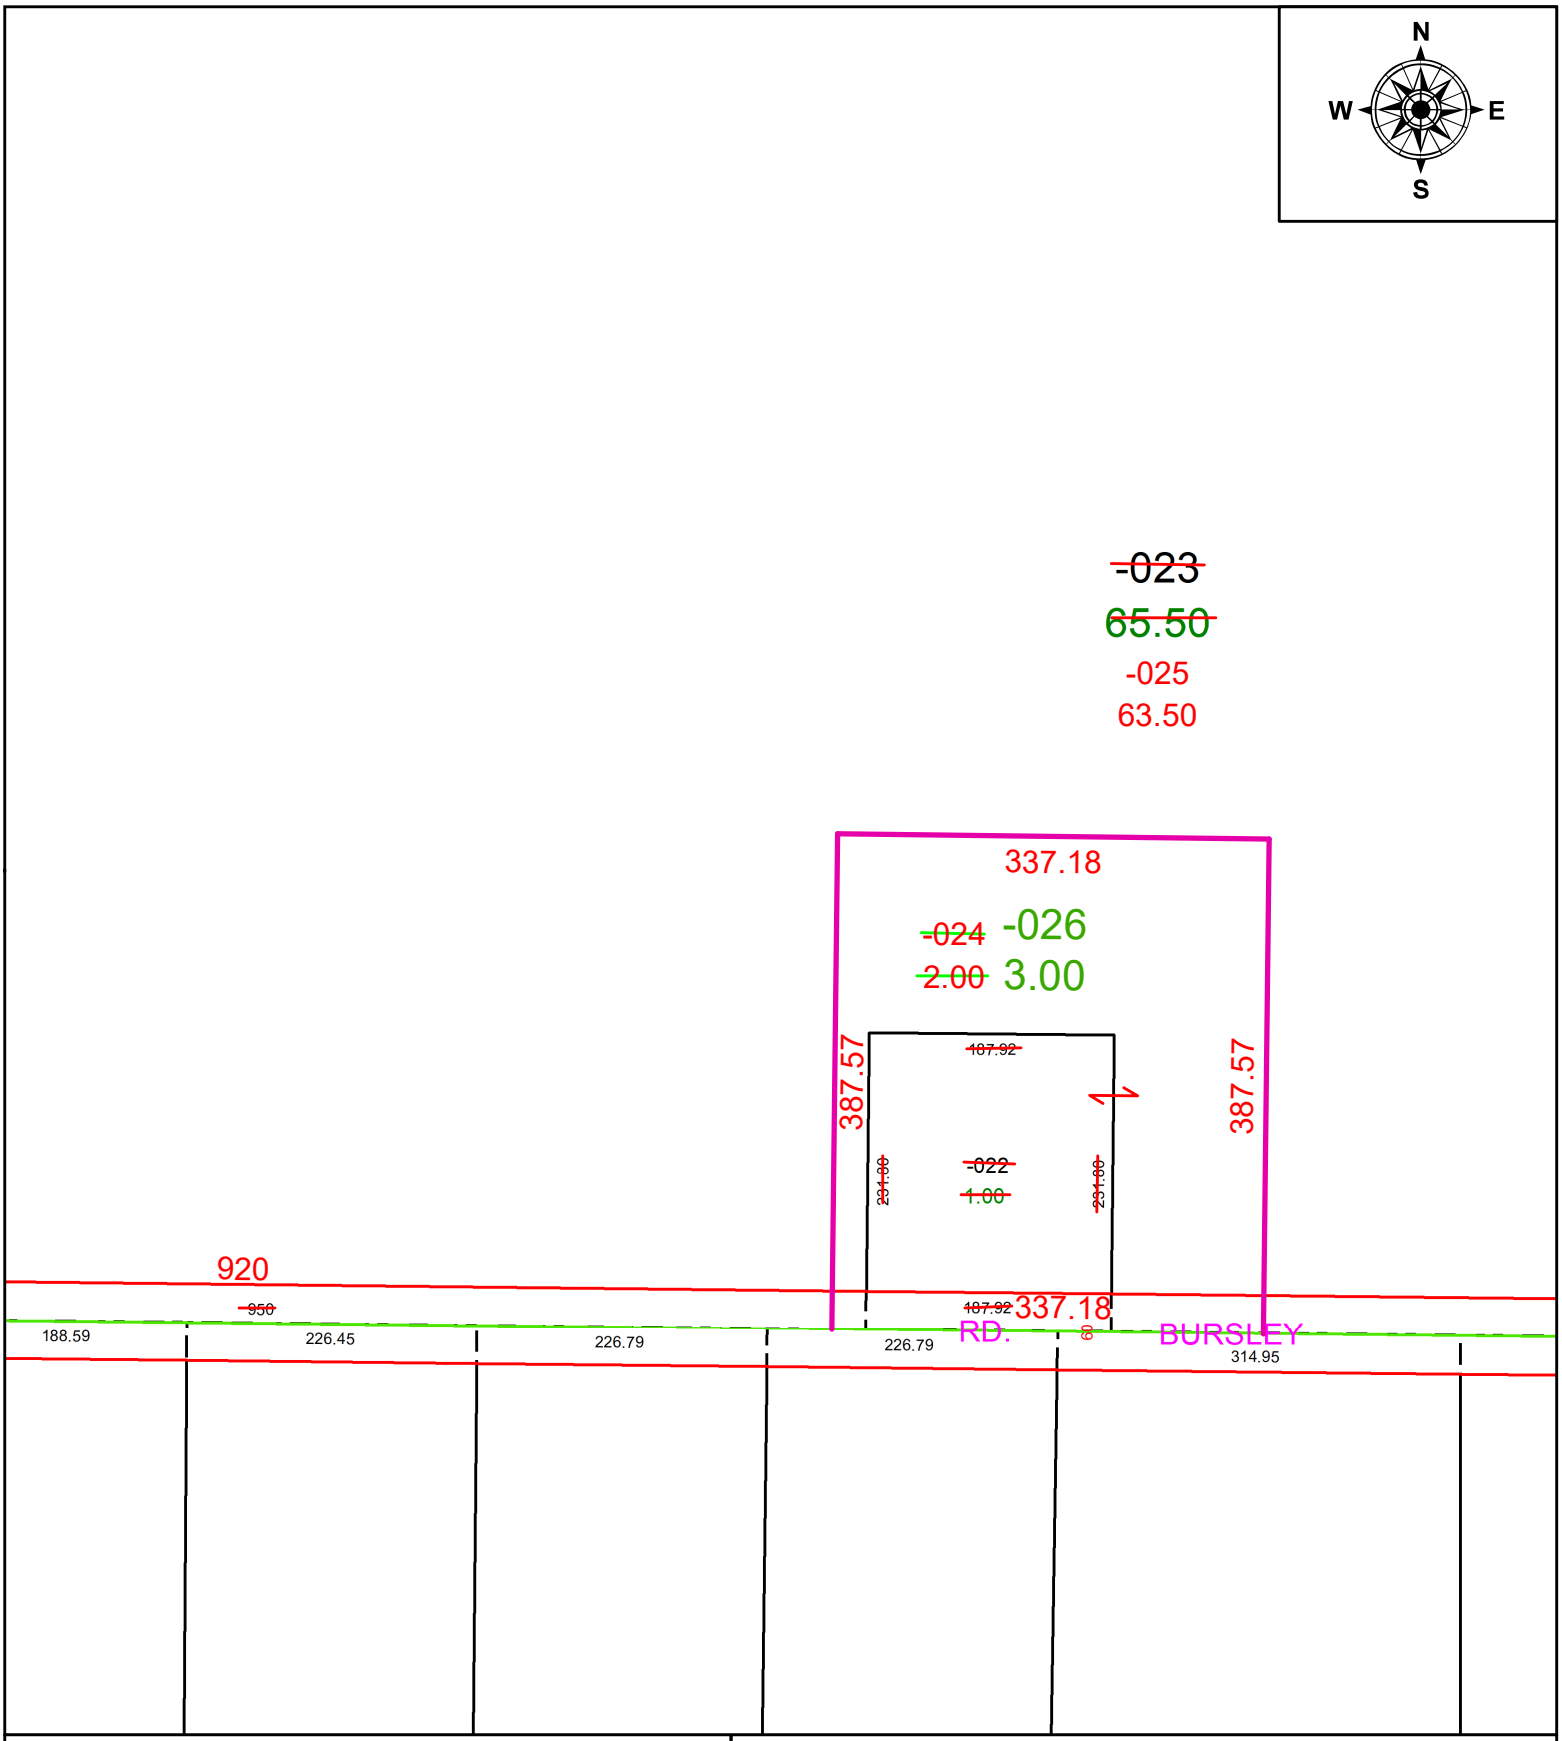

SPLITS/DEEDS PROCESSED

LORAIN COUNTY TAX MAP DEPARTMENT
226 MIDDLE AVE. ELYRIA, OH

SURVEYED BY: JAMES ALLEN COTTRELL **SURV # 51391**

CLOSURE: 1: INF

MAP PAGE(S): 20-05-003

APPOVED BY: AC **DATE:** February 13, 2025

SCALE: 1 in = 150 ft **PRIOR INSTRUMENT:** 2010- 0342228