PARENT PARCEL: 04-00-014-105-061 & -070 & -071

CHILD PARCEL: -076 & -077 & -078

STARTING POINT: INTERSECTION CREEKVIEW LN AND KINZEL RD

25-04980

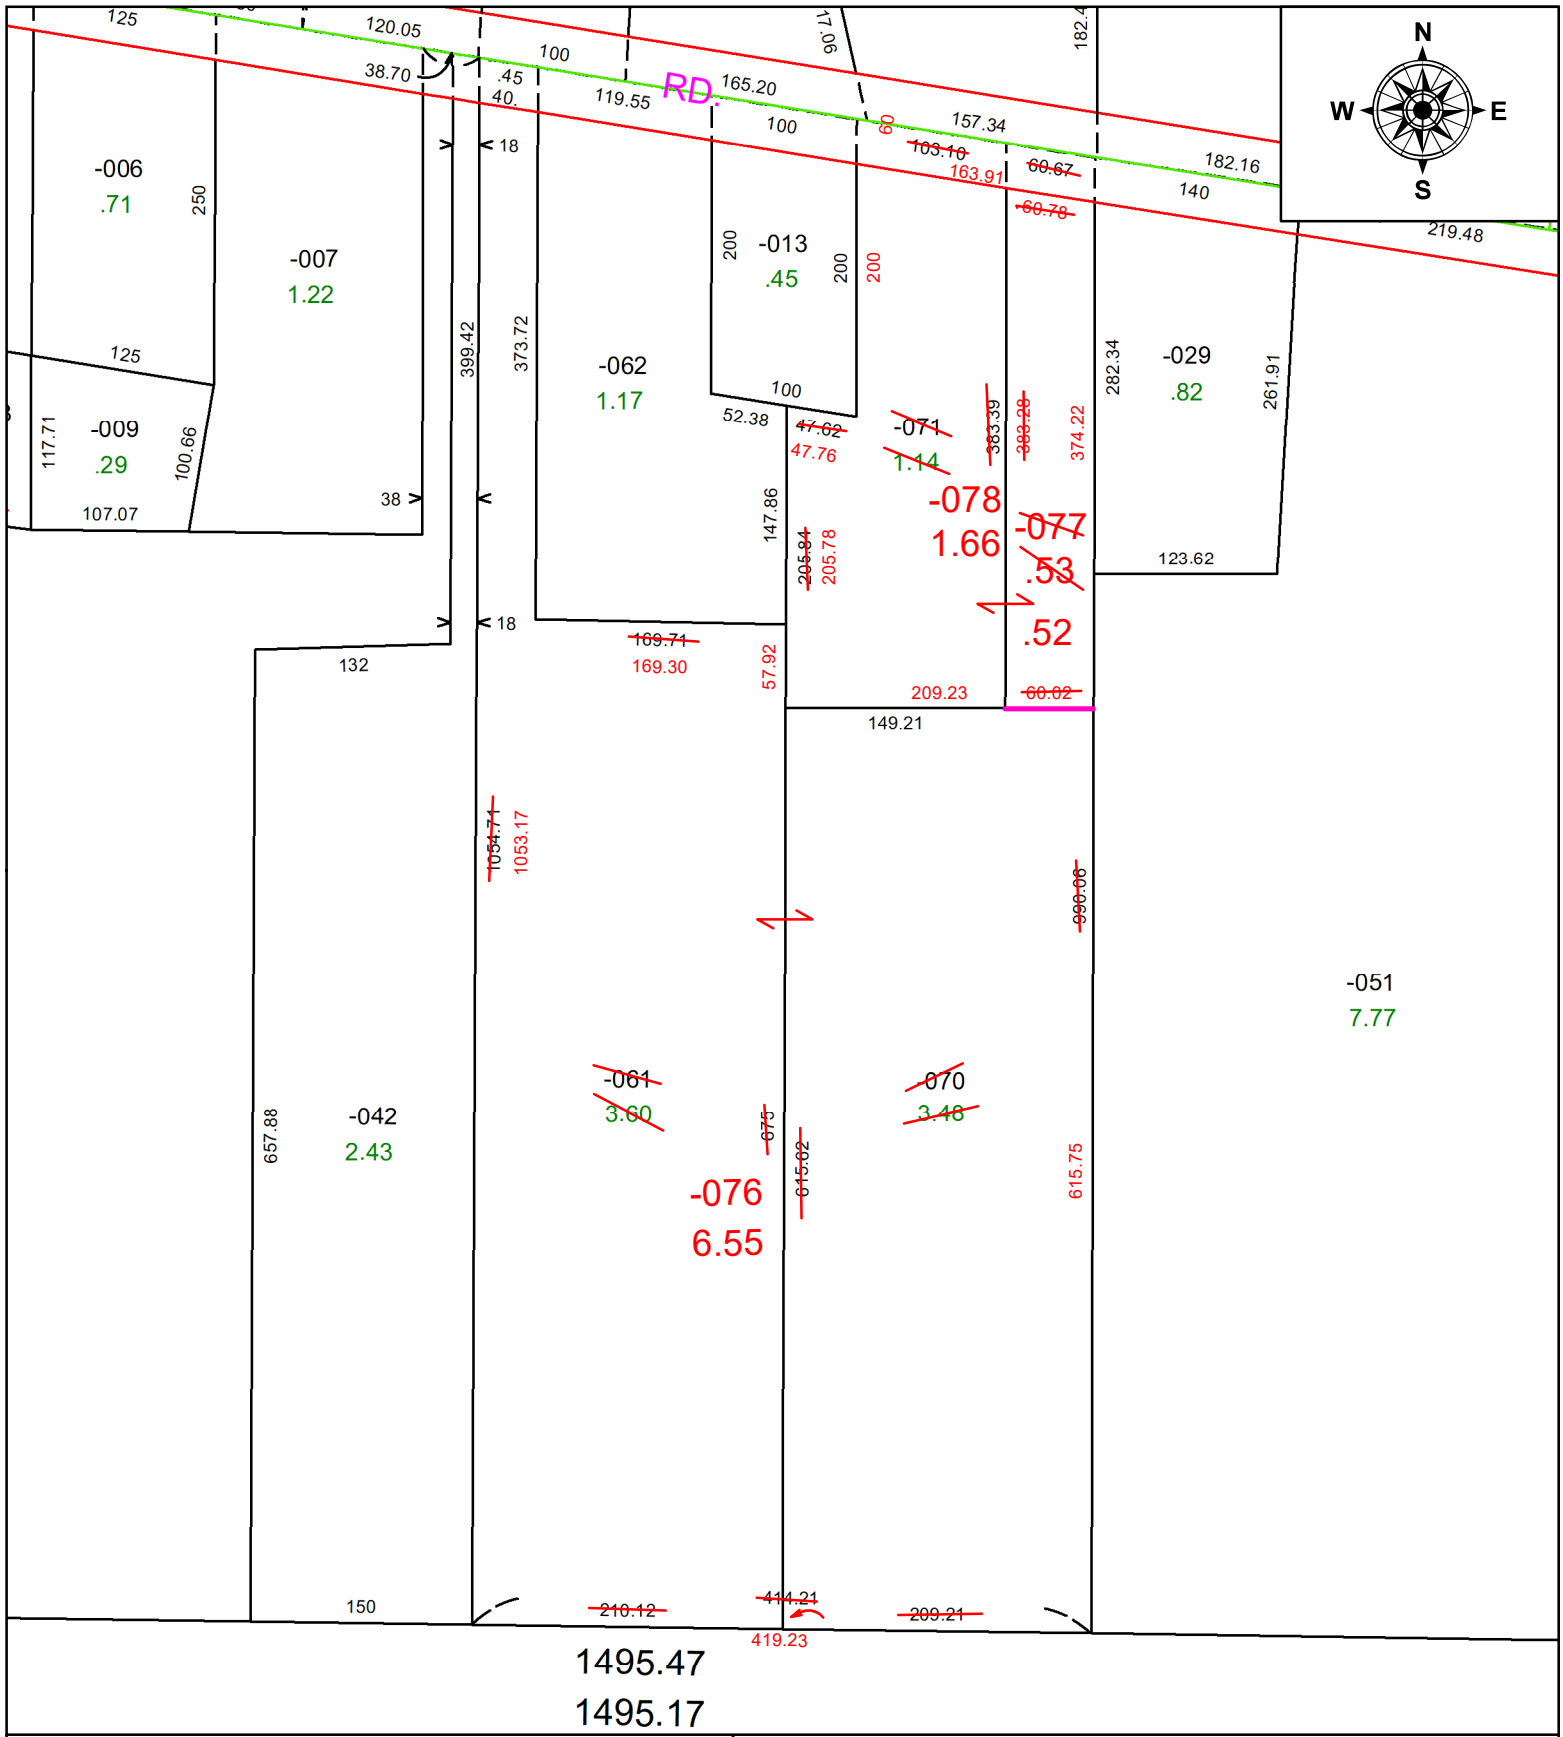

SPLITS/DEEDS PROCESSED

LORAIN COUNTY TAX MAP DEPARTMENT
226 MIDDLE AVE. ELYRIA, OH

SURVEYED BY: MICHAEL P. SPELLACY **SURVEY #:** 51396
CLOSURE: 1: 82776
MAP PAGE(S): 04-00-014
APPOVED BY: BB **DATE:** 2/20/2025
SCALE: 1" = 130' **PRIOR INSTRUMENT:** #19860222442