PARENT PARCEL: 07-00-014-103-003 & -128

CHILD PARCEL: 07-00-014-103-332

STARTING POINT: AC CORR PER SURV BY THOMAS A. SIMON

25-04982

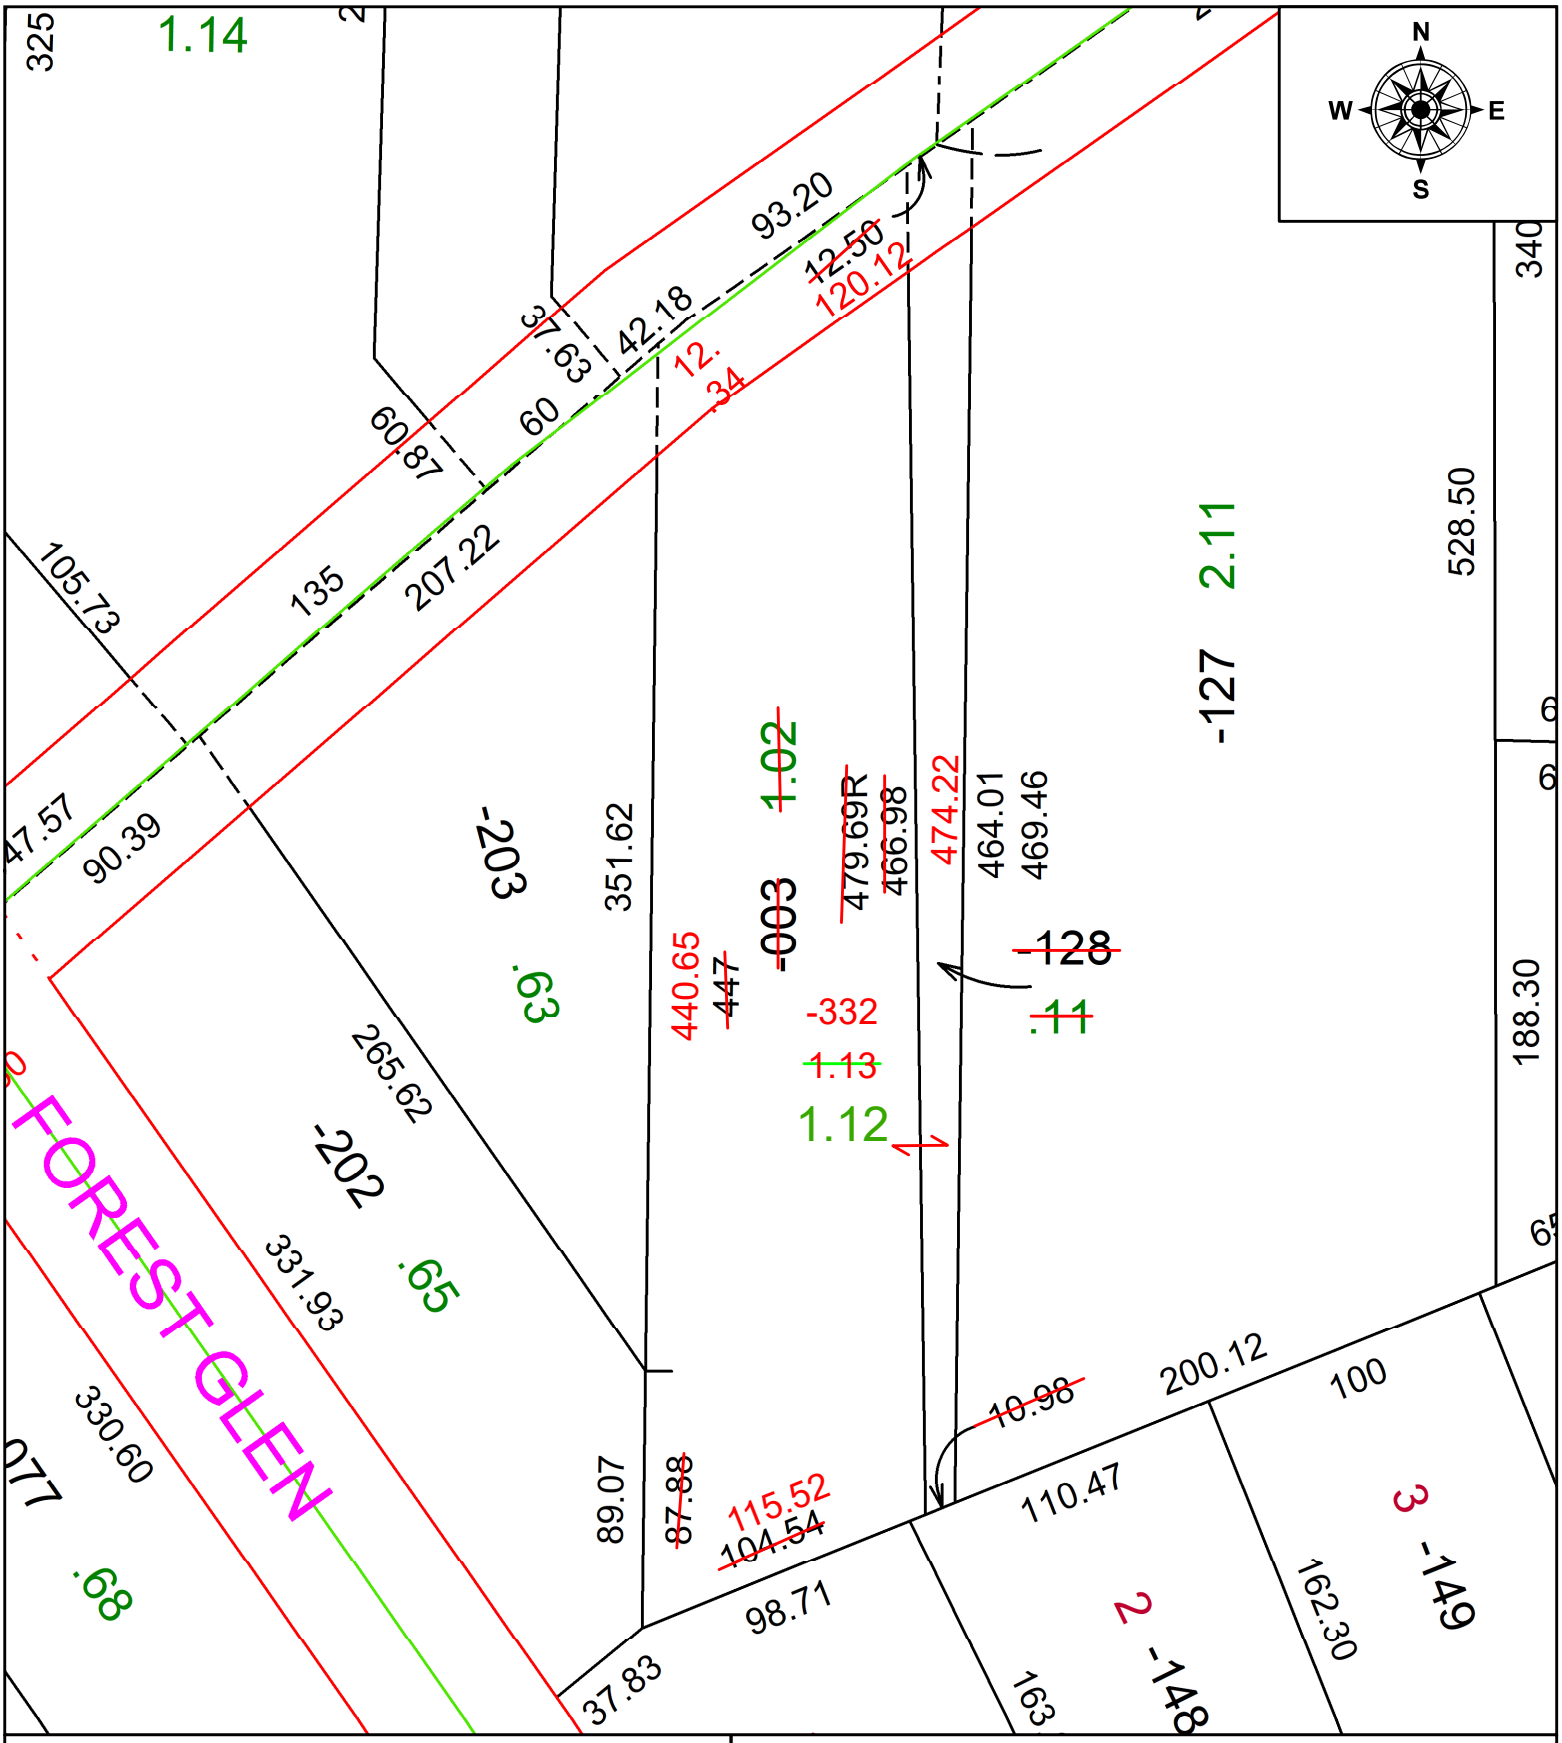

SPLITS/DEEDS PROCESSED

LORAIN COUNTY TAX MAP DEPARTMENT
226 MIDDLE AVE. ELYRIA, OH

SURVEYED BY: THOMAS A. SIMON **SURV # 51398**

CLOSURE: 1: 76014

MAP PAGE(S): 07-00-014

APPOVED BY: AC **DATE:** February 24, 2025

SCALE: 1 in = 66 ft **PRIOR INSTRUMENT:** VOL 227 PG 410