PARENT PARCEL: 04-00-007-101-001 THRU -007

CHILD PARCEL: 04-00-007-101-058

STARTING POINT: AC CORR PER SURV BY GEORGE A. HOFMANN

25-04984

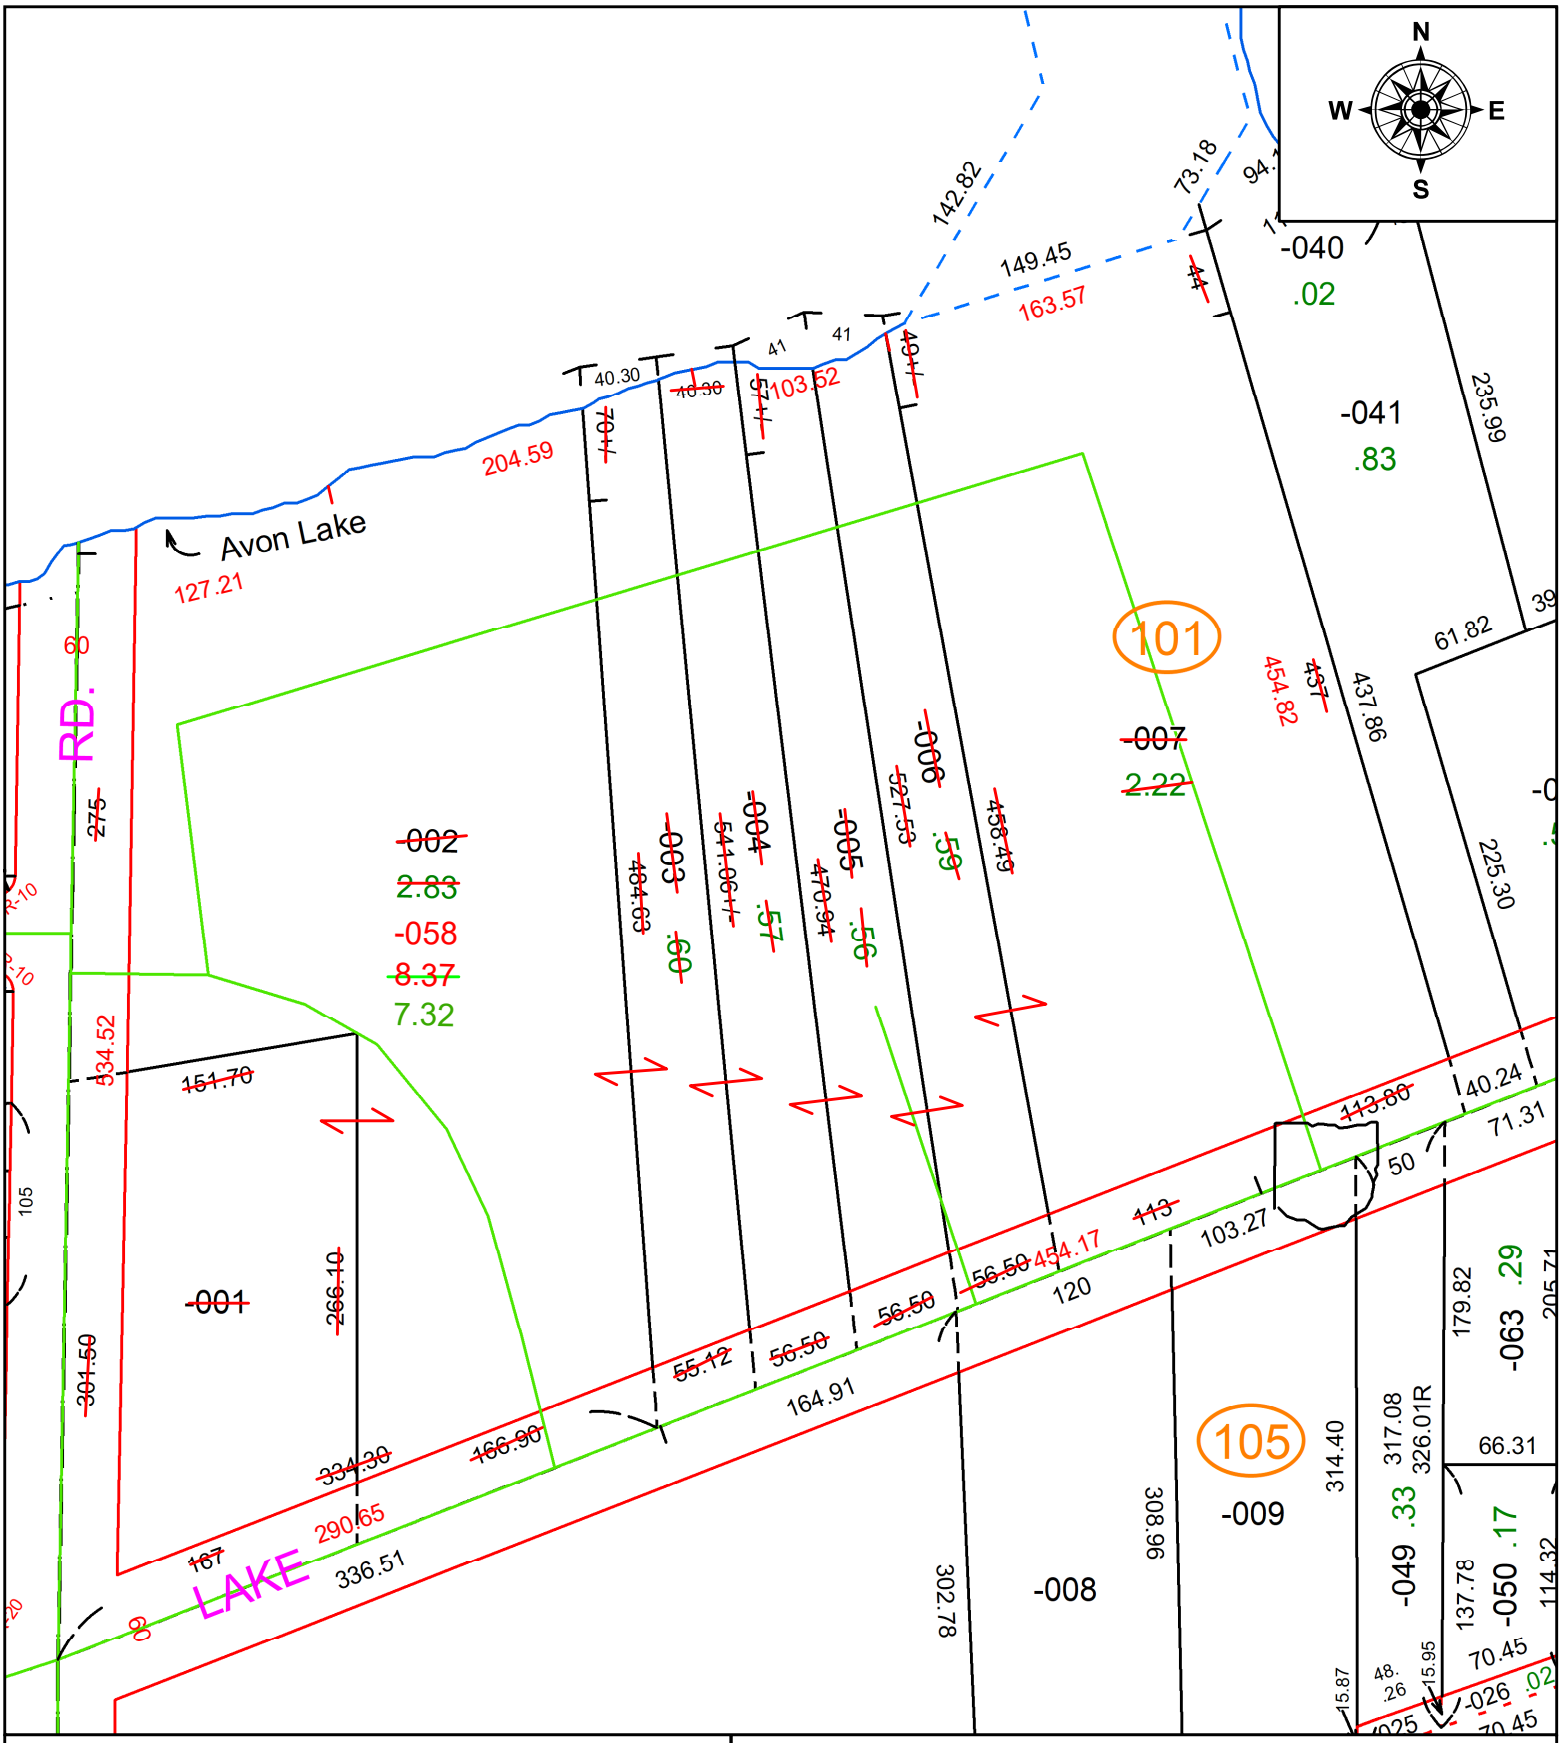

SPLITS/DEEDS PROCESSED

LORAIN COUNTY TAX MAP DEPARTMENT
226 MIDDLE AVE. ELYRIA, OH

SURVEYED BY: GEORGE A. HOFMANN **SURV # 51402**

CLOSURE: 1: 392512

MAP PAGE(S): 04-00-007

APPOVED BY: AC **DATE:** February 26, 2025

SCALE: 1 in = 100 ft **PRIOR INSTRUMENT:** 1979- 0050752