PARENT PARCEL: 10-00-006-107-010

CHILD PARCEL: AC CORR PER SURV BY THOMAS A. SIMON

STARTING POINT: C/L OF E RIVER RD AND E LINE OF SECTION 6

22-04986-A

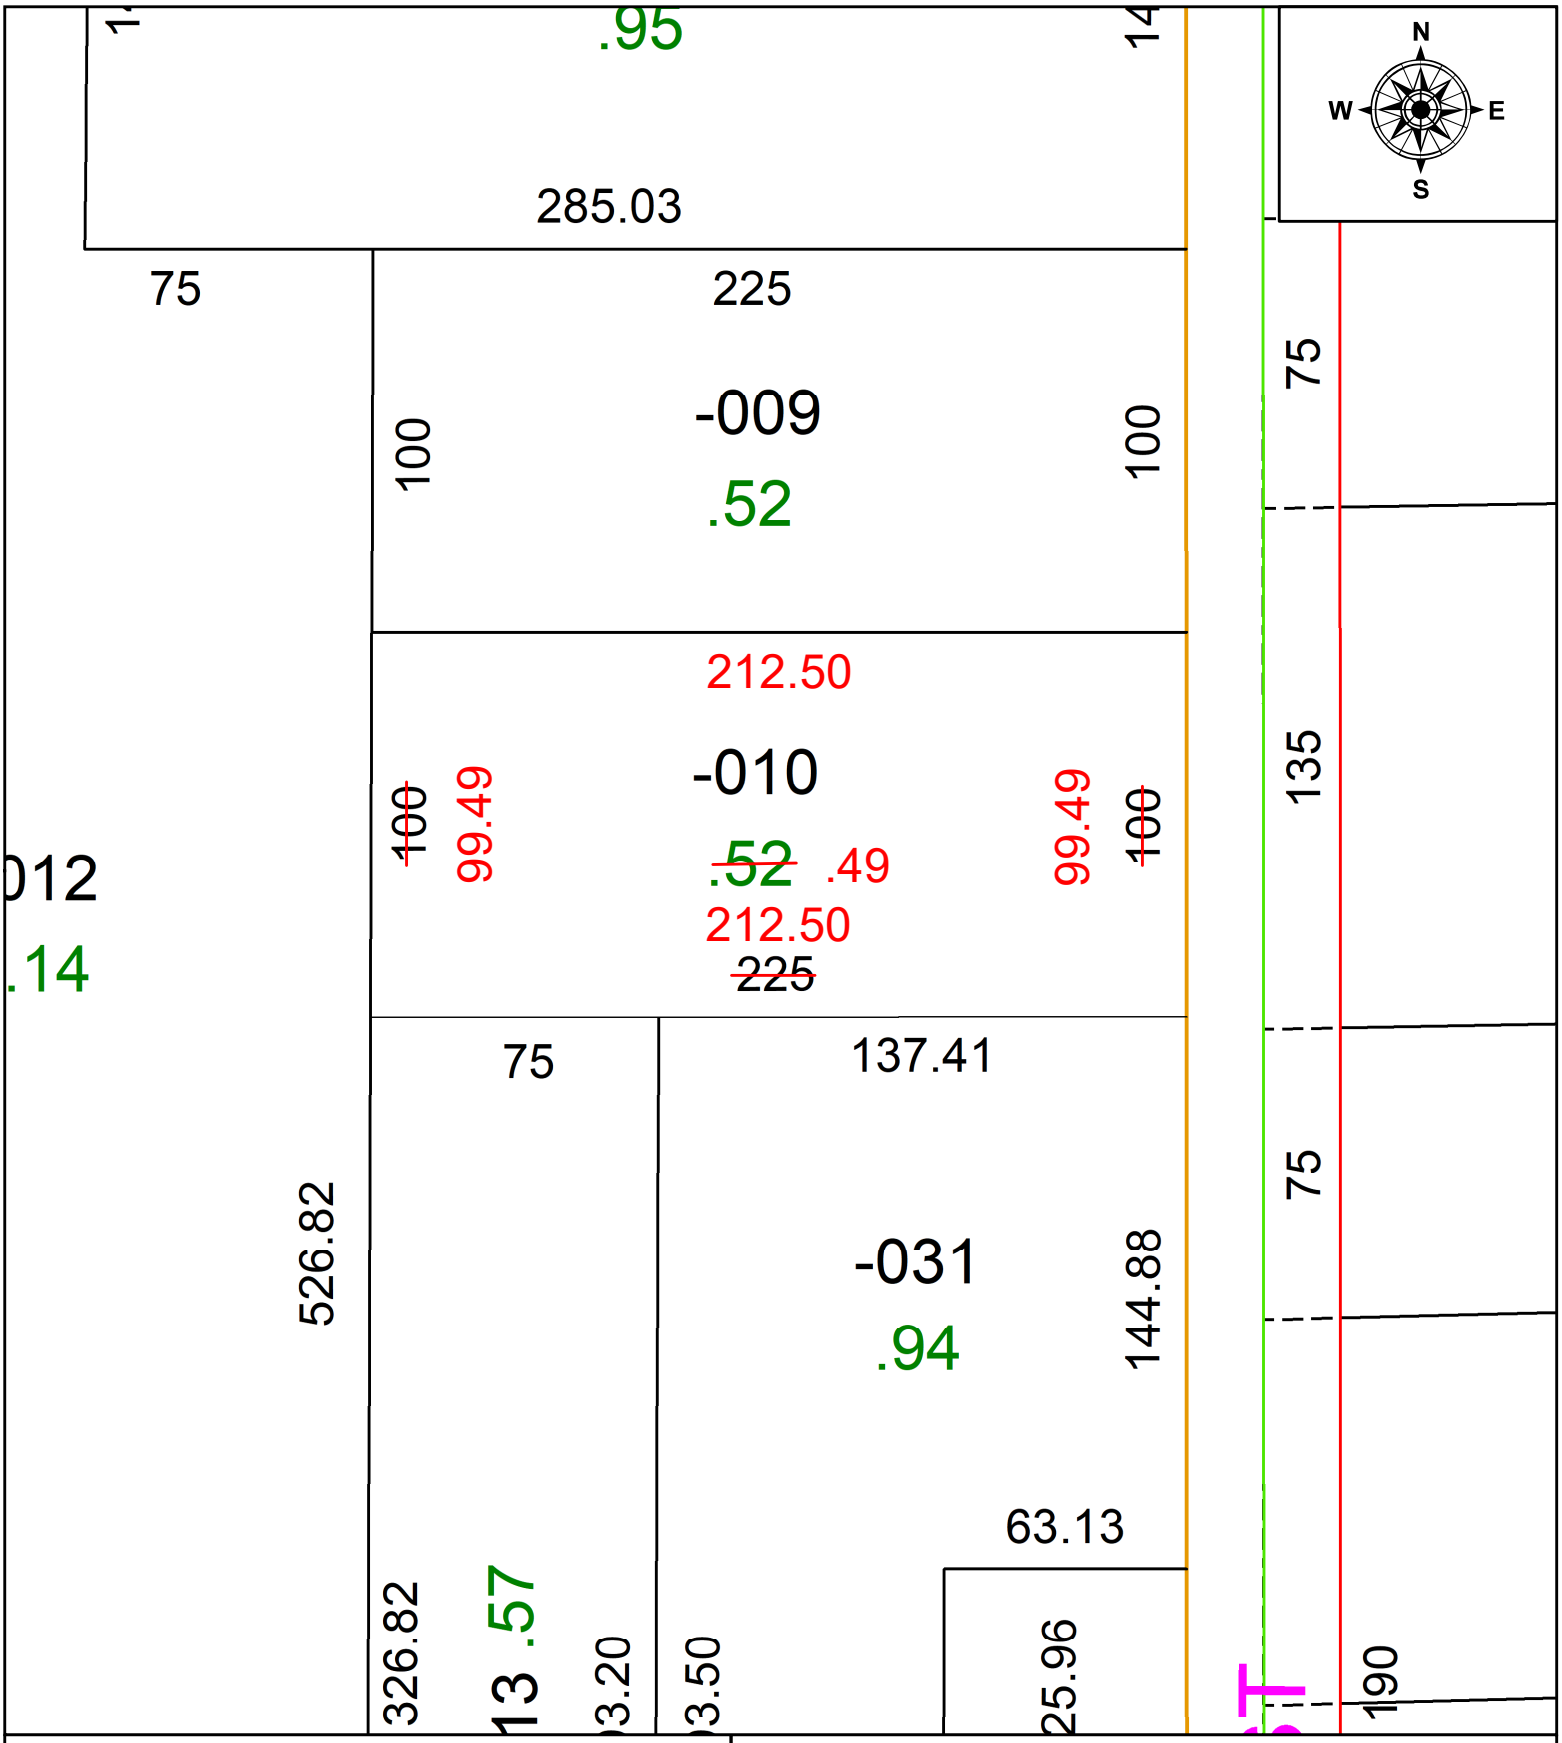

SPLITS/DEEDS PROCESSED

LORAIN COUNTY TAX MAP DEPARTMENT
226 MIDDLE AVE. ELYRIA, OH

SURVEYED BY: THOMAS A. SIMON **SURV # 50741**

CLOSURE: 1: 2147483648

MAP PAGE(S): 10-00-006

APPOVED BY: AC **DATE:** November 21, 2022

SCALE: 1 in = 50 ft **PRIOR INSTRUMENT:** 2022- 0873222