PARENT PARCEL: 11-00-010-000-006, -007,-020, -018, -049, & 11-00-011-000-006, -012, -011, -004

CHILD PARCEL: 11-00-011-000-015, -016, -017 & 11-00-010-000-062

STARTING POINT: C/L ROOT RD AND SPRAGUE RD

25-04993

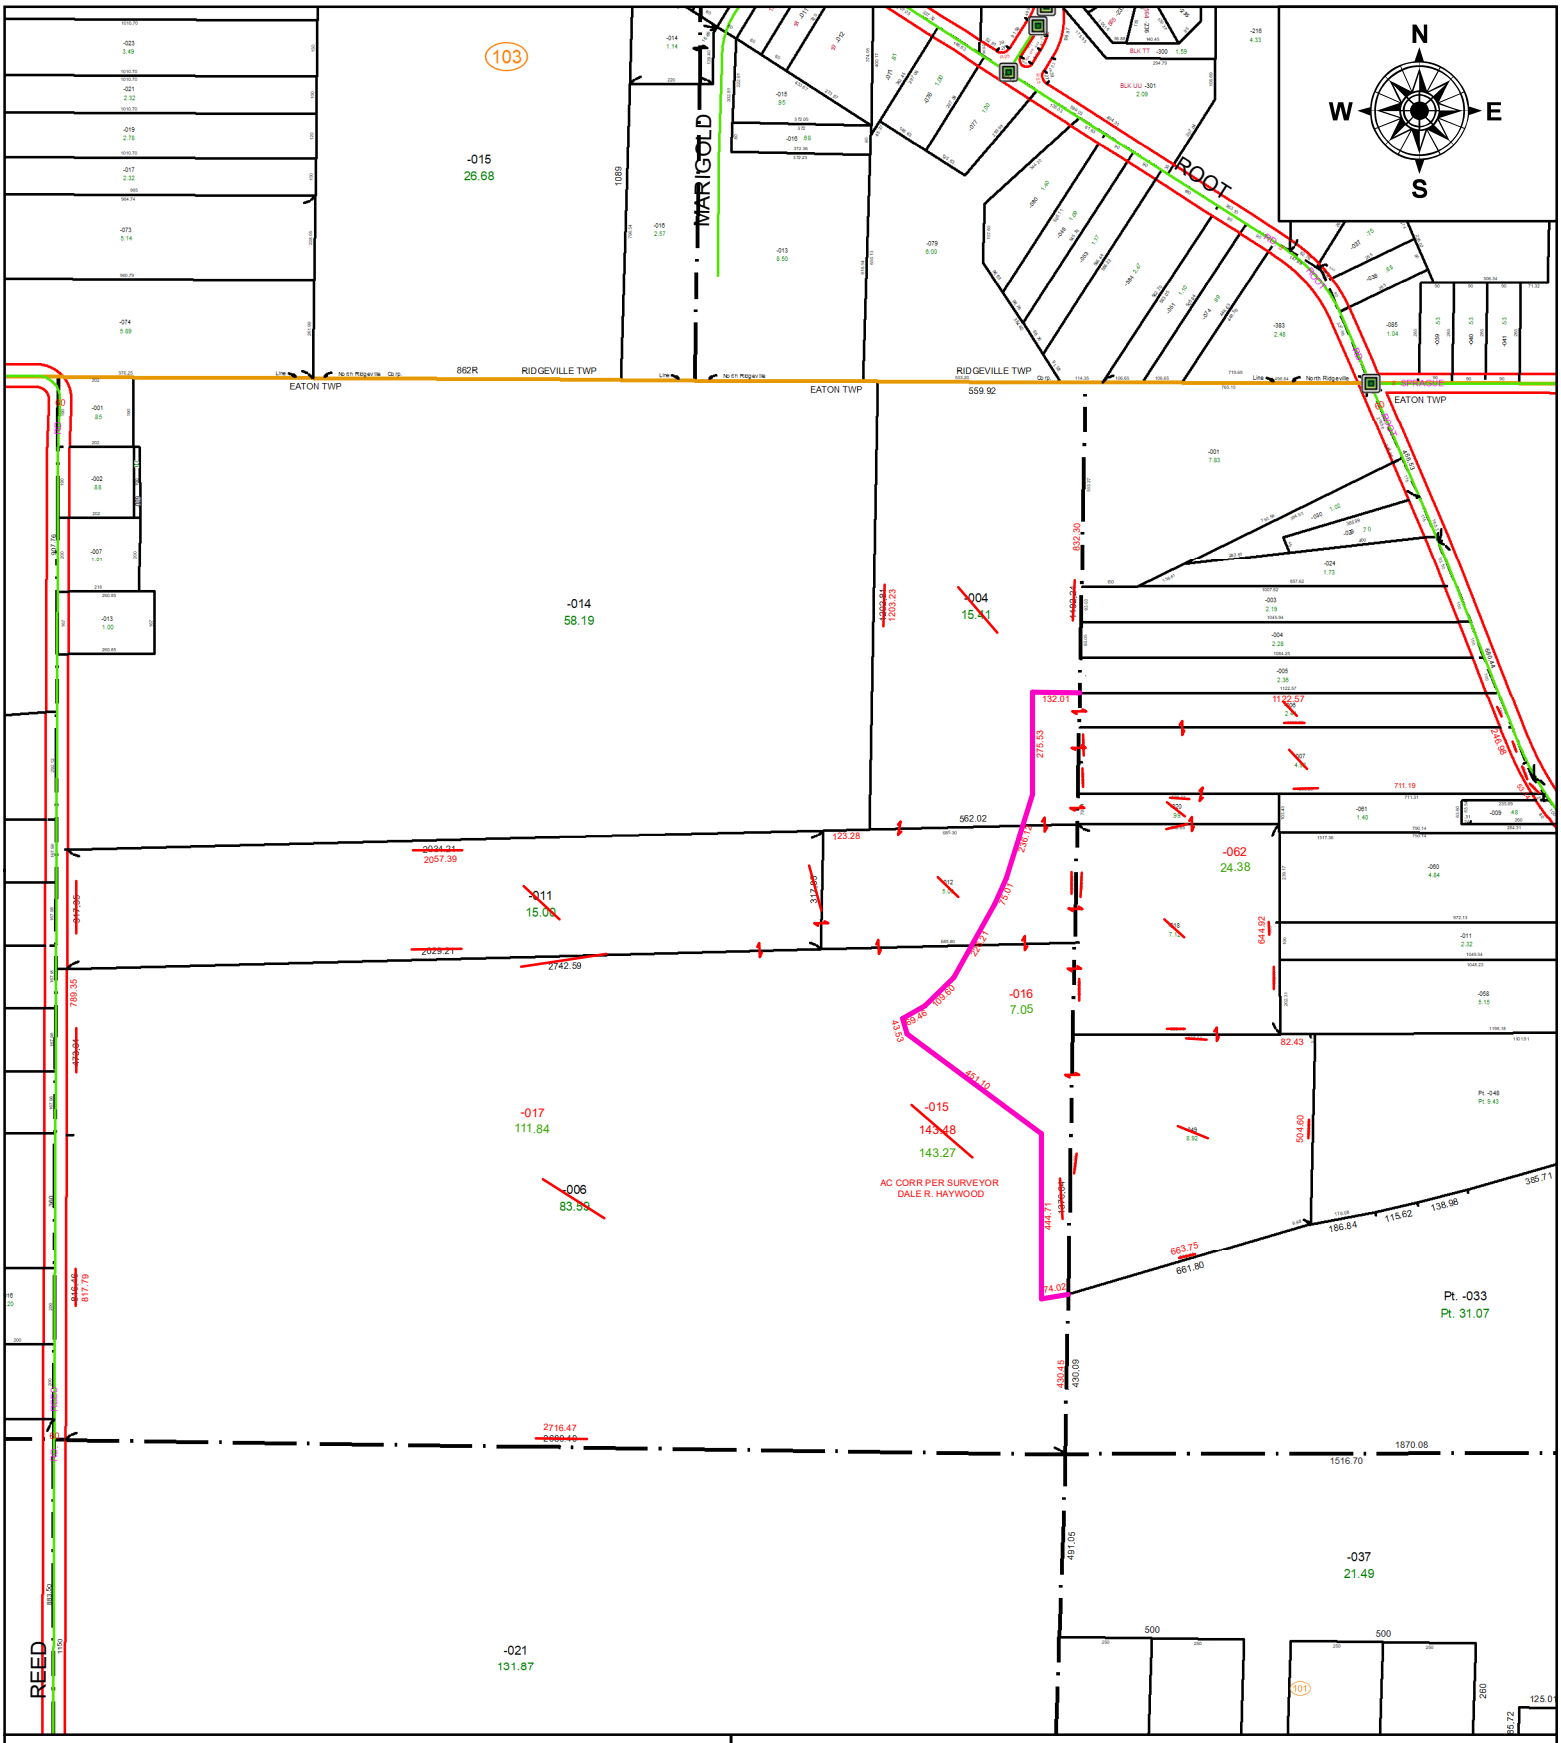

SPLITS/DEEDS PROCESSED

LORAIN COUNTY TAX MAP DEPARTMENT
226 MIDDLE AVE. ELYRIA, OH

SURVEYED BY: DALE R. HAYWOOD **SURVEY #:** 51414
CLOSURE: 1: 847460
MAP PAGE(S): 0500026
APPOVED BY: BB **DATE:** 3/28/2025
SCALE: 1" = 6500' **PRIOR INSTRUMENT:** #20100358718