PARENT PARCEL: 21-03-000-000-013

CHILD PARCEL: N/A ACREAGE CORRECTION PER SURVEYOR THOMAS SIMON

STARTING POINT: RAILROAD SPIKE @ INTERSECTION OF C/LS STEWART RD & BAKER RD

22-04998-A

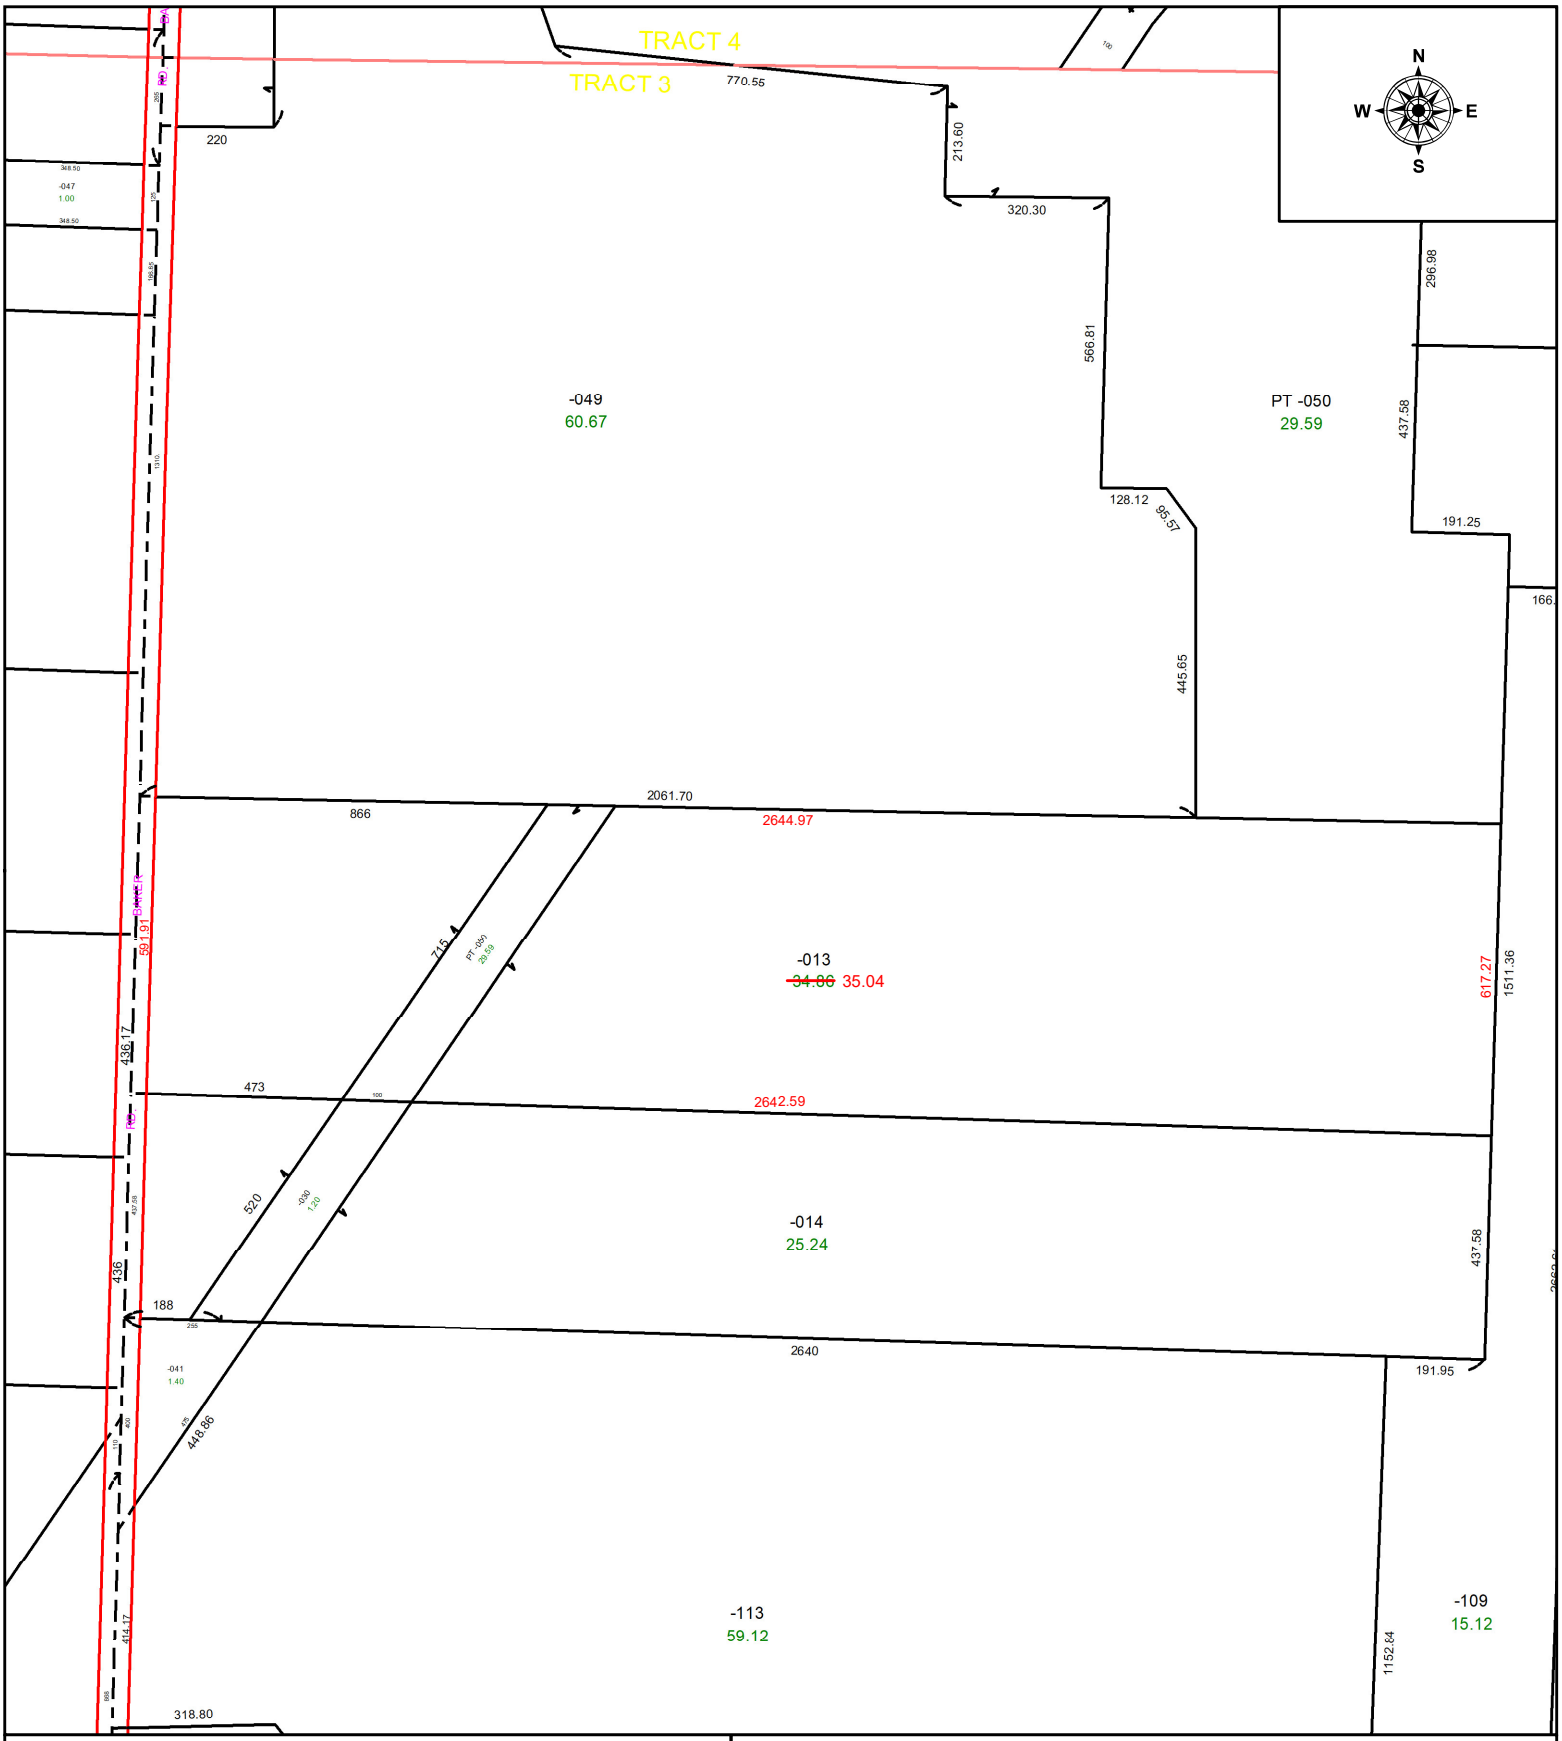

SPLITS/DEEDS PROCESSED

LORAIN COUNTY TAX MAP DEPARTMENT
226 MIDDLE AVE. ELYRIA, OH

SURVEYED BY: THOMAS SIMON SURVEY # 50761

CLOSURE: 1: 552345

MAP PAGE(S): 21-03-000

APPOVED BY: WRZ **DATE:** 12/15/2022

SCALE: 1" = 375 **PRIOR INSTRUMENT:** OR V148 PG 271