PARENT PARCEL: 06-25-098-102-005, -012, -014, -015

CHILD PARCEL: 06-25-098-102-016

STARTING POINT: NE CORNER OF SUBLOT 5

25-04998

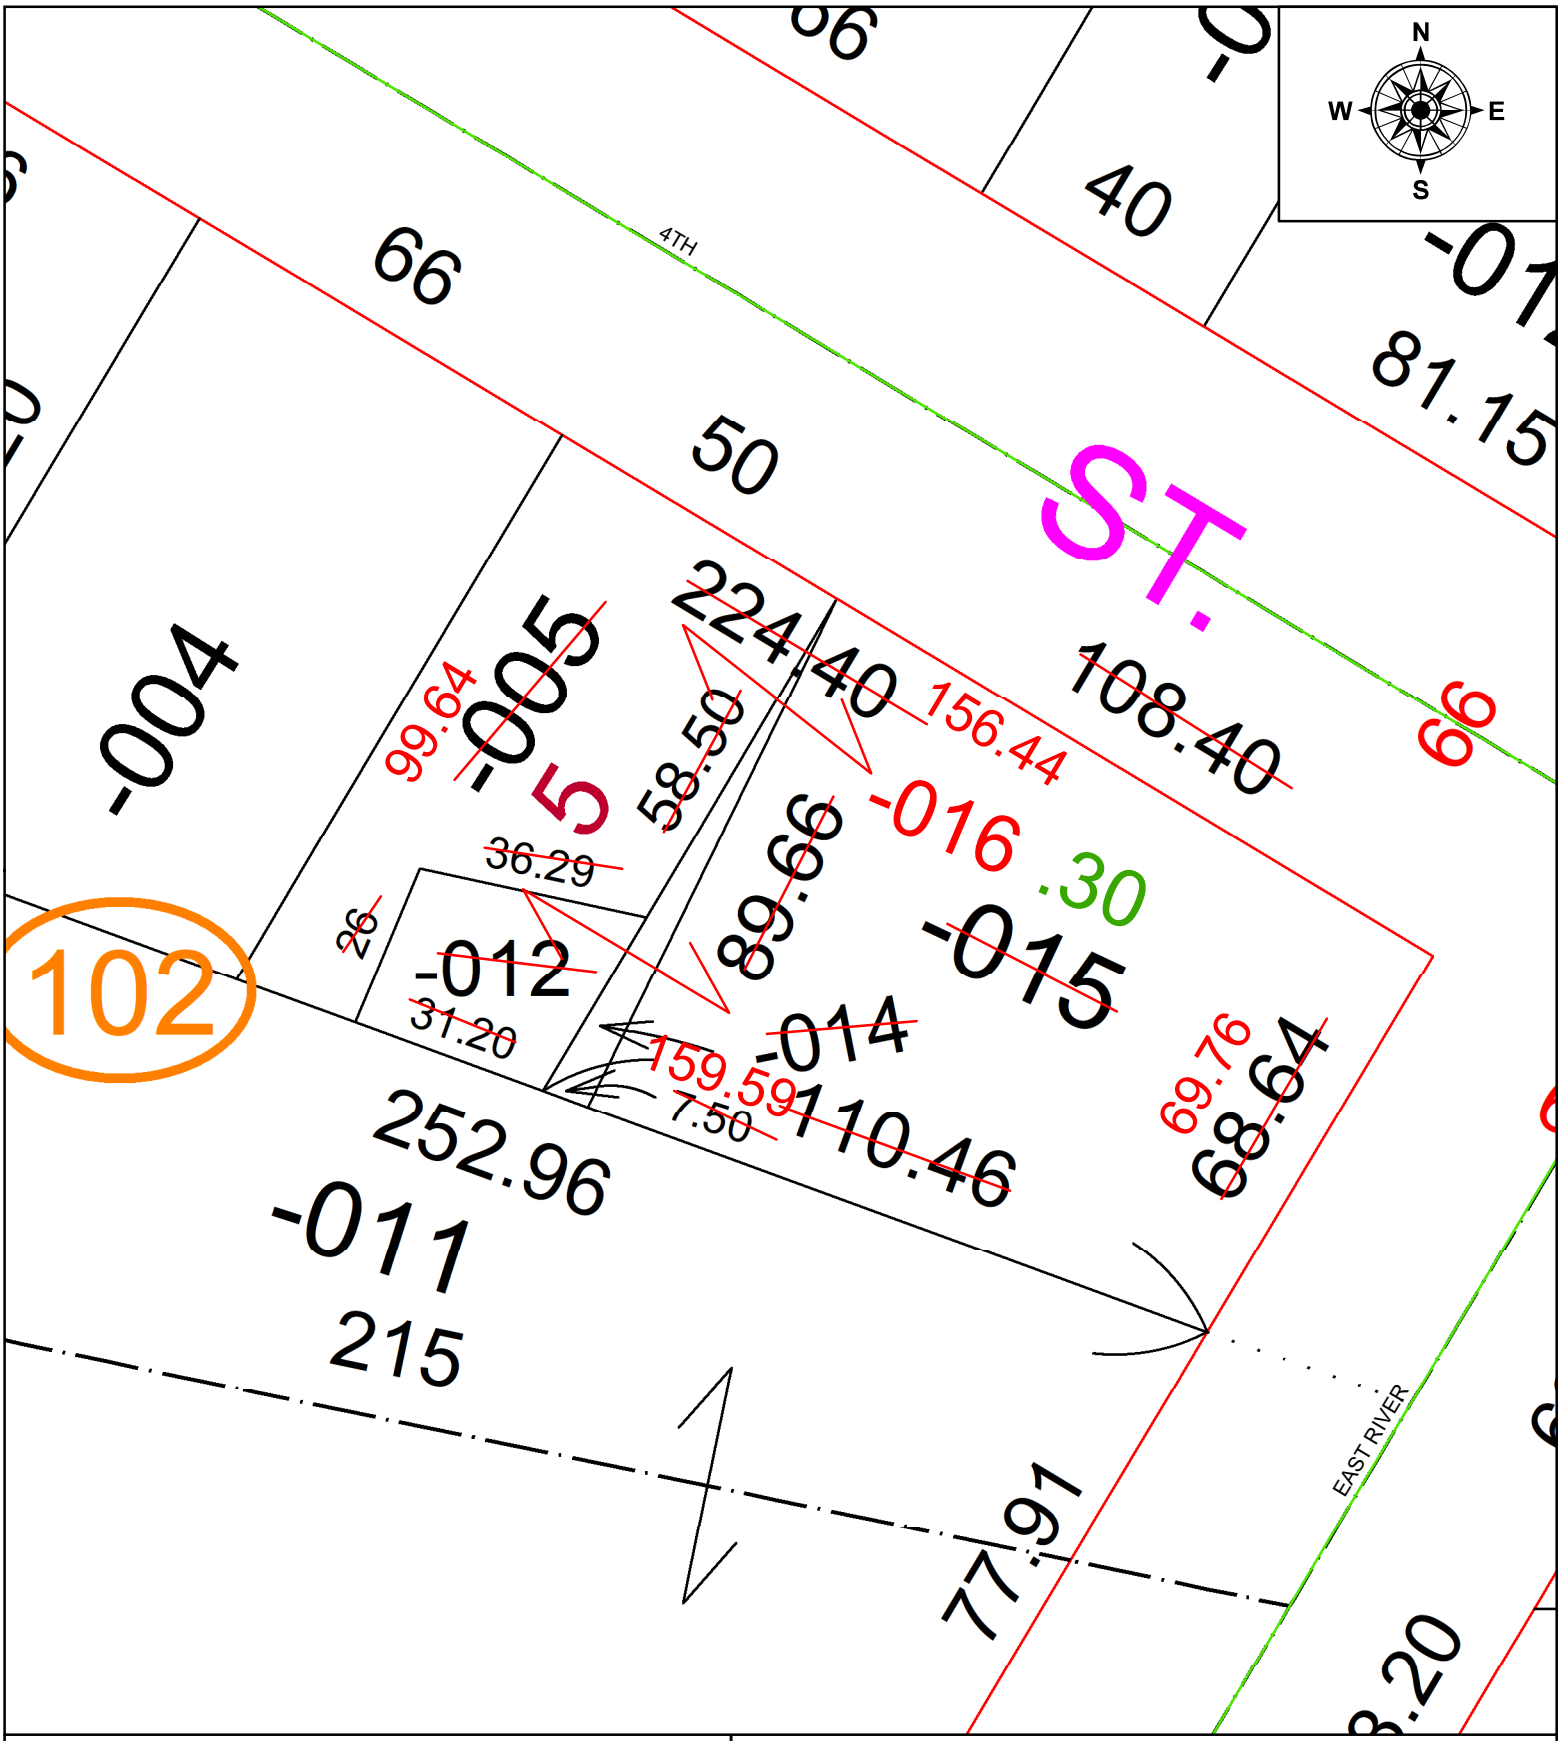

SPLITS/DEEDS PROCESSED

LORAIN COUNTY TAX MAP DEPARTMENT
226 MIDDLE AVE. ELYRIA, OH

SURVEYED BY: THOMAS A. SIMON **SURVEY #:** 51421
CLOSURE: 1: 62737
MAP PAGE(S): 06-25-098
APPOVED BY: BB **DATE:** 4/10/2025
SCALE: 1" = 30' **PRIOR INSTRUMENT:** #19930259723