PARENT PARCEL: 04-00-010-117-002

CHILD PARCEL: MAP CORRECTION ONLY PER SURV BY MATTHEW A. HILDEBRANDT

STARTING POINT: C/L OF STONEY RIDGE RD AND JULIAN ST

22-05001-C

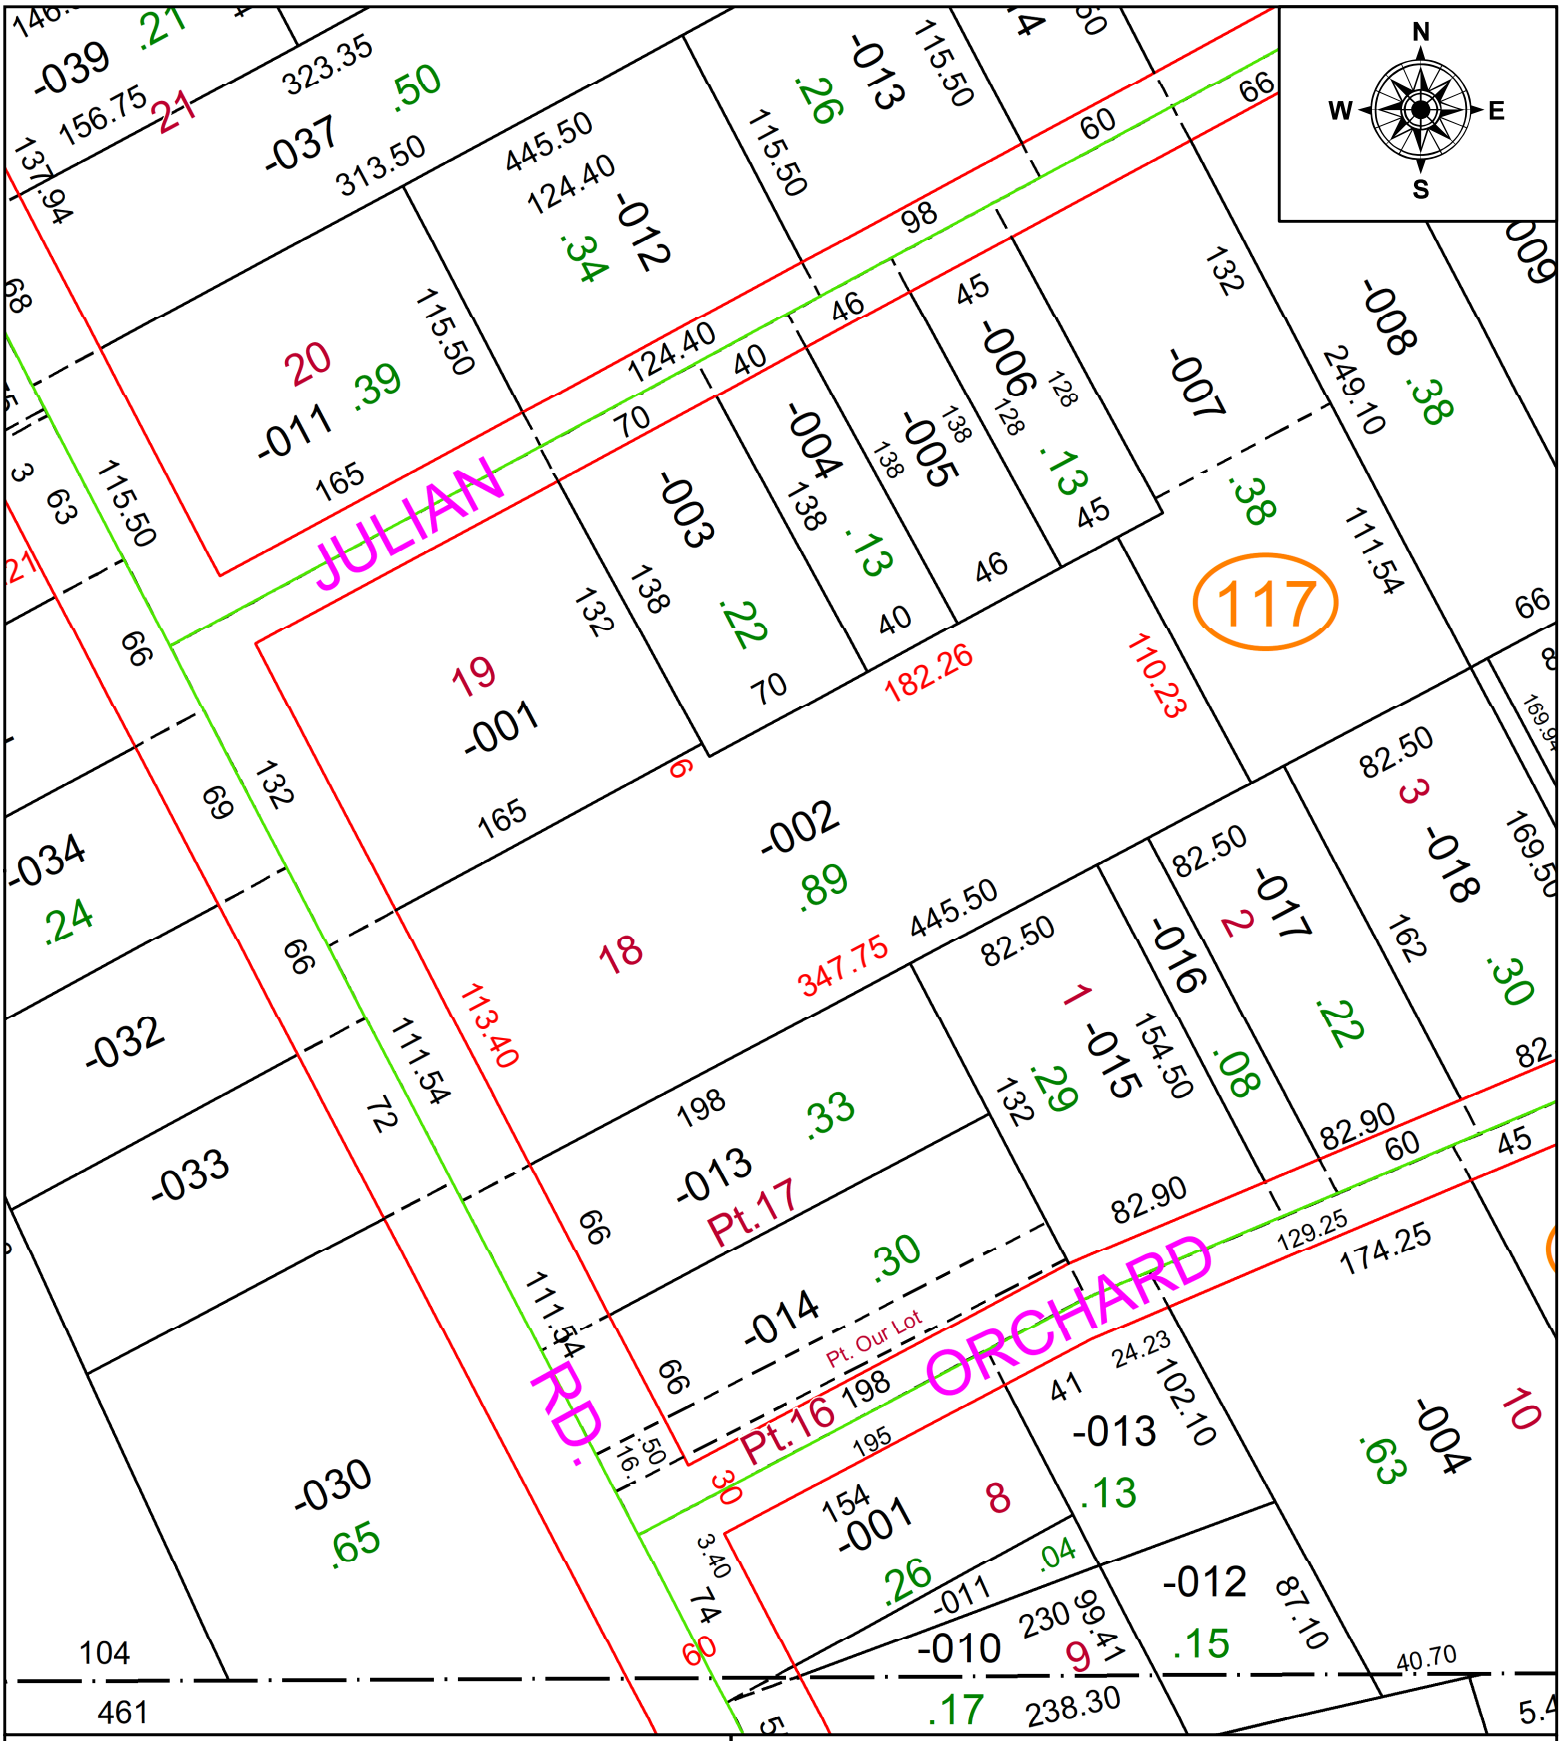

SPLITS/DEEDS PROCESSED

LORAIN COUNTY TAX MAP DEPARTMENT
226 MIDDLE AVE. ELYRIA, OH

SURVEYED BY: MATTHEW A. HILDEBRANDT **SURV # 50765**

CLOSURE: 1: 97492

MAP PAGE(S): 04-00-010-G

APPOVED BY: AC **DATE:** December 21, 2022

SCALE: 1 in = 75 ft **PRIOR INSTRUMENT:** 2016- 0591776