PARENT PARCEL: 15-00-093-000-008

CHILD PARCEL: AC CORR PER PRIOR DEED INST # 1986- 0240027

STARTING POINT: C/L OF INDIAN HOLLOW AND NW CORNER OF LAND

22-05003-A

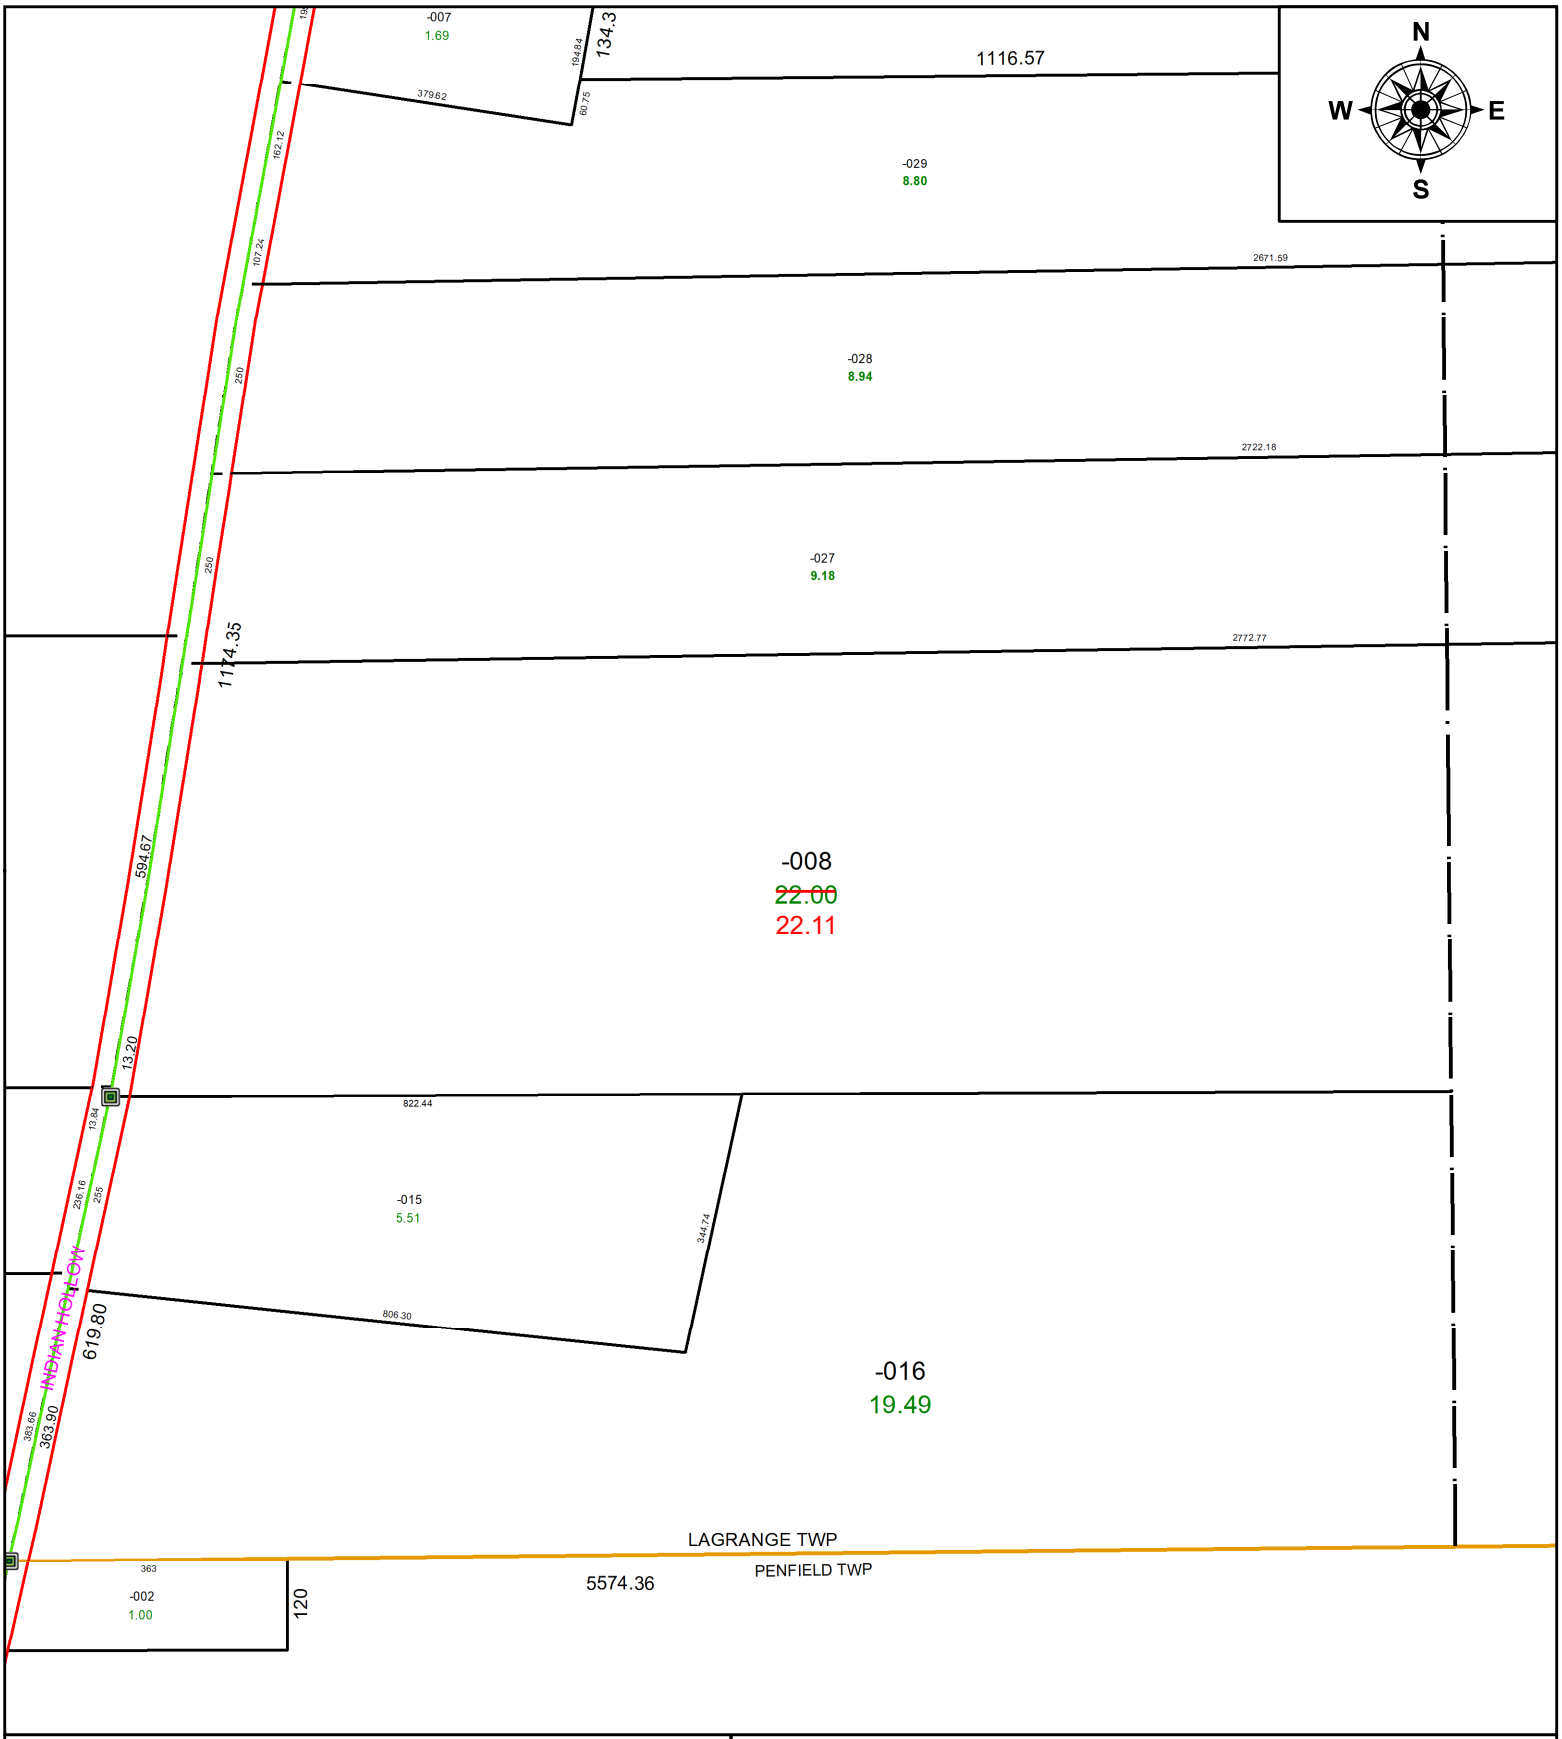

SPLITS/DEEDS PROCESSED

LORAIN COUNTY TAX MAP DEPARTMENT
226 MIDDLE AVE. ELYRIA, OH

SURVEYED BY: N/A **SURV # N/A**

CLOSURE: N/A

MAP PAGE(S): 15-00-093

APPOVED BY: AC **DATE:** December 22, 2022

SCALE: 1 in = 250 ft **PRIOR INSTRUMENT:** 1986- 0240027