**PARENT PARCEL:** 08-00-093-000-012 & -042

**CHILD PARCEL:** 08-00-093-000-049

**STARTING POINT:** C/L OF BAIRD RD AND TELEGRAPH RD

25-05005

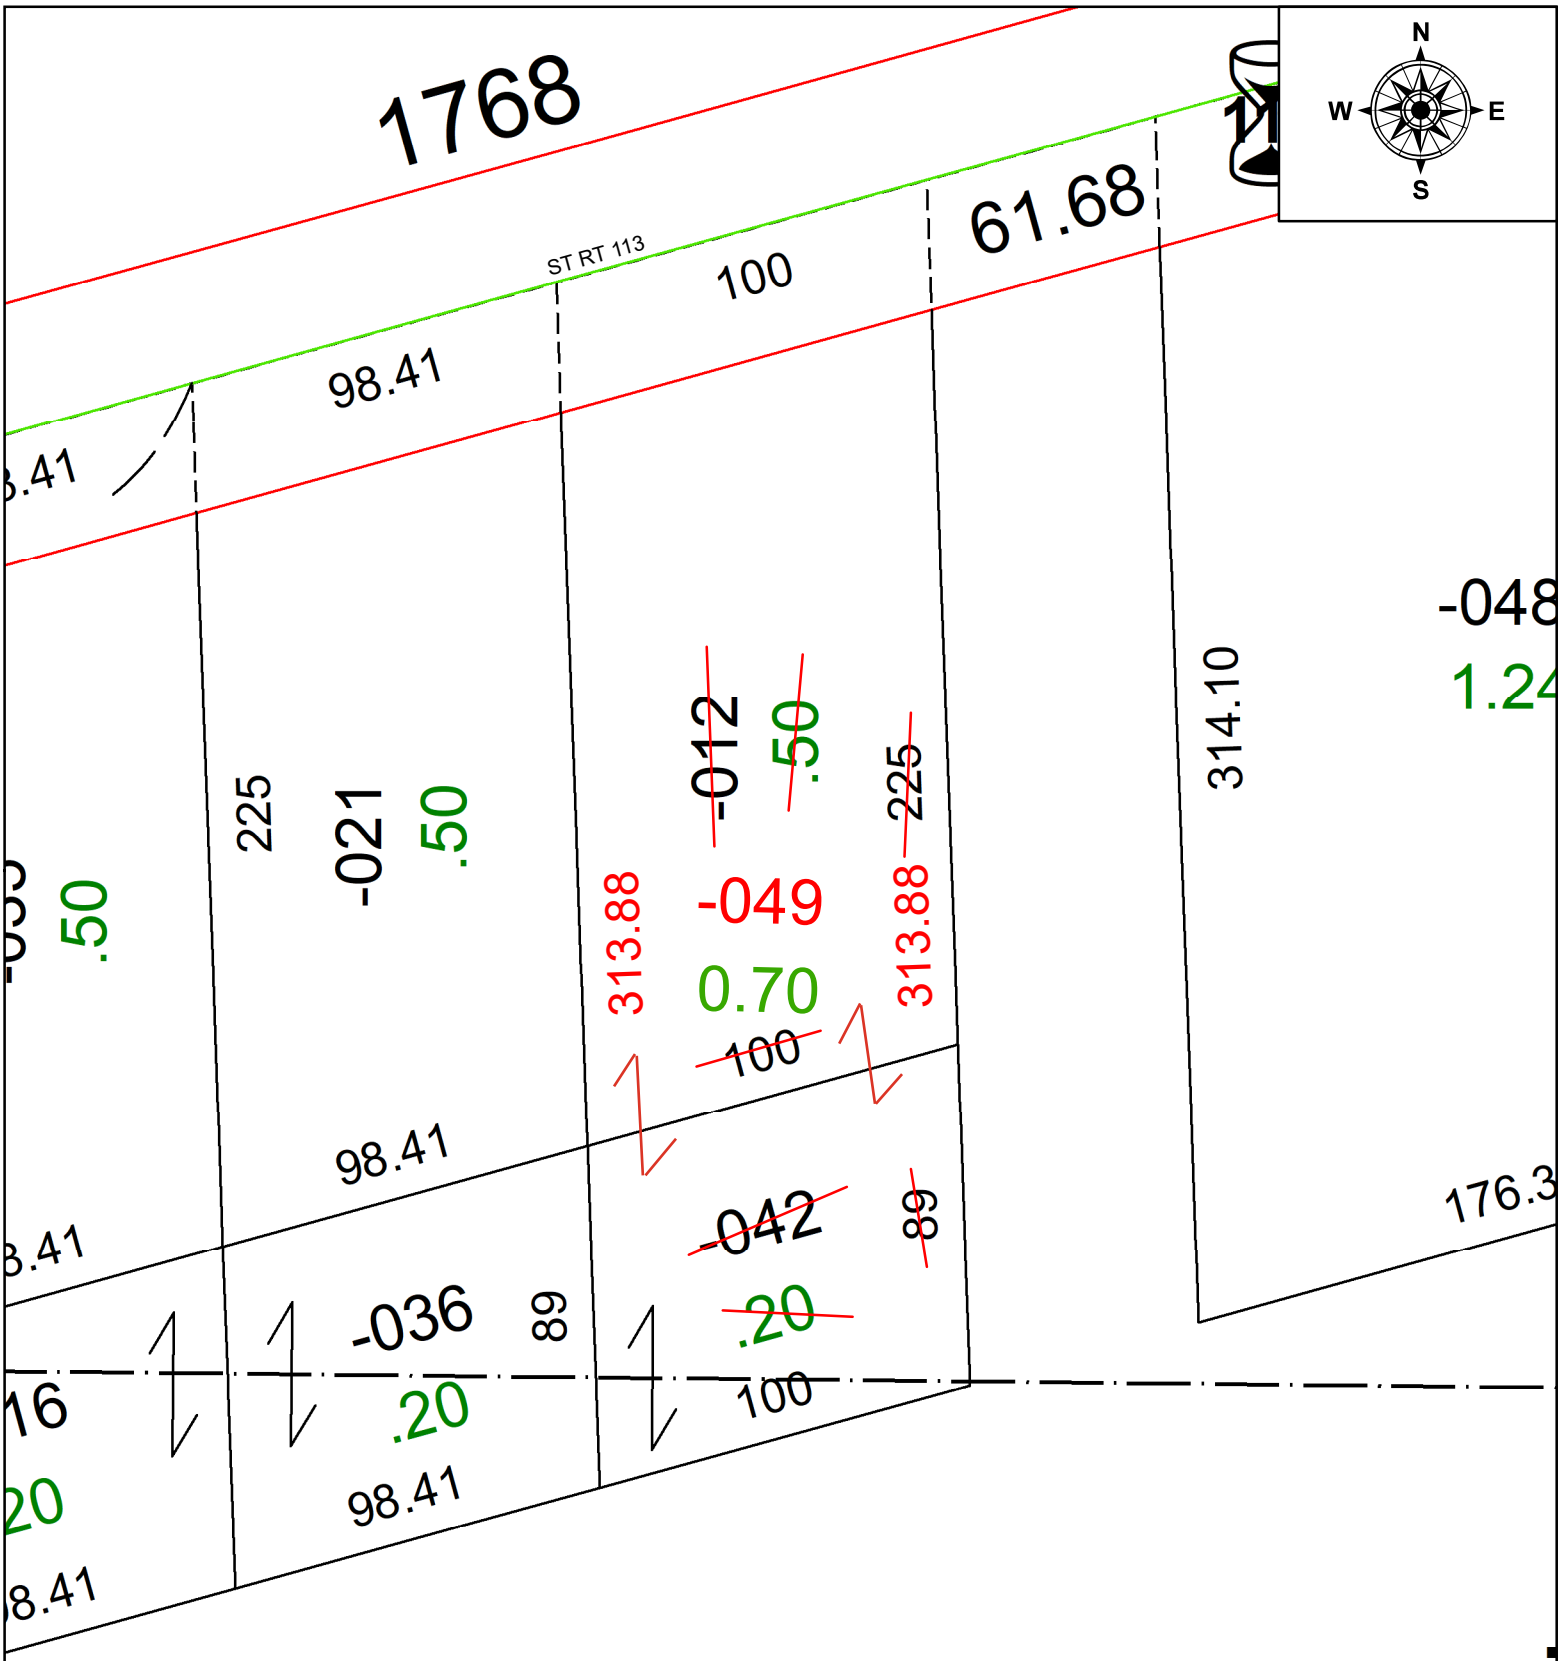


**SPLITS/DEEDS PROCESSED**

LORAIN COUNTY TAX MAP DEPARTMENT
226 MIDDLE AVE. ELYRIA, OH

**SURVEYED BY:** MITCHEL R. CAVANAUGH **SURVEY #:** 51442
**CLOSURE:** 1: INF
**MAP PAGE(S):** 08-00-093
**APPOVED BY:** BB **DATE:** 5/5/2025
**SCALE:** 1" = 50' **PRIOR INSTRUMENT:** #20220887400