PARENT PARCEL: 05-00-029-000-079

CHILD PARCEL: AC CORR PER SURV BY AMY M. KELLY

STARTING POINT: C/L OF TELEGRAPH RD AND E LINE OF O/L 29

23-05010-A

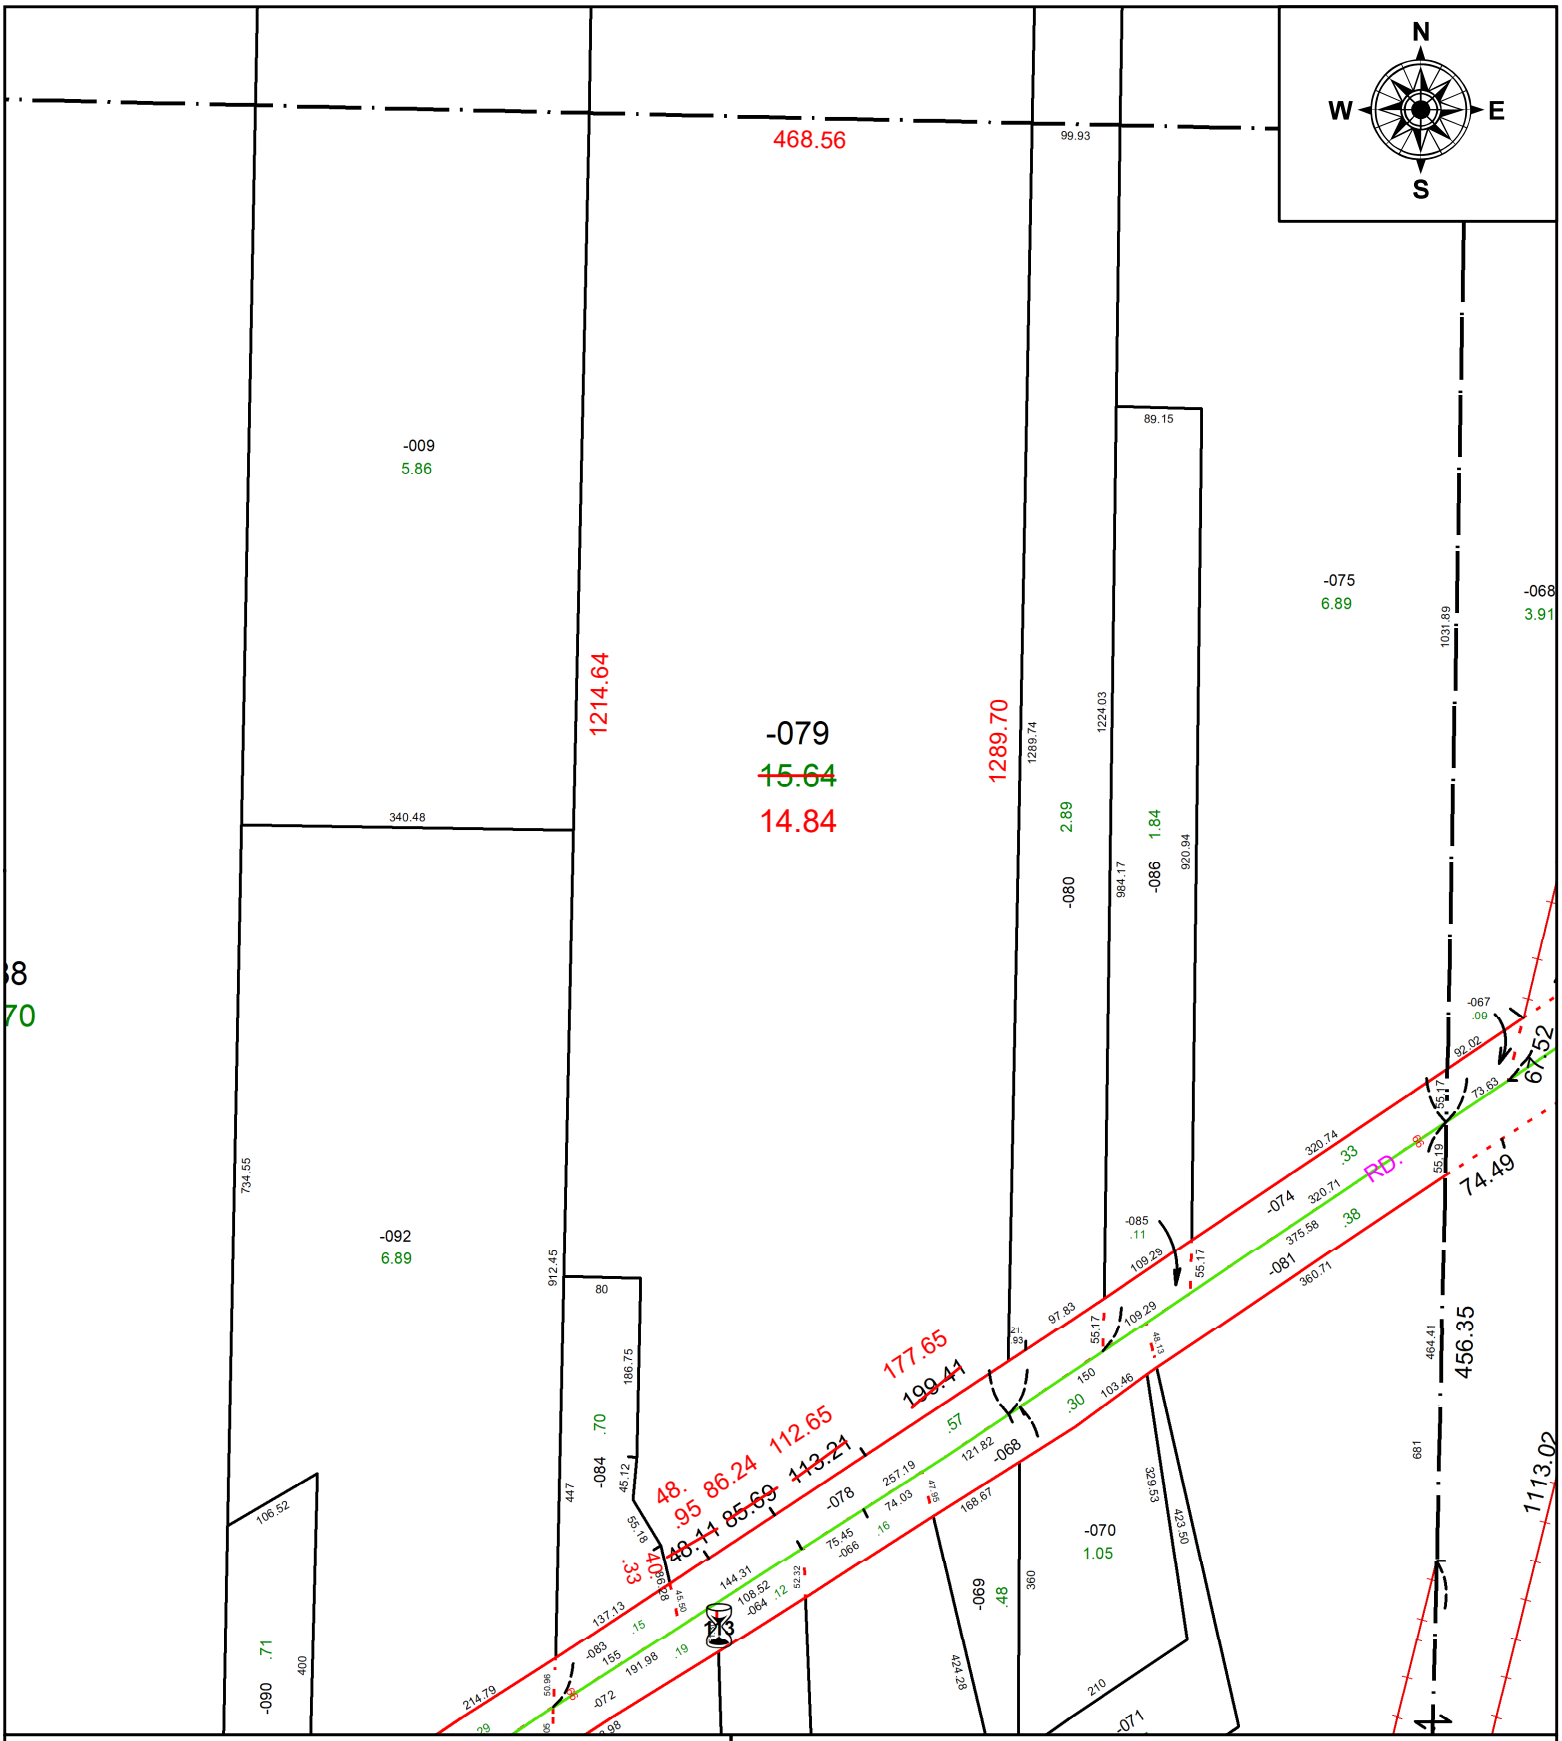

SPLITS/DEEDS PROCESSED

LORAIN COUNTY TAX MAP DEPARTMENT
226 MIDDLE AVE. ELYRIA, OH

SURVEYED BY: AMY M. KELLY **SURV # 50772**

CLOSURE: 1: 436737

MAP PAGE(S): 05-00-029

APPOVED BY: AC **DATE:** January 06, 2023

SCALE: 1 in = 200 ft **PRIOR INSTRUMENT:** 2019- 0703533