PARENT PARCEL: 02-01-005-108-010
CHILD PARCEL: FR. & DEPTH TO AC. CORR.
STARTING POINT: CL OF WASHINGTON AVE. & W. 6TH ST.

23-05012-C

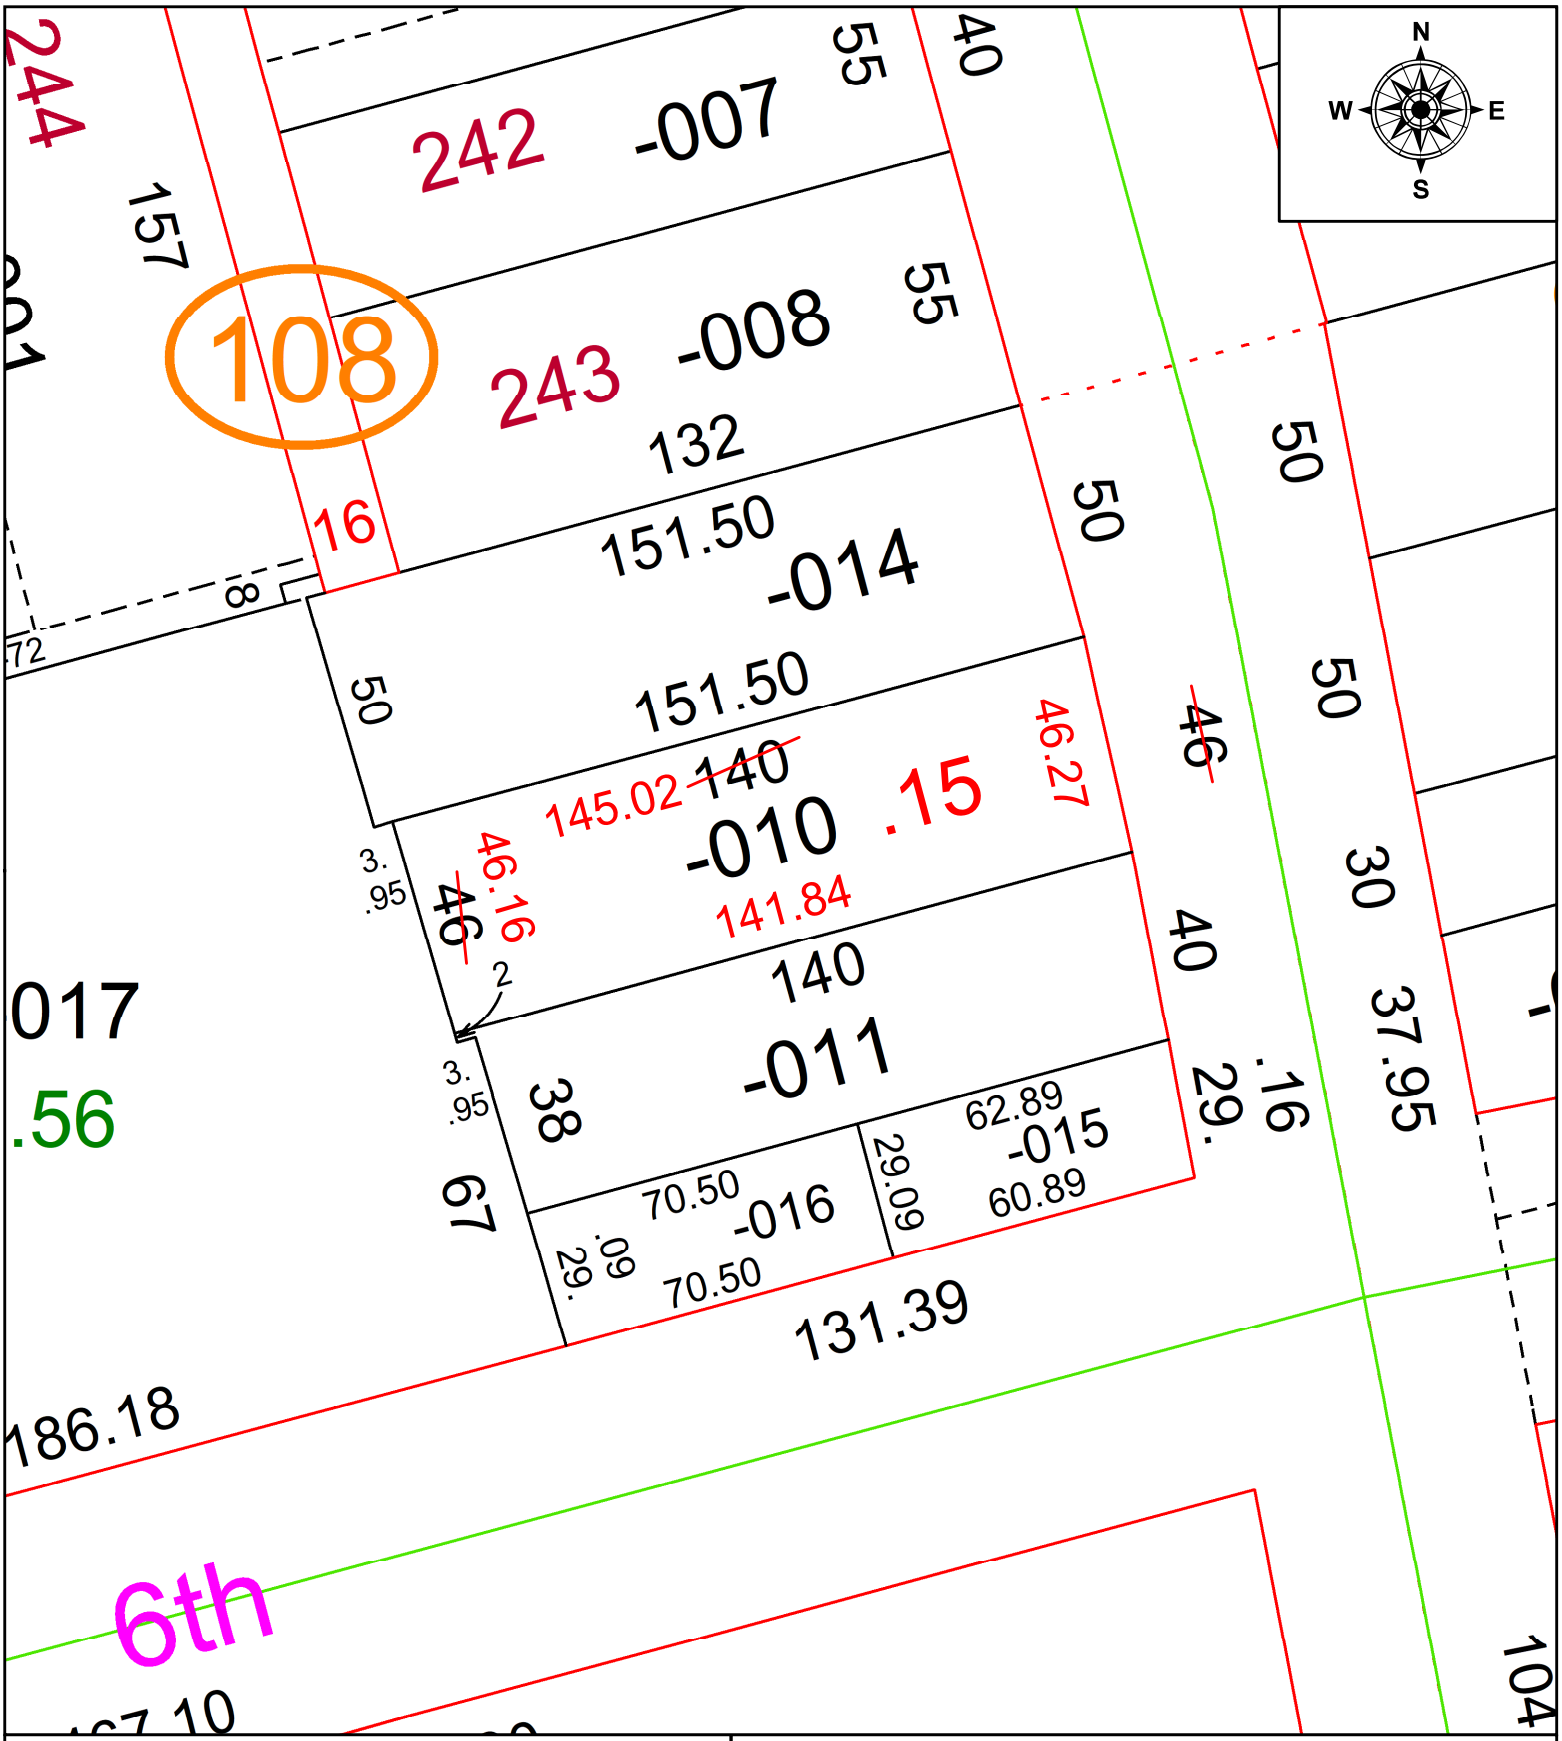

SPLITS/DEEDS PROCESSED
LORAIN COUNTY TAX MAP DEPARTMENT
226 MIDDLE AVE. ELYRIA, OH

SURVEYED BY: MATTHEW HILDEBRANDT **SURVEY #:** 50780
CLOSURE: 1:119710
MAP PAGE(S): 02-01-005
APPOVED BY: DMA **DATE:** 1/10/2023
SCALE: 1" = 40' **PRIOR INSTRUMENT:** 2022-0870008