PARENT PARCEL: N/A

CHILD PARCEL: 03-00-017-102-050 ADD TO DUPLICATE PER DV 150/423

STARTING POINT: N/A

23-05013-A

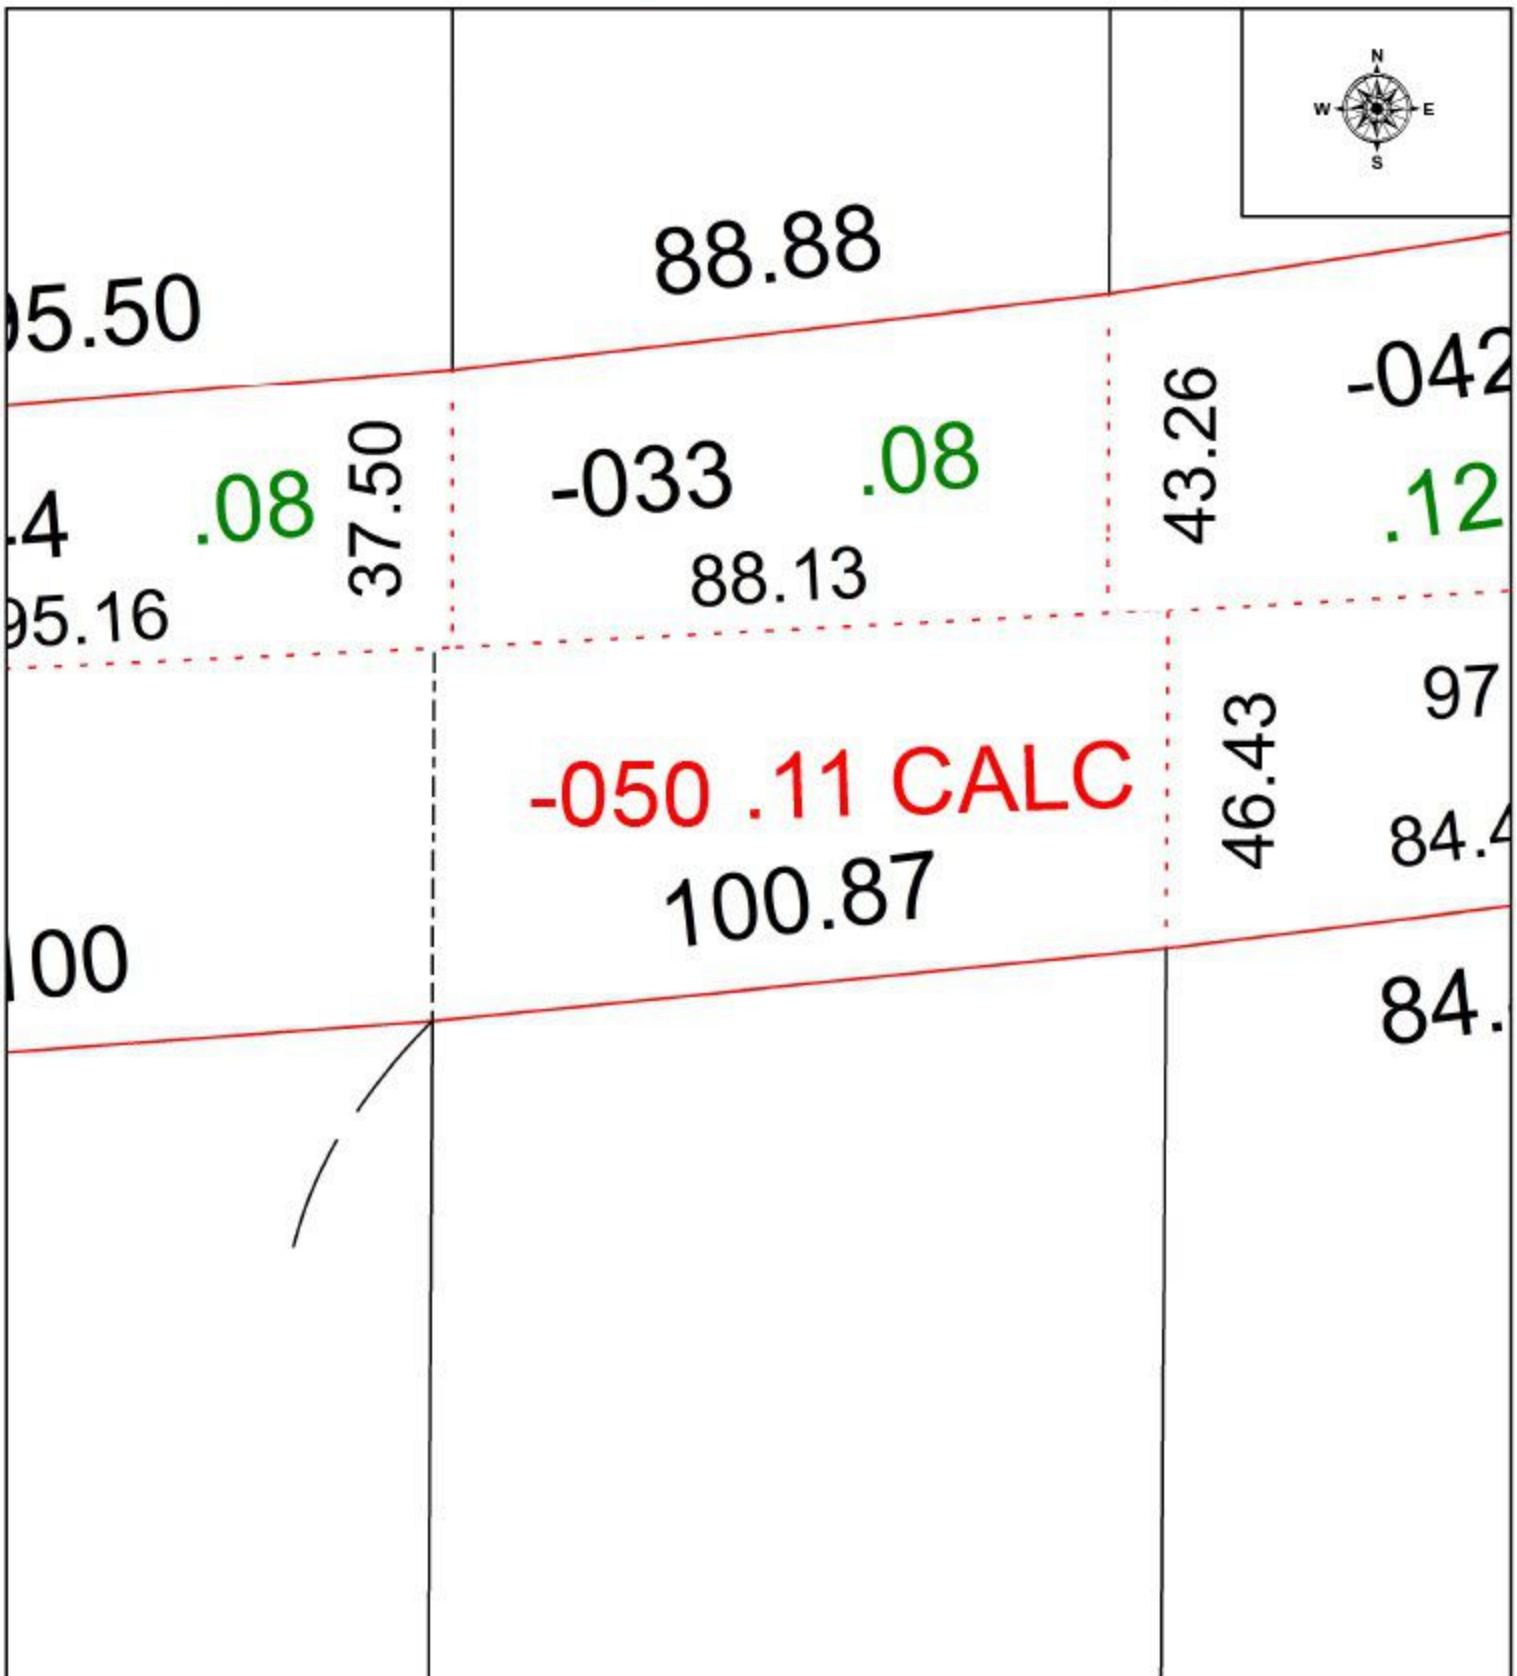

SPLITS/DEEDS PROCESSED

LORAIN COUNTY TAX MAP DEPARTMENT
226 MIDDLE AVE. ELYRIA, OH

SURVEYED BY: N/A SURVEY #

CLOSURE: 1: N/A

MAP PAGE(S): 03-00-017

APPOVED BY: WRZ DATE: 1/11/2023

SCALE: 1" = 25 PRIOR INSTRUMENT: DV 150/423