PARENT PARCEL: 21-01-007-000-001 & -002

CHILD PARCEL: 21-01-007-000-004 COMB. PER INST. # 2022-0901551

STARTING POINT: CL OF NEW-LONDON-EASTERN & N.E. CORNER OF L.J. SCHILENSKE DV. 173, PG. 221

23-05020-C

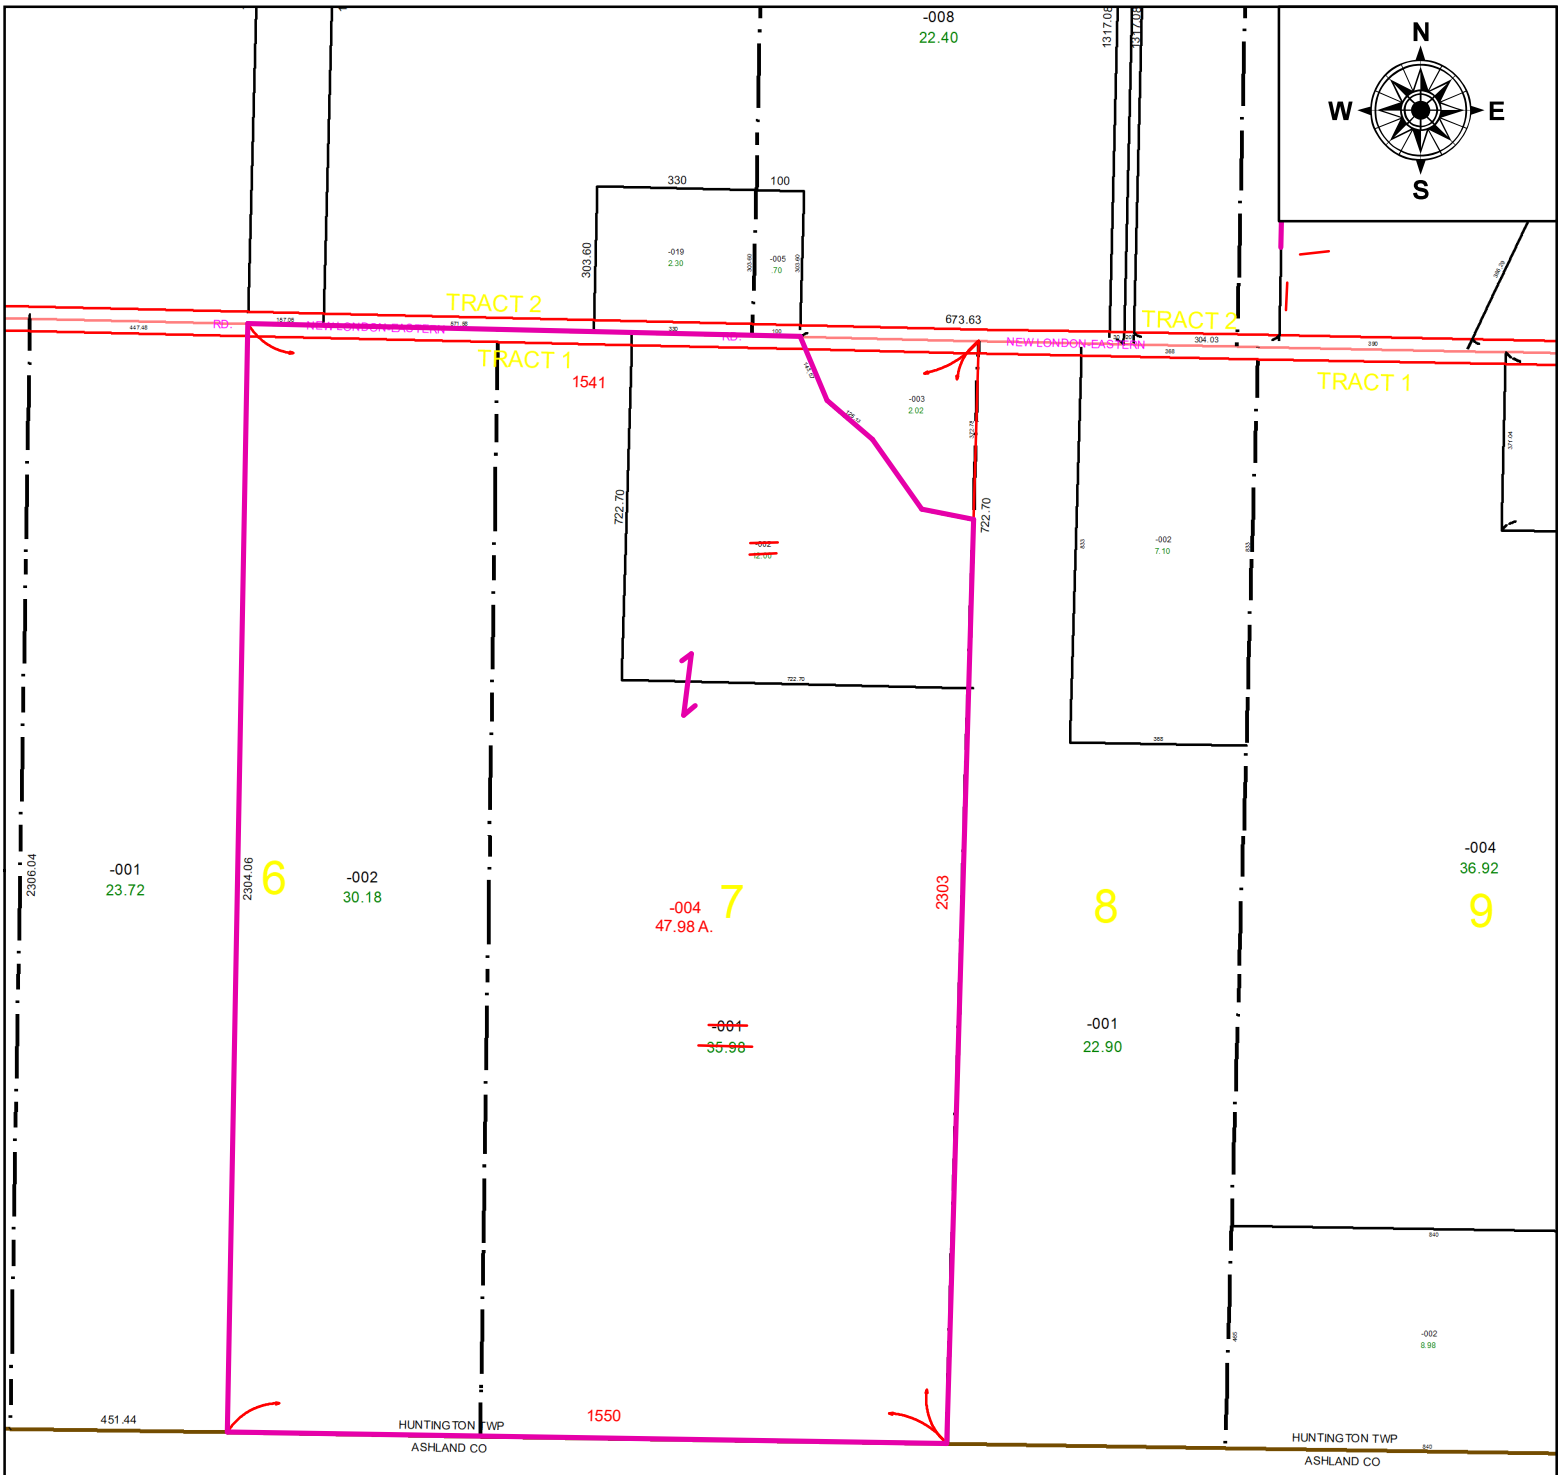

SPLITS/DEEDS PROCESSED

LORAIN COUNTY TAX MAP DEPARTMENT
226 MIDDLE AVE. ELYRIA, OH

SURVEYED BY: NA
CLOSURE: NA
MAP PAGE(S): 21-01-007
APPOVED BY: TJS **DATE:** 1/20/2023
SCALE: 1" = 400' **PRIOR INSTRUMENT:** 2022-0901551