PARENT PARCEL: 06-24-109-000-011
CHILD PARCEL: AC CORR PER SURV BY SEAN A. BOLAND
STARTING POINT: E LINE OF W RIVER RD AND N LINE OF O/L 109

23-05023-A

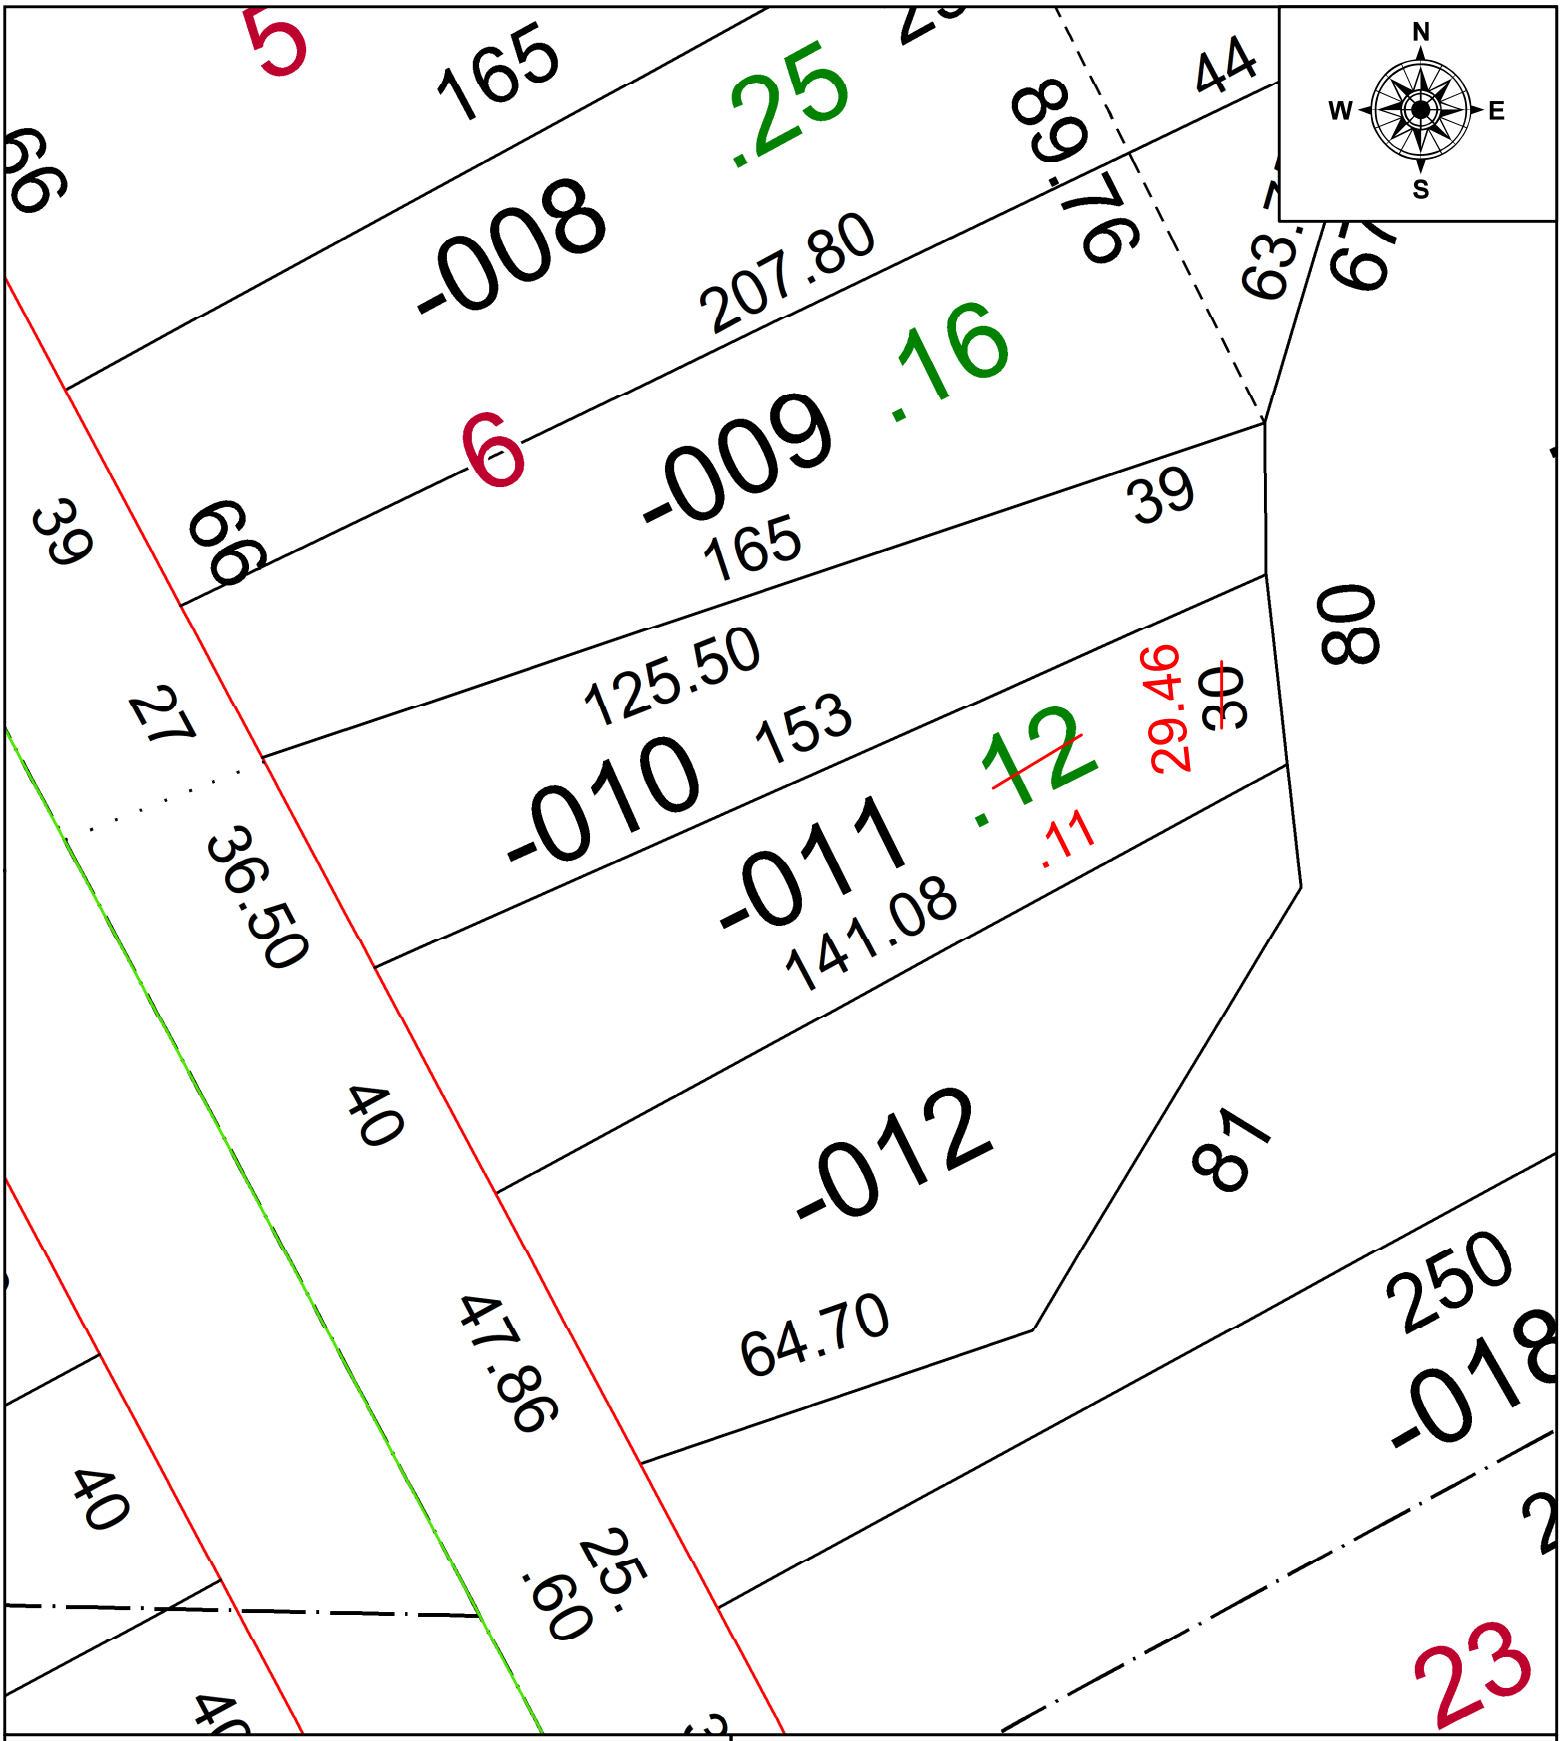

SPLITS/DEEDS PROCESSED
LORAIN COUNTY TAX MAP DEPARTMENT
226 MIDDLE AVE. ELYRIA, OH

SURVEYED BY: SEAN A. BOLAND **SURV # 50798**
CLOSURE: 1: 117194
MAP PAGE(S): 06-118
APPOVED BY: AC **DATE:** January 31, 2023
SCALE: 1 in = 30 ft **PRIOR INSTRUMENT:** 2019- 0720883