PARENT PARCEL: 10-00-004-129-002

CHILD PARCEL: AC CORR PER PRIOR DEED INSTRUMENT NO. 2020- 0794998

STARTING POINT: S LINE OF 16TH AND W LINE OF EAST AVE

23-05026-A

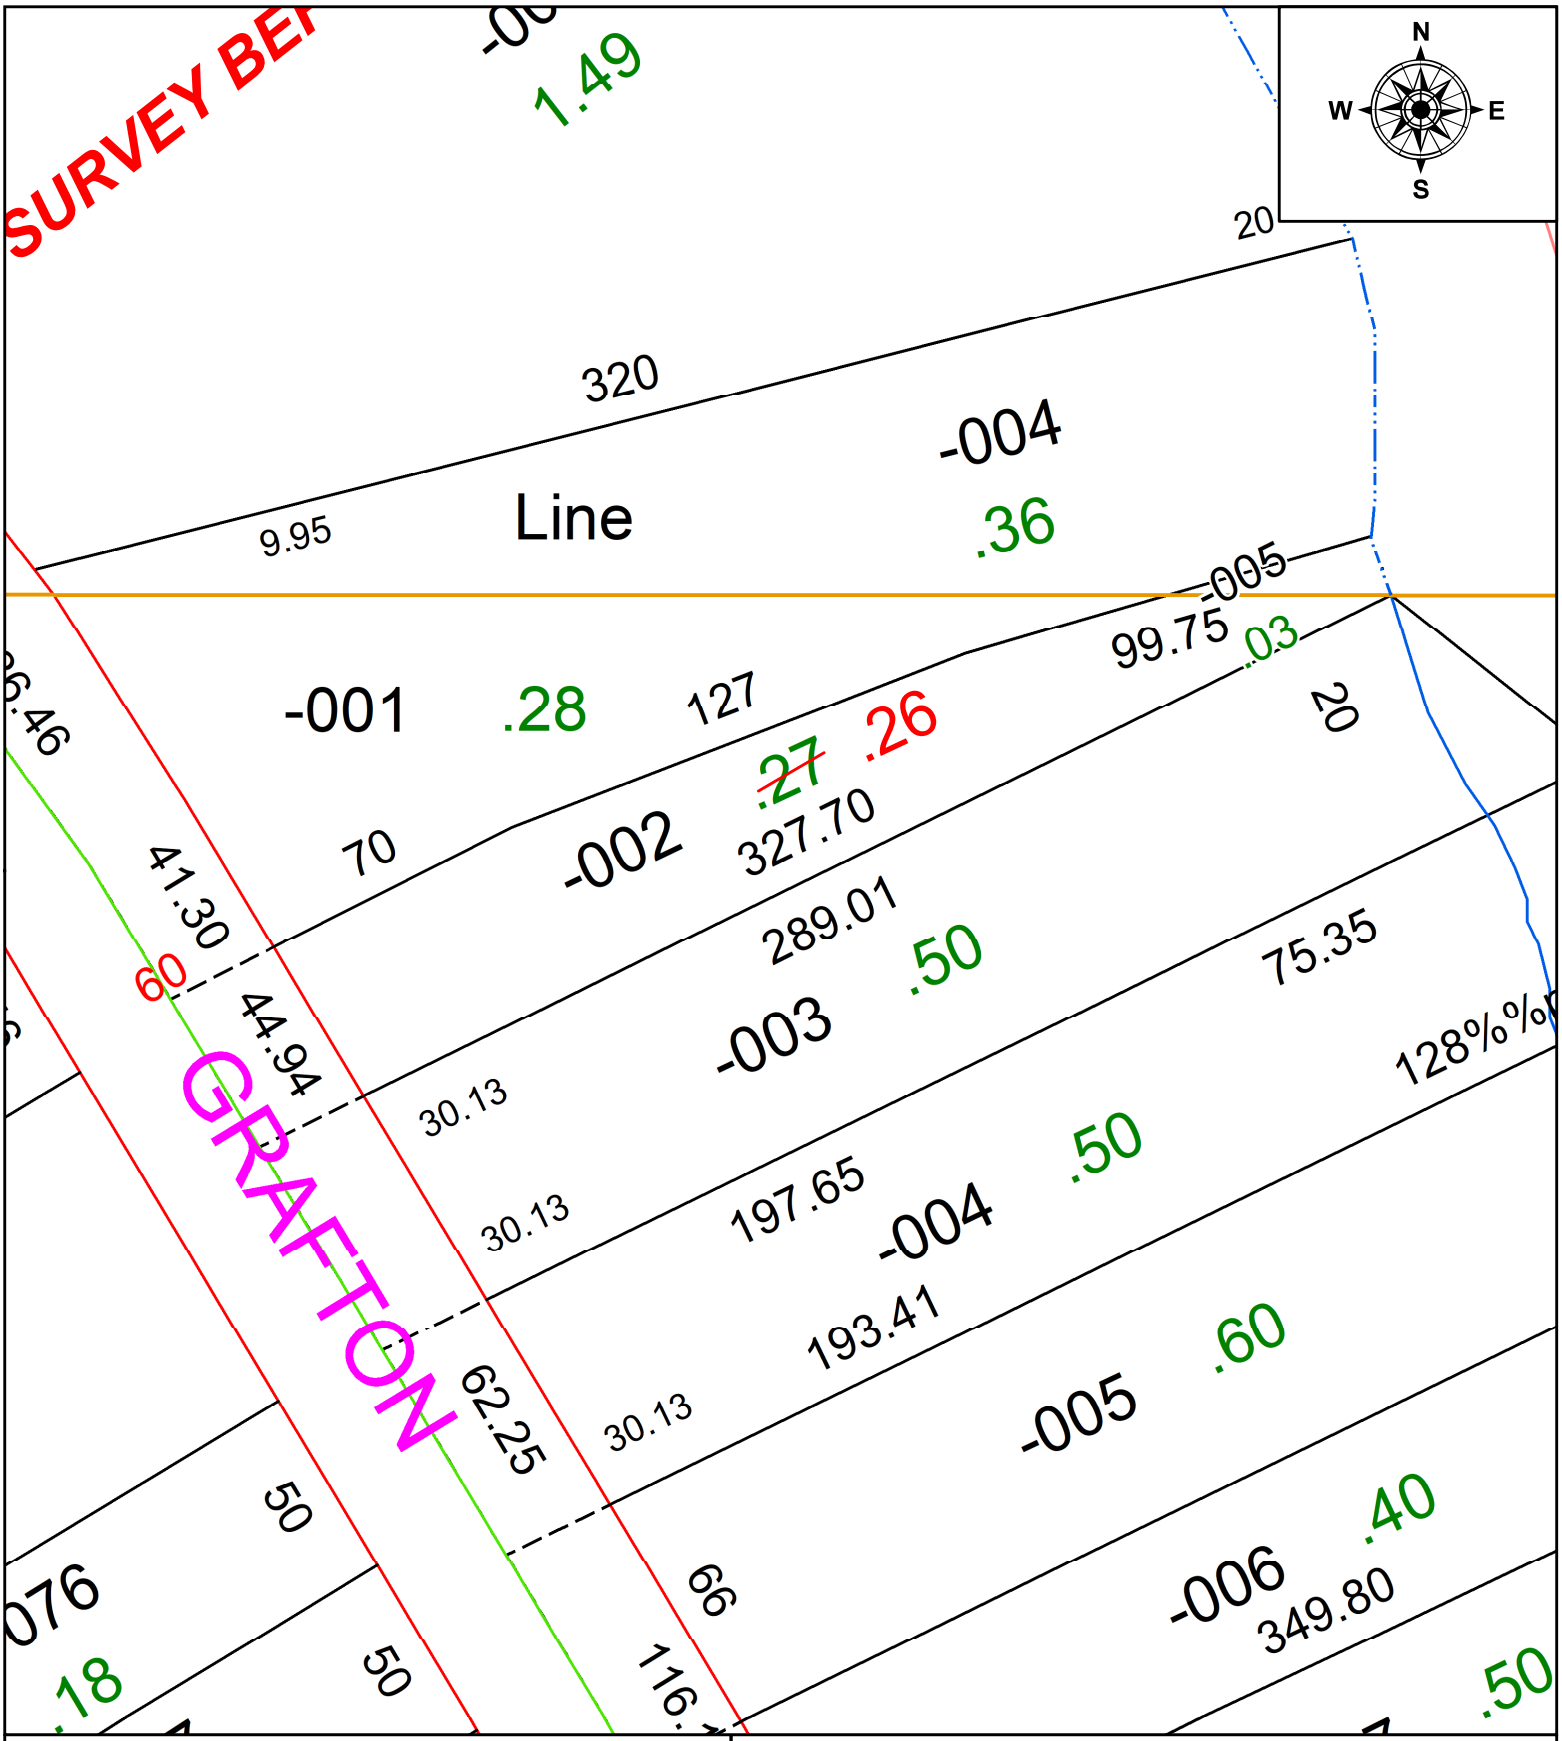

SPLITS/DEEDS PROCESSED

LORAIN COUNTY TAX MAP DEPARTMENT
226 MIDDLE AVE. ELYRIA, OH

SURVEYED BY: N/A **SURV # N/A**

CLOSURE: N/A

MAP PAGE(S): 10-00-004

APPOVED BY: AC **DATE:** February 06, 2023

SCALE: 1 in = 50 ft **PRIOR INSTRUMENT:** 2020- 0794998