PARENT PARCEL: ADD TO DUPLICATE

CHILD PARCEL: 02-01-006-101-009 PER O.R. 664 PG. 850

STARTING POINT: NA

23-05027-A

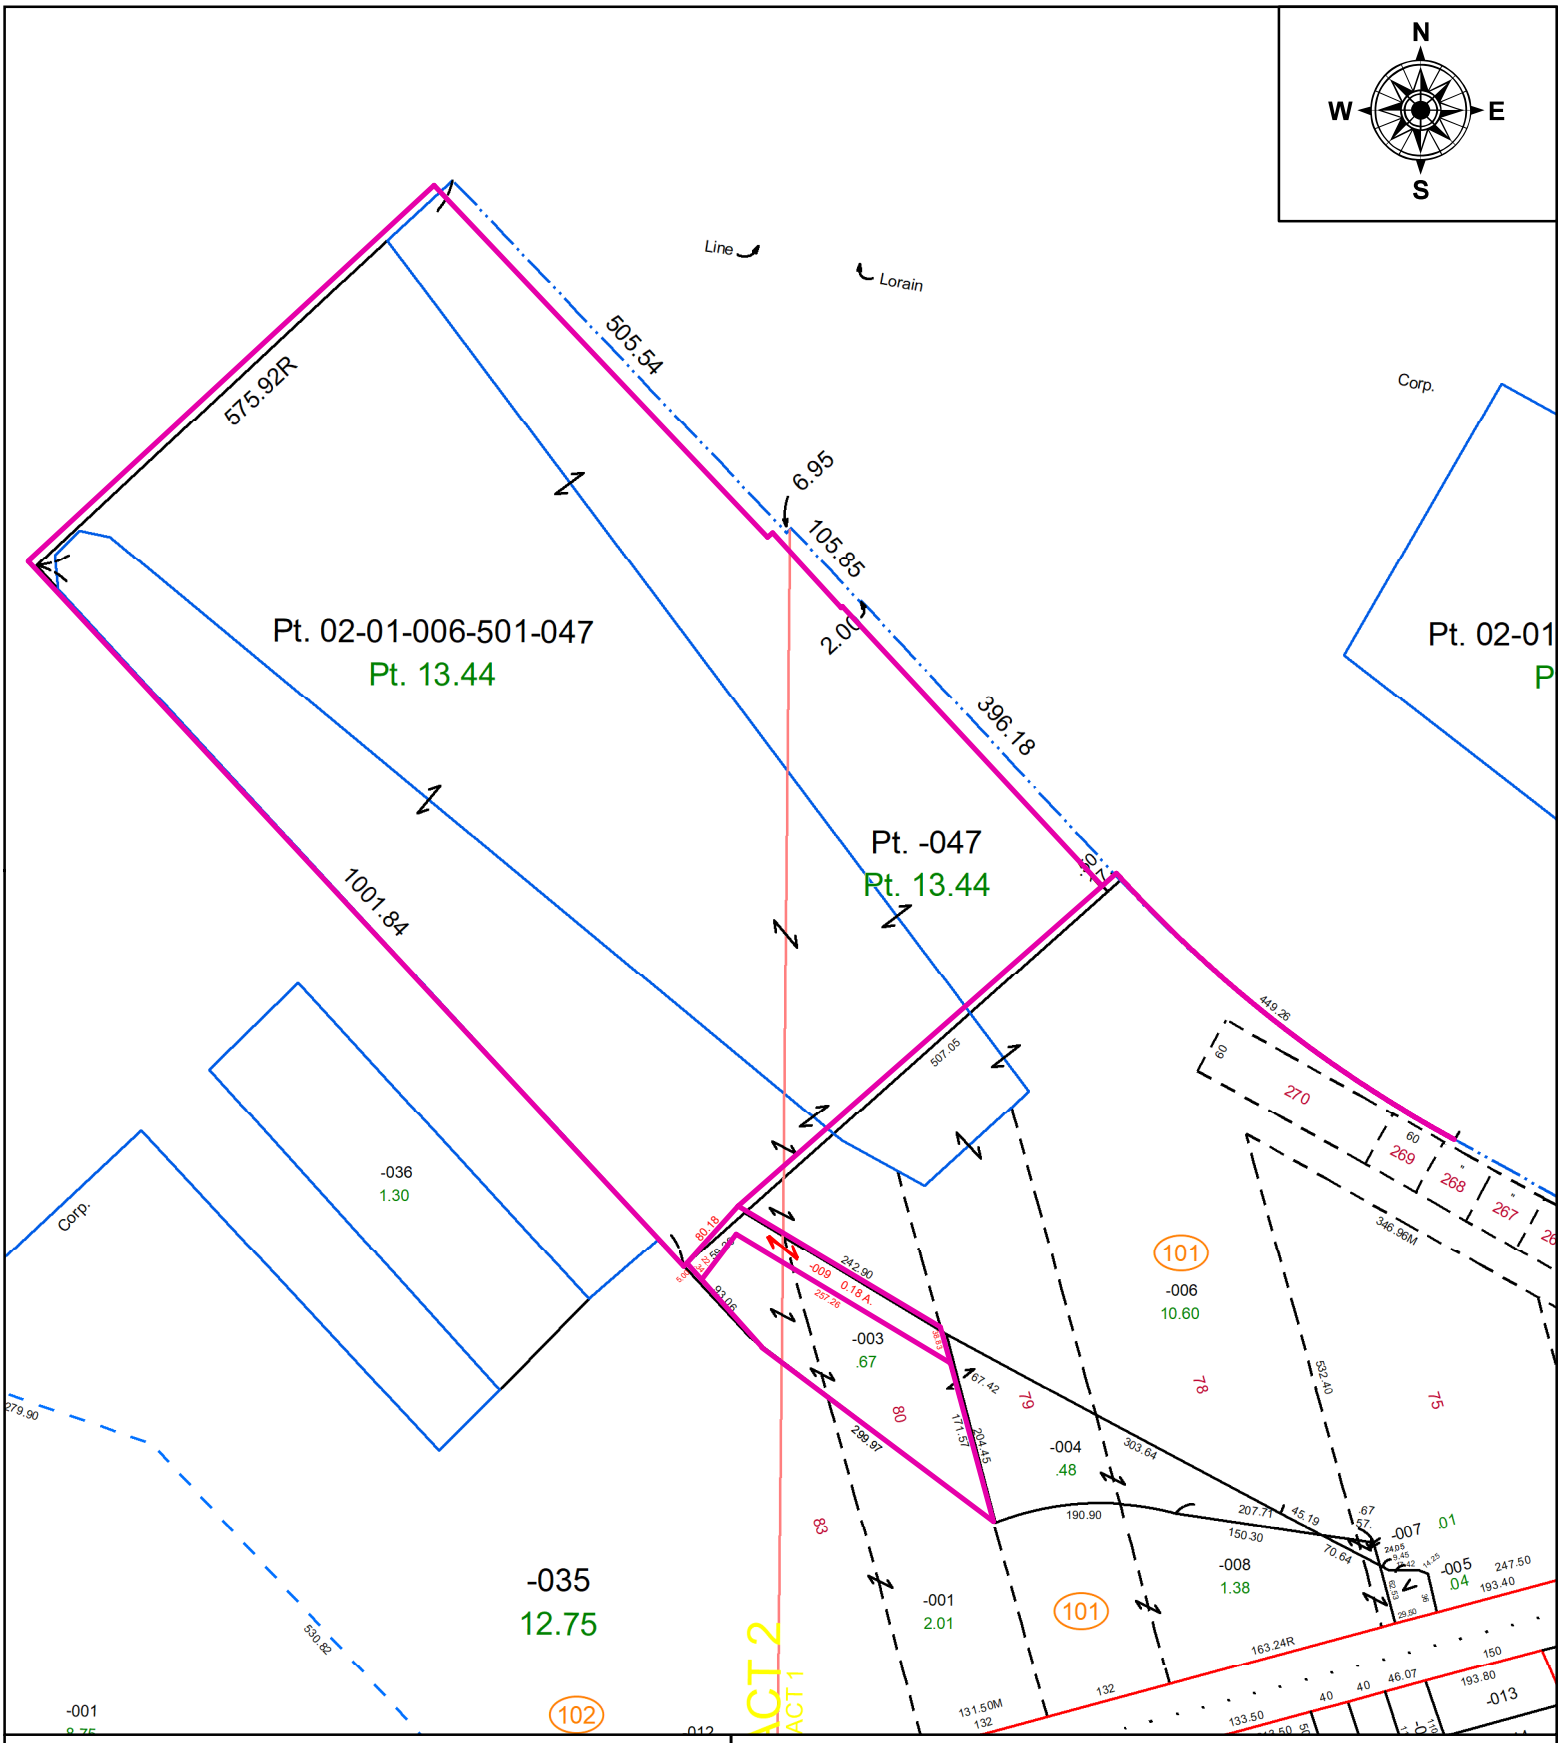

SPLITS/DEEDS PROCESSED

LORAIN COUNTY TAX MAP DEPARTMENT
226 MIDDLE AVE. ELYRIA, OH

SURVEYED BY: CT CONSULTANTS
CLOSURE: 1: INF
MAP PAGE(S): 02-01-006
APPOVED BY: TJS **DATE:** 2/15/2023
SCALE: 1" = 200 **PRIOR INSTRUMENT:** O.R. 664/850