PARENT PARCEL: 05-00-002-000-191 & -193

CHILD PARCEL: 05-00-002-000-195

STARTING POINT: AC CORR PER SURV BY KYLE R. DANALS

23-05033-C

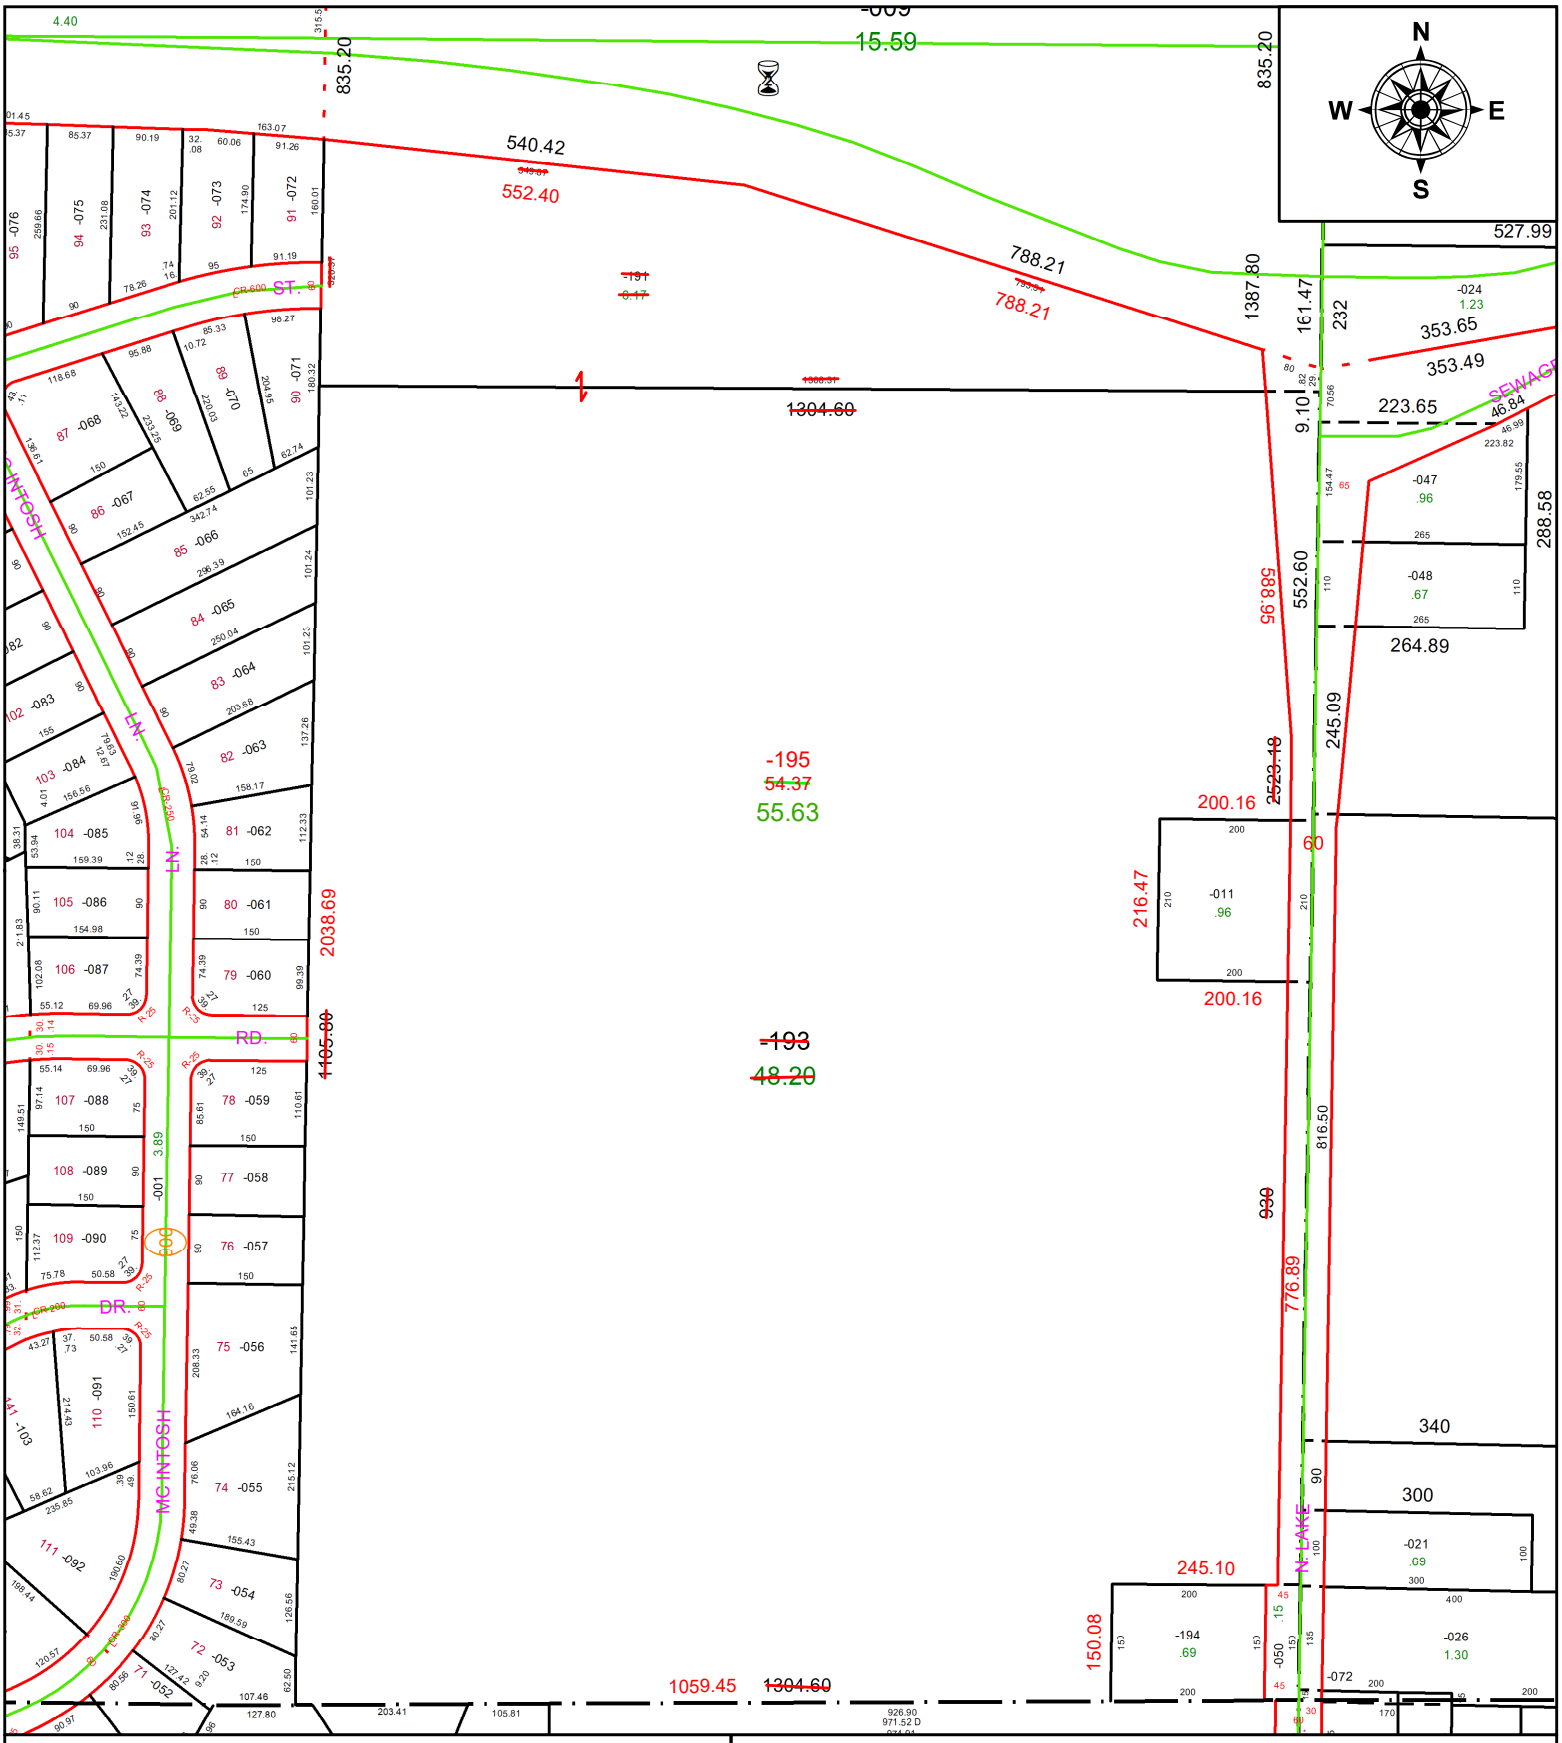

SPLITS/DEEDS PROCESSED

LORAIN COUNTY TAX MAP DEPARTMENT
226 MIDDLE AVE. ELYRIA, OH

SURVEYED BY: KYLE R. DANALS **SURV # 50808**

CLOSURE: 1: 980714

MAP PAGE(S): 05-00-002-B

APPOVED BY: AC **DATE:** February 15, 2023

SCALE: 1 in = 250 ft **PRIOR INSTRUMENT:** 2007- 0187294