PARENT PARCEL: 11-00-063-000-018

CHILD PARCEL: AC CORR PER SURV BY THOMAS A. SIMON

STARTING POINT: NW CORNER OF O/L 63 AND C/L OF CAPEL ROAD

23-05034-A

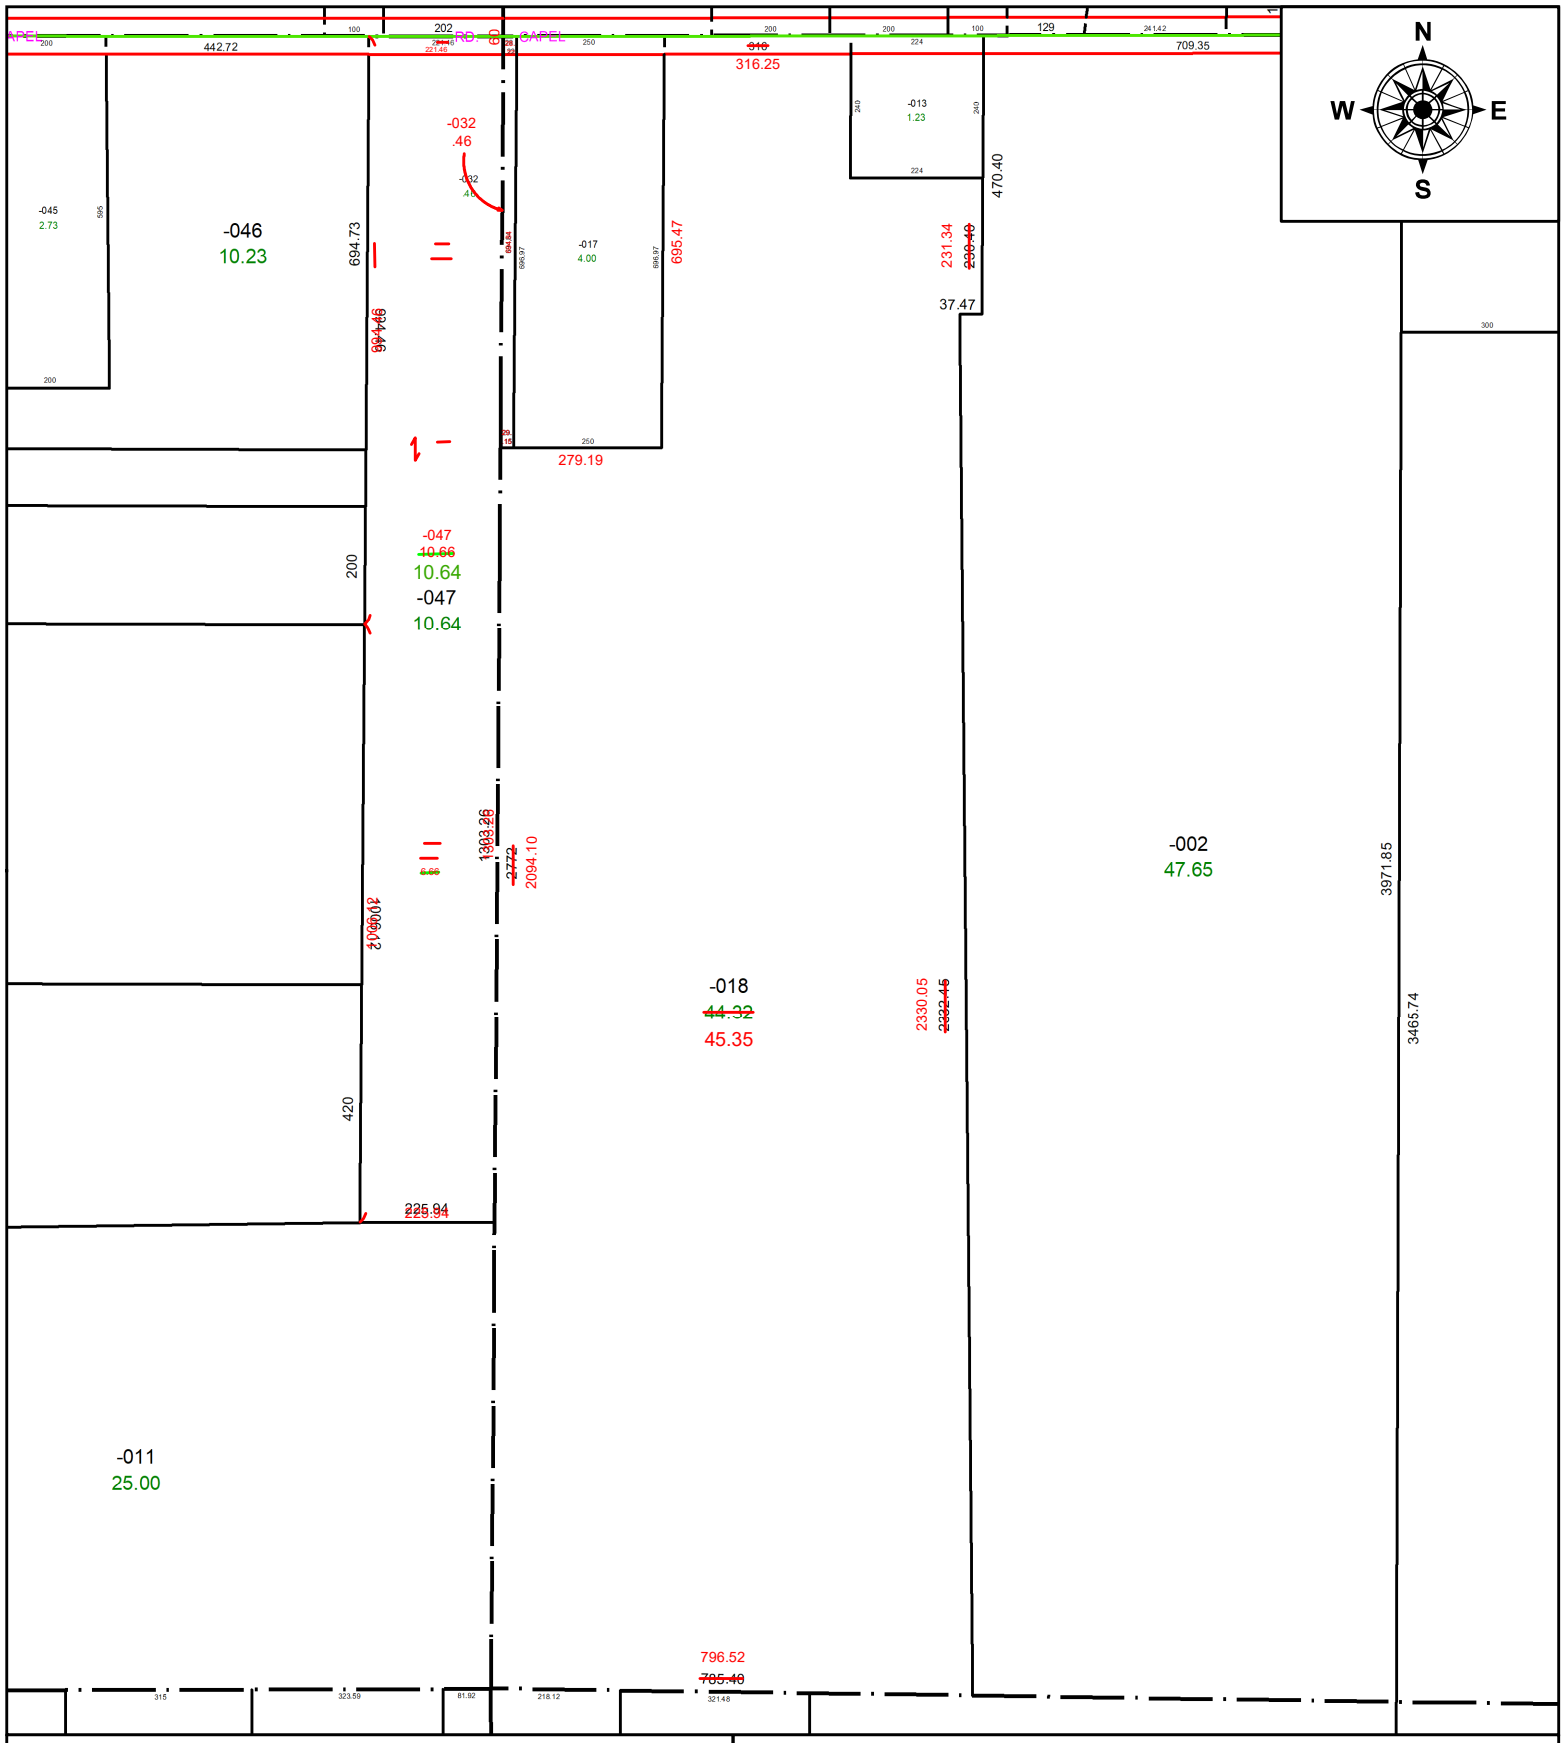

SPLITS/DEEDS PROCESSED

LORAIN COUNTY TAX MAP DEPARTMENT
226 MIDDLE AVE. ELYRIA, OH

SURVEYED BY: THOMAS A. SIMON **SURV # 50811**

CLOSURE: 1: 349594

MAP PAGE(S): 11-00-063-A

APPOVED BY: AC **DATE:** February 16, 2023

SCALE: 1 in = 325 ft **PRIOR INSTRUMENT:** 2009- 0317881