PARENT PARCEL: 05-00-037-115-032, -033, & -048

CHILD PARCEL: 05-00-037-115-051, -052, -053, & 05-00-036-104-050

STARTING POINT: MON. BOX, CL OF JACKSON ST & FRANKLIN AVE

25-05047

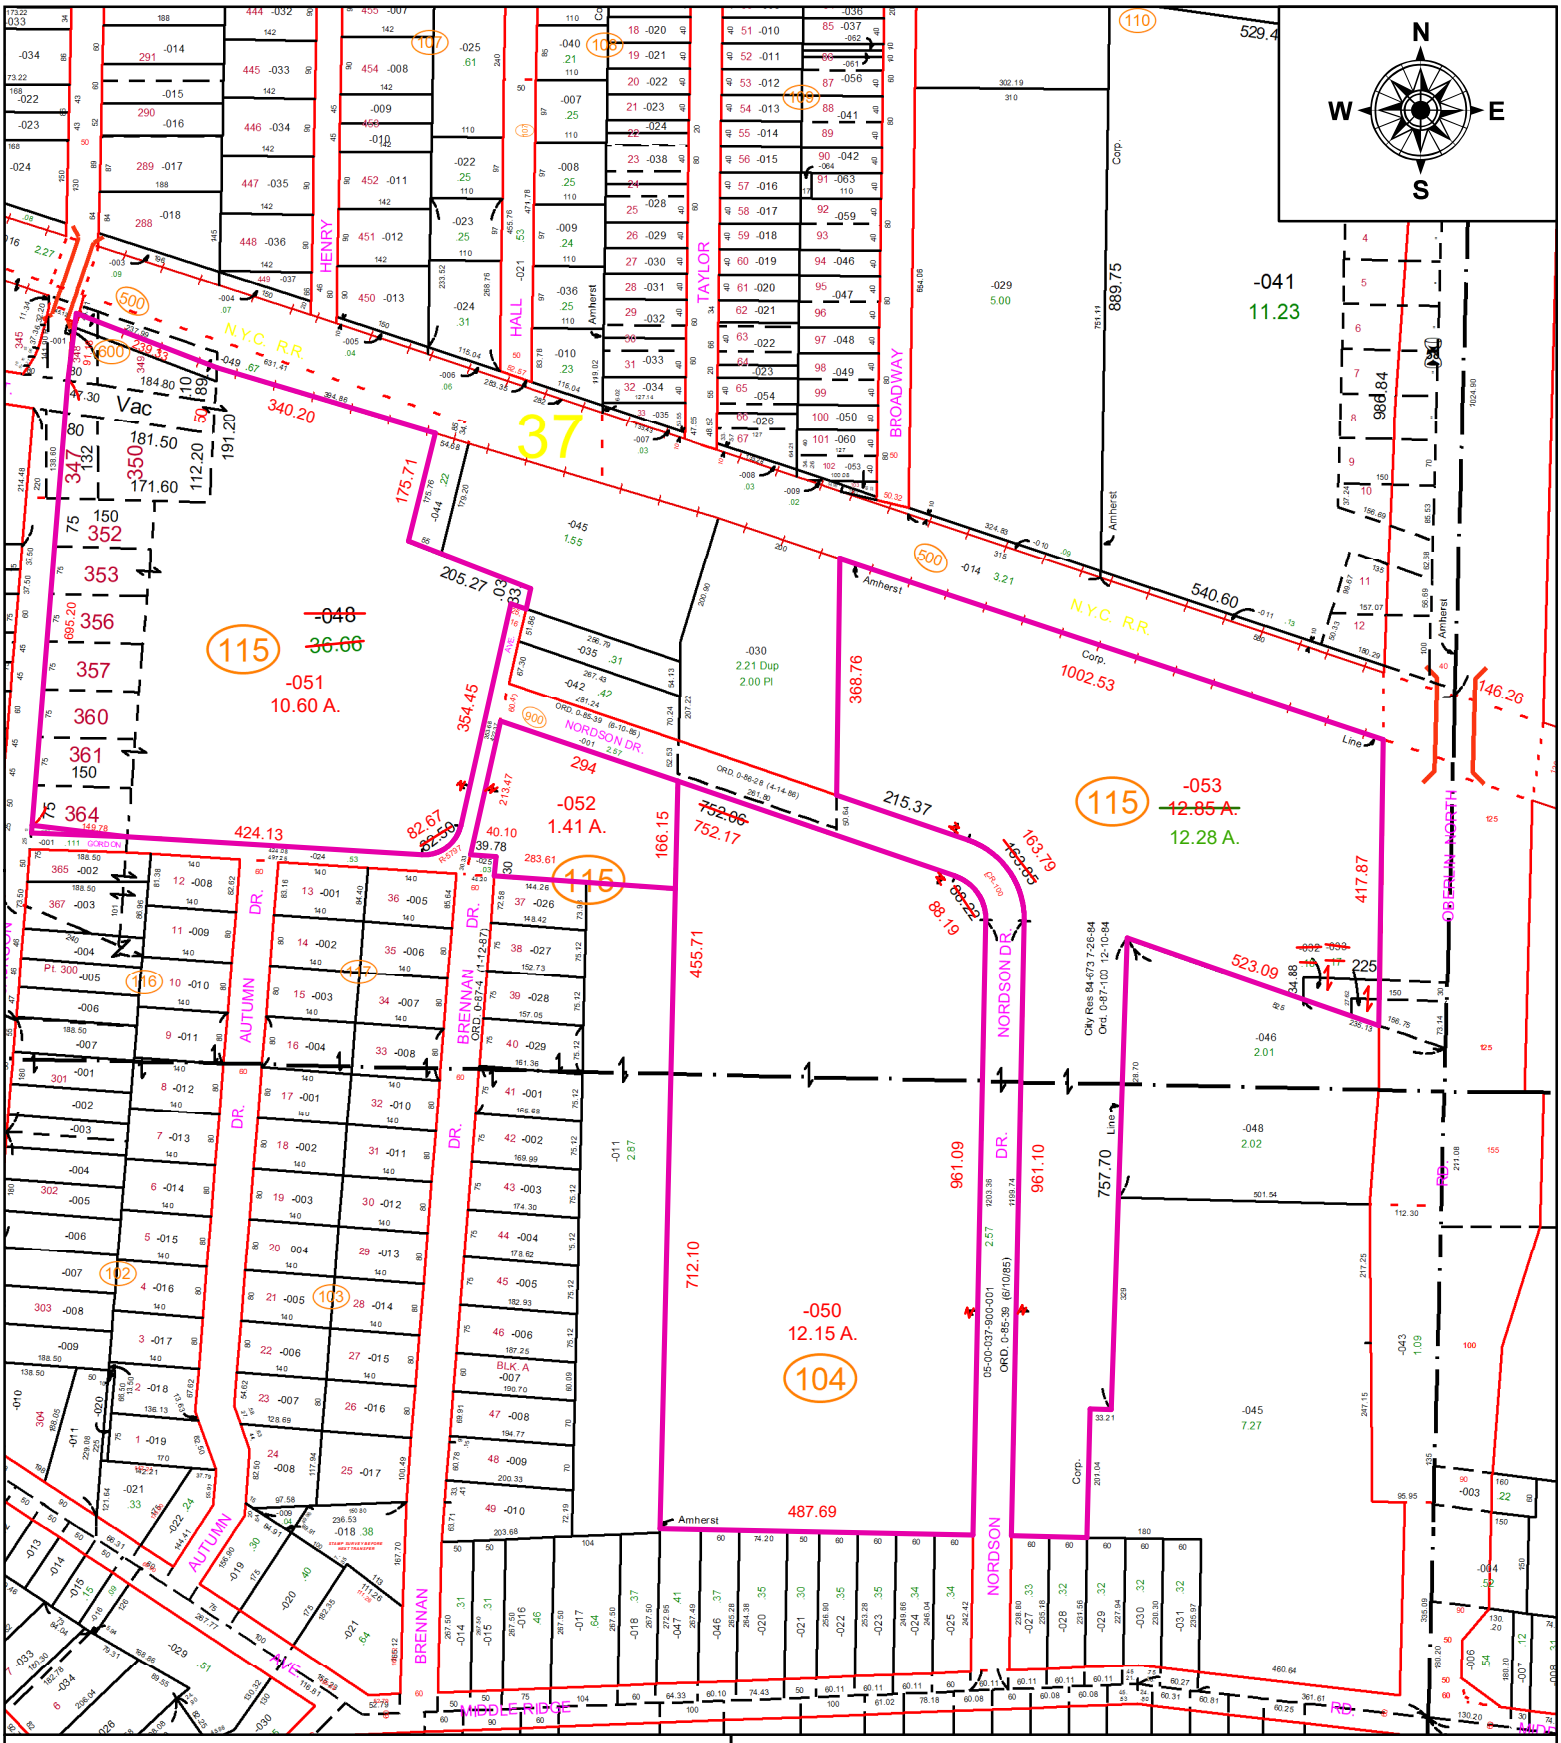

SPLITS/DEEDS PROCESSED

LORAIN COUNTY TAX MAP DEPARTMENT
226 MIDDLE AVE. ELYRIA, OH

SURVEYED BY: AMY KELLY
CLOSURE: 1: 467860
MAP PAGE(S): 05-00-037
APPOVED BY: TJS **DATE:** 8/8/2025
SCALE: 1" = 300' **PRIOR INSTRUMENT:** DV 115/496