PARENT PARCEL: 04-00-002-103-055 & -056

CHILD PARCEL: 04-00-002-103-084, -085, & -086

STARTING POINT: MON. BOX @ INTERSECTION OF MOON RD & DETROIT RD

25-05048

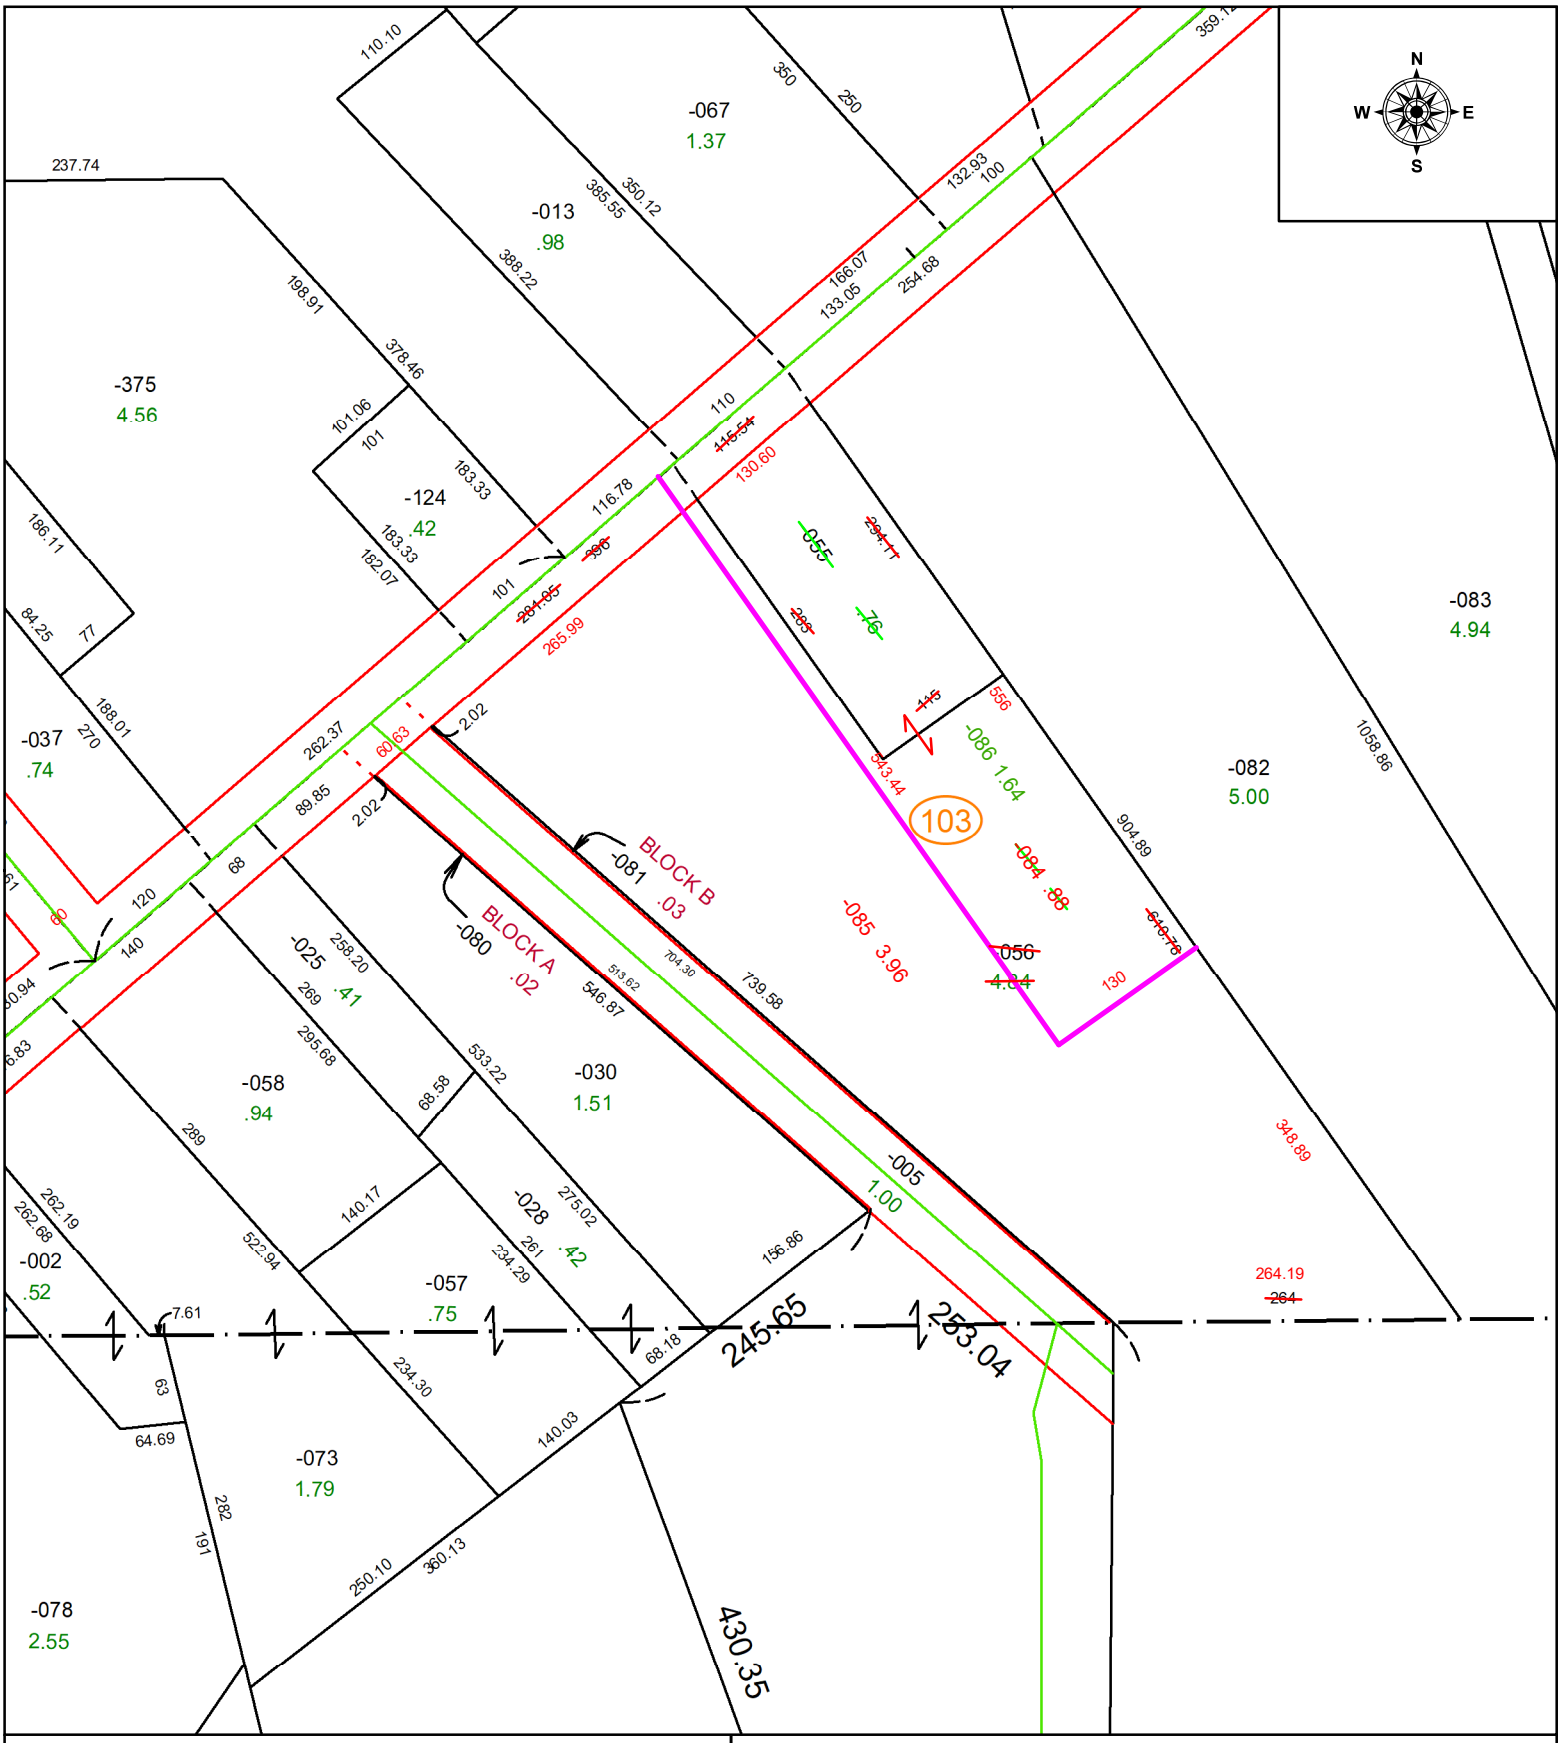

SPLITS/DEEDS PROCESSED

LORAIN COUNTY TAX MAP DEPARTMENT
226 MIDDLE AVE. ELYRIA, OH

SURVEY # 51519

SURVEYED BY: SUSAN EICHHORN

CLOSURE: 1: 135662

MAP PAGE(S): 04-00-002

APPOVED BY: WRZ **DATE:** 8/15/2025

SCALE: 1" = 150 **PRIOR INSTRUMENT:** #2001-728416