PARENT PARCEL: 03-00-035-101-028

CHILD PARCEL: AC CORR PER PRIOR DEED INSTRUMENT NO. 2001- 0736219

STARTING POINT: C/L OF LAKE RD AND BUCKEYE DR

23-05049-A

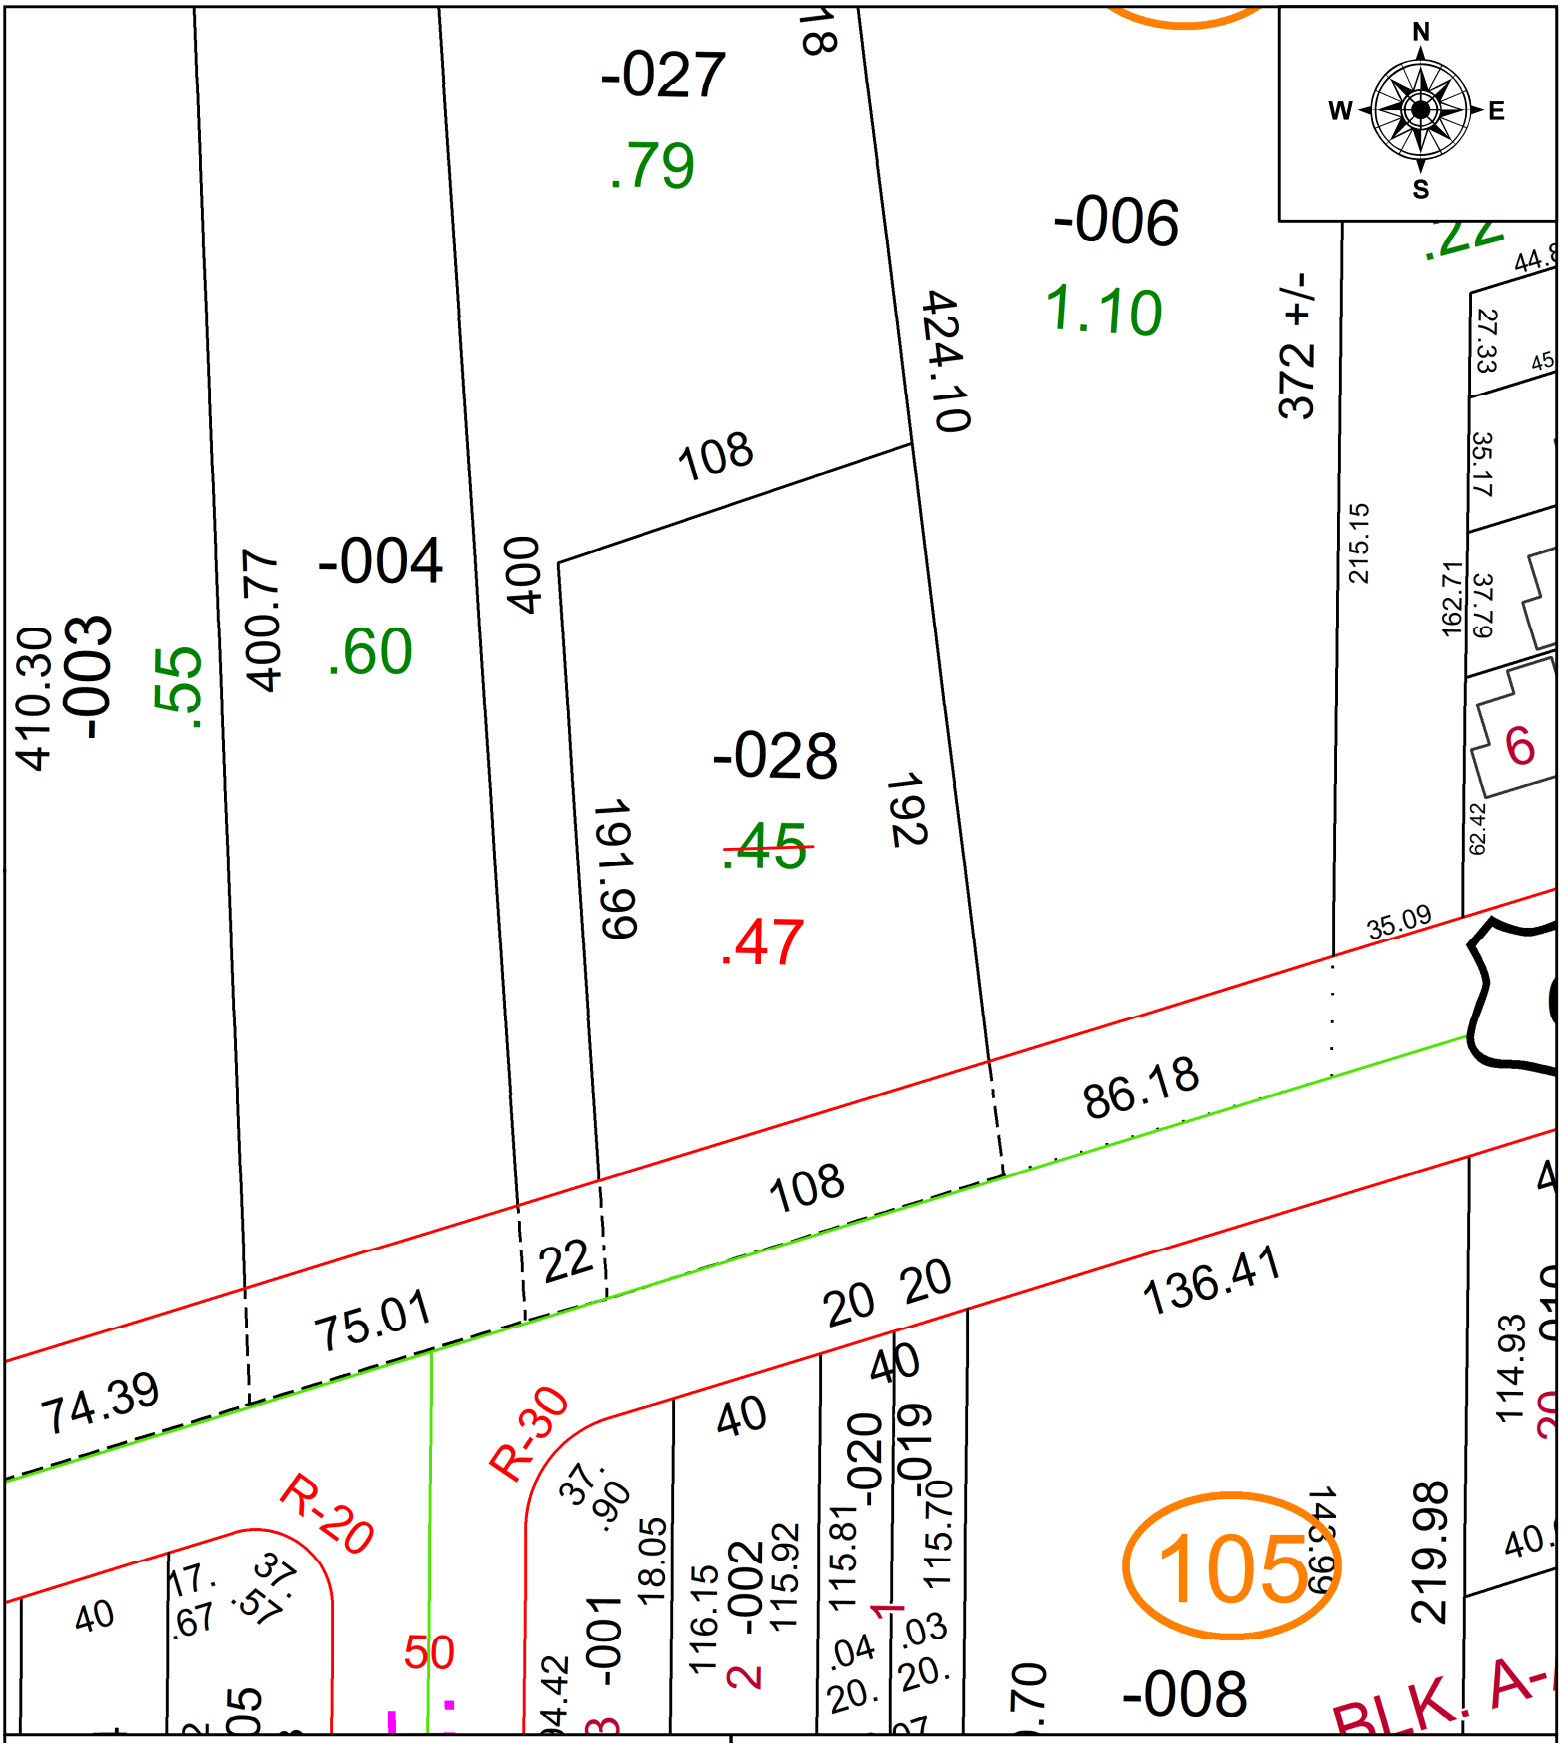

SPLITS/DEEDS PROCESSED

LORAIN COUNTY TAX MAP DEPARTMENT
226 MIDDLE AVE. ELYRIA, OH

SURVEYED BY: N/A **SURV # N/A**

CLOSURE: N/A

MAP PAGE(S): 03-00-035

APPOVED BY: AC **DATE:** March 13, 2023

SCALE: 1 in = 50 ft **PRIOR INSTRUMENT:** 2001- 0736219