PARENT PARCEL: 10-00-009-125-010 THRU -015, -022 THRU -027, & 10-00-009-129-034

CHILD PARCEL: 10-00-009-125-053, -054, & -055

STARTING POINT: NORTHWESTERLY CORNER OF S/L 136 IN CARLISLE ESTATES NO. 2 PV 13/2

25-05052

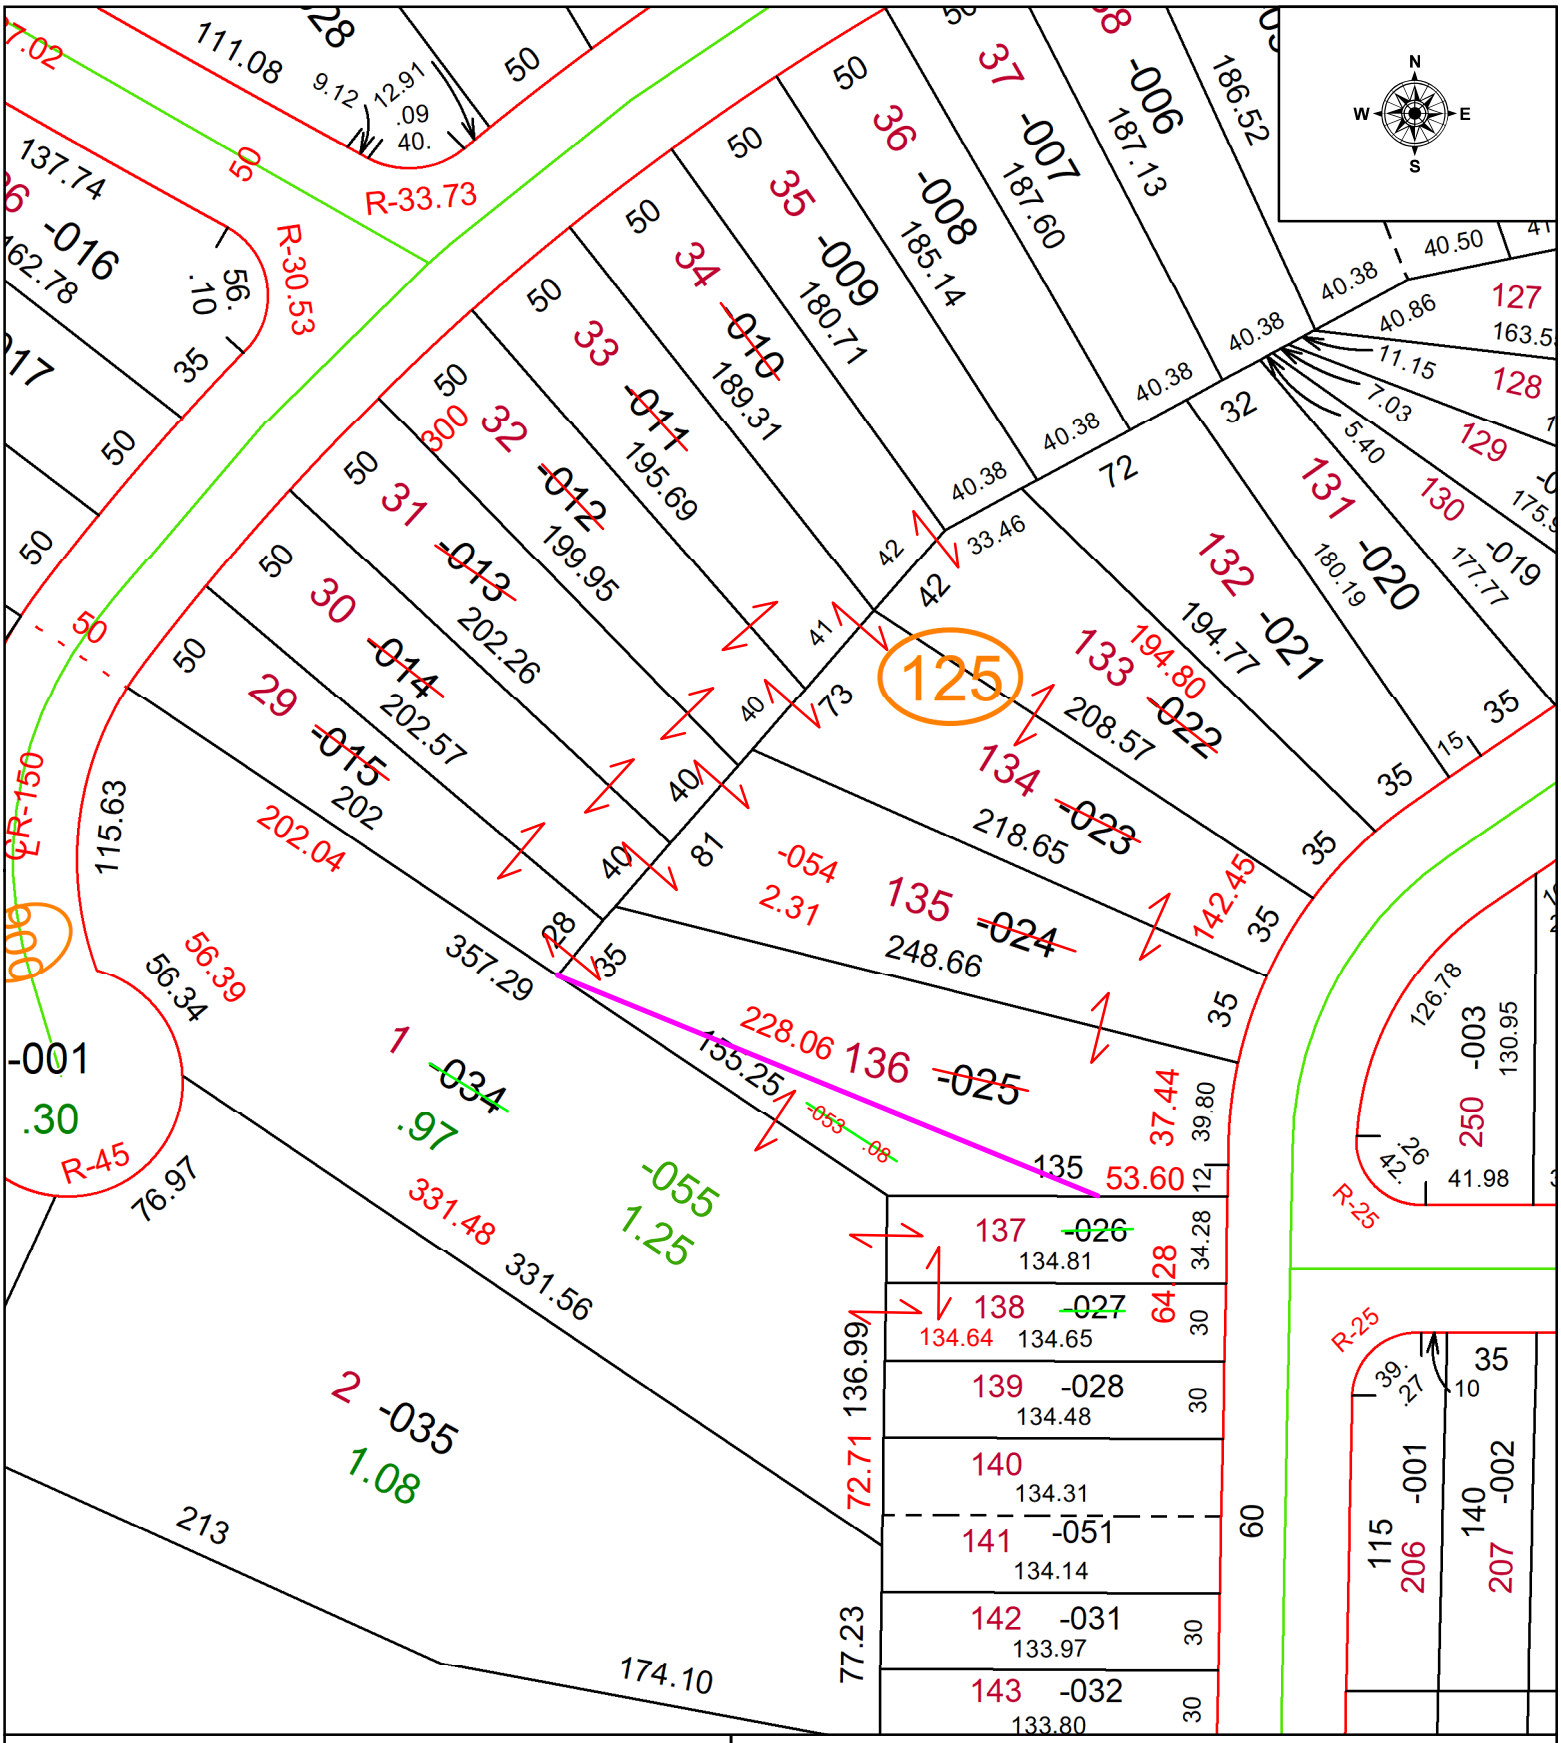

SPLITS/DEEDS PROCESSED

LORAIN COUNTY TAX MAP DEPARTMENT
226 MIDDLE AVE. ELYRIA, OH

SURVEYED BY: JOHN DECHANT JR. SURVEY # 51522

CLOSURE: 1: 140255

MAP PAGE(S): 10-00-009

APPOVED BY: WRZ **DATE:** 8/19/2025

SCALE: 1" = 75 **PRIOR INSTRUMENT:** #2006-0125461