PARENT PARCEL: 11-00-057-000-048 AC CORR PER SURVEYOR THOMAS SNEZEK

CHILD PARCEL: 11-00-057-000-080 & -081

STARTING POINT: INTERSECTION OF C/L CAPEL RD & SOUTHWESTERLY CORNER OF O.L. 57

25-05054

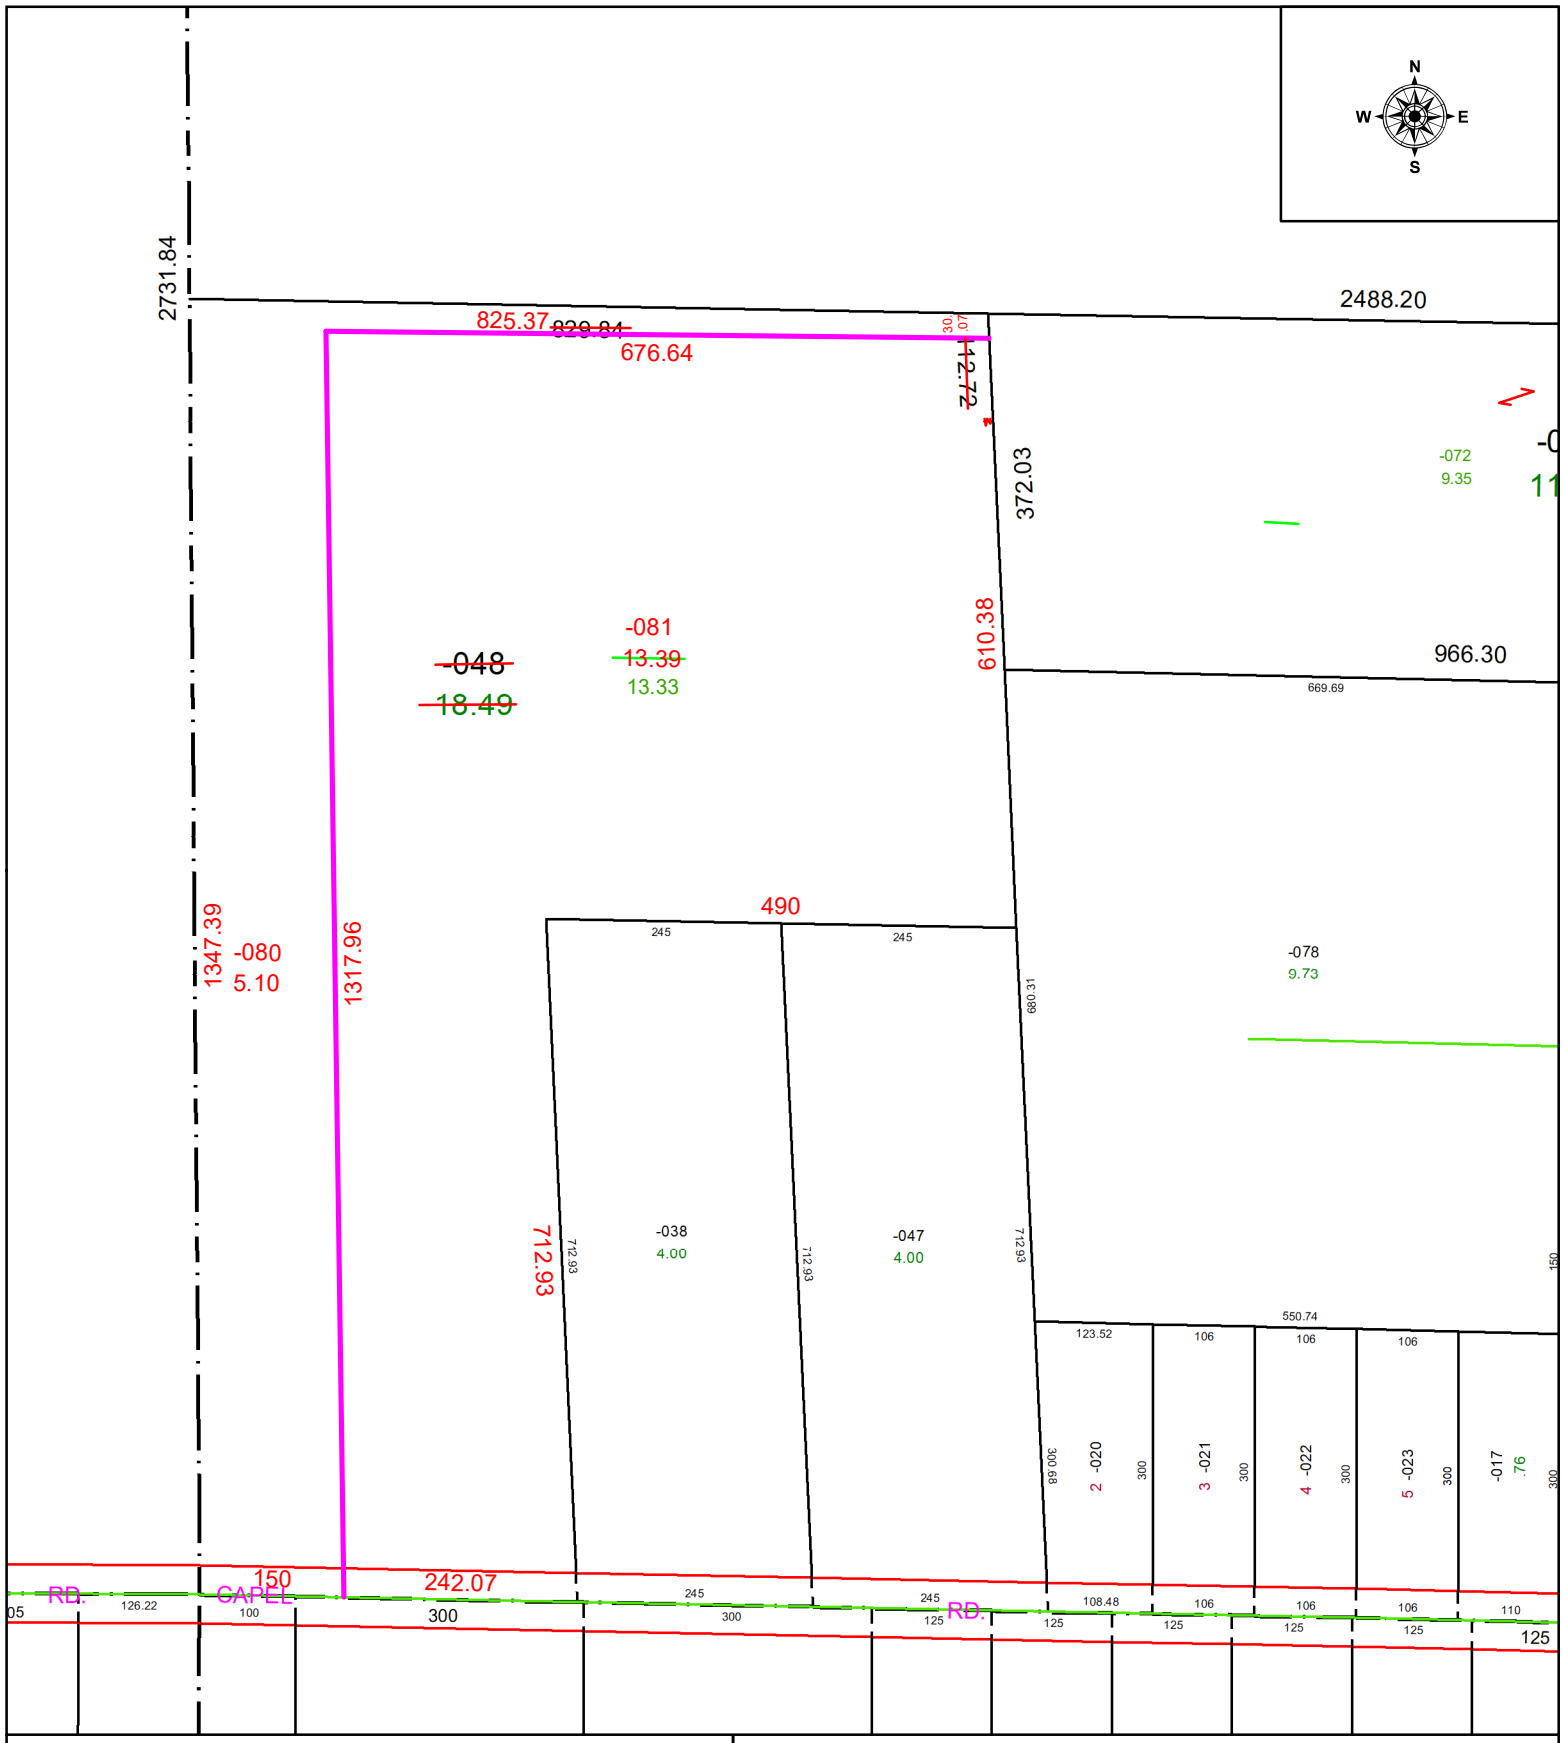

SPLITS/DEEDS PROCESSED

LORAIN COUNTY TAX MAP DEPARTMENT
226 MIDDLE AVE. ELYRIA, OH

SURVEYED BY: THOMAS SNEZEK SURVEY # 51527

CLOSURE: 1: 808634

MAP PAGE(S): 11-00-057

APPOVED BY: WRZ **DATE:** 8/21/2025

SCALE: 1" = 200 **PRIOR INSTRUMENT:** #2004-0992467