PARENT PARCEL: N/A

CHILD PARCEL: 02-02-003-900-005 ADD TO DUPLICATE PER PLAT VOL. 18 PG. 17

STARTING POINT: N/A

23-05057-A

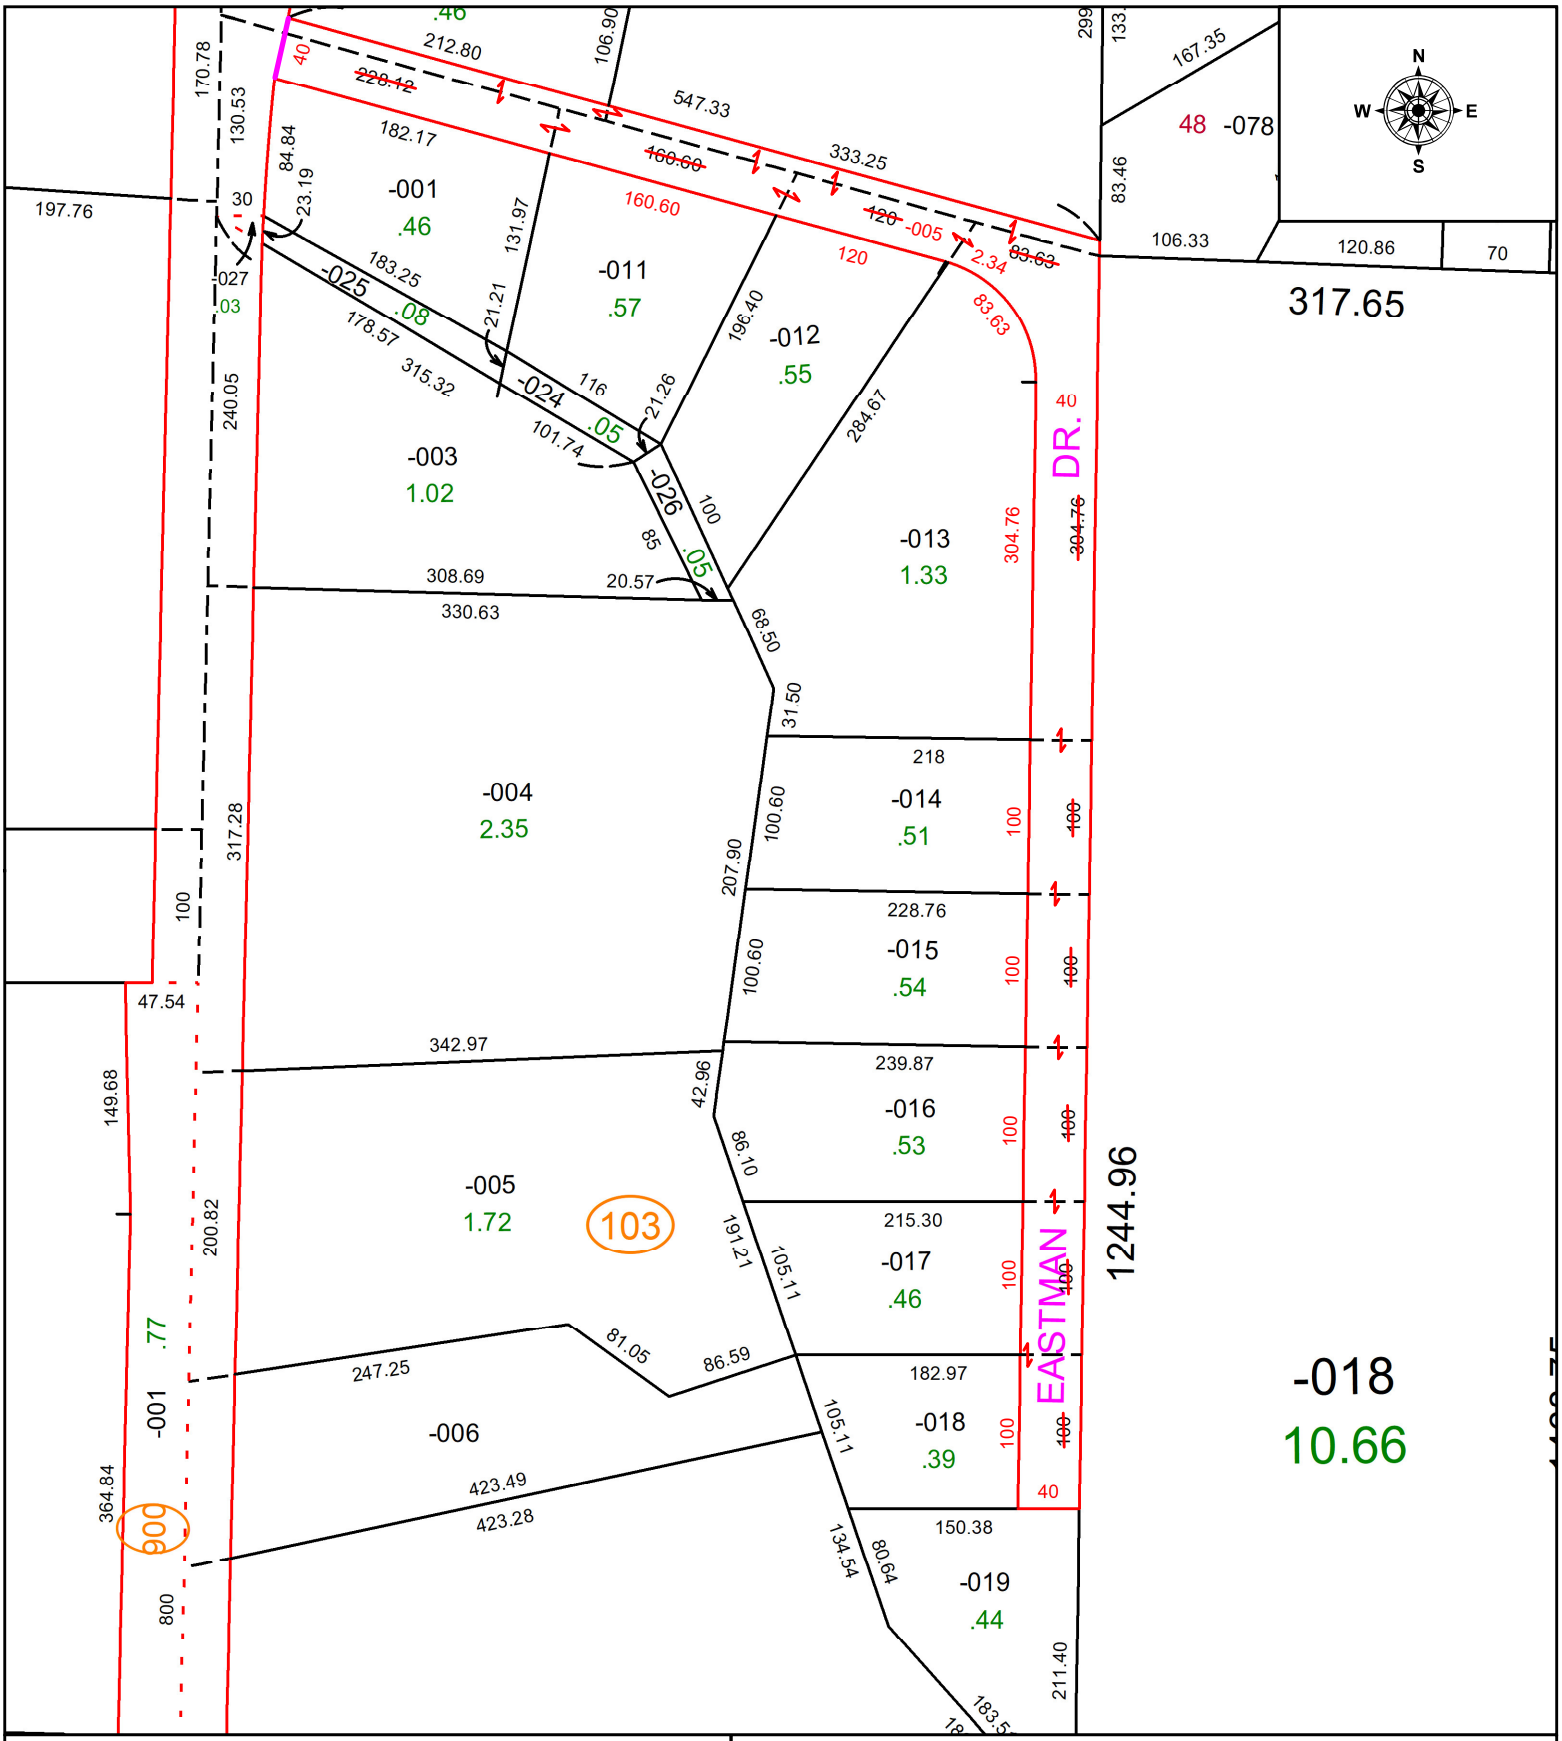

SPLITS/DEEDS PROCESSED

LORAIN COUNTY TAX MAP DEPARTMENT
226 MIDDLE AVE. ELYRIA, OH

SURVEYED BY: RAY HOLLIS SURVEY # N/A

CLOSURE: 1: N/A

MAP PAGE(S): 02-02-003

APPOVED BY: WRZ **DATE:** 3/30/2023

SCALE: 1" = 125 **PRIOR INSTRUMENT:** PLAT V 18 PG 17