PARENT PARCEL: 18-00-016-000-032 & -050

CHILD PARCEL: 18-00-016-000-072

STARTING POINT: C/L OF HAWLEY RD AND SR 18

25-05057

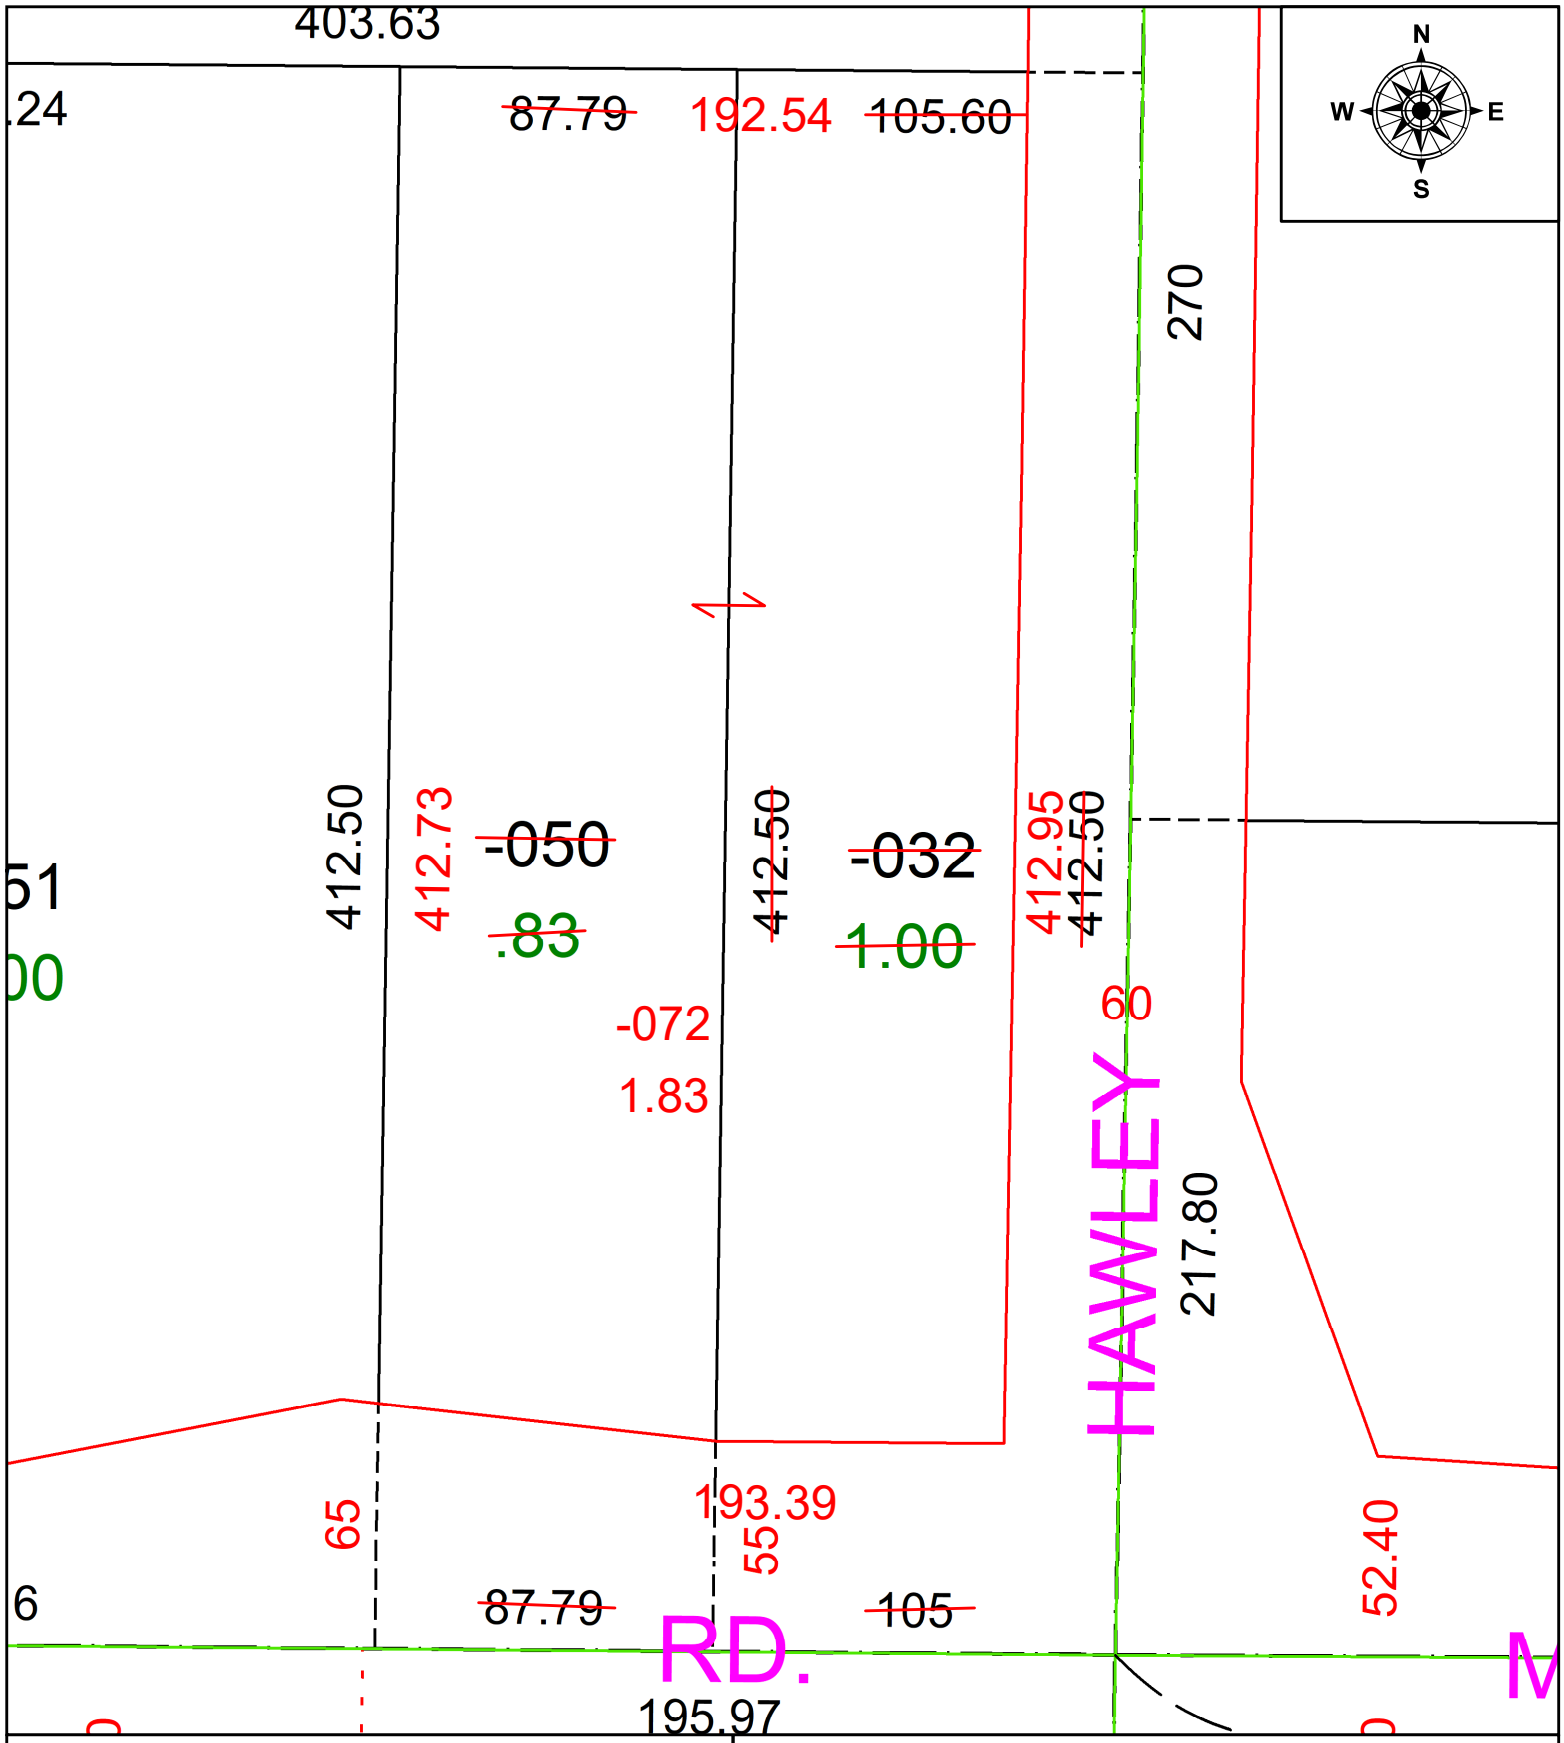

SPLITS/DEEDS PROCESSED

LORAIN COUNTY TAX MAP DEPARTMENT
226 MIDDLE AVE. ELYRIA, OH

SURVEYED BY: THOMAS A. SIMON **SURV # 51532**

CLOSURE: 1: 933254

MAP PAGE(S): 18-00-016

APPOVED BY: AC **DATE:** September 02, 2025

SCALE: 1 in = 50 ft **PRIOR INSTRUMENT:** 1987- 0256667