PARENT PARCEL: 06-22-012-102-003
CHILD PARCEL: AC. CORR. PER PRIOR INSTR. # 2015-0541509
STARTING POINT: N/A

23-05058-A

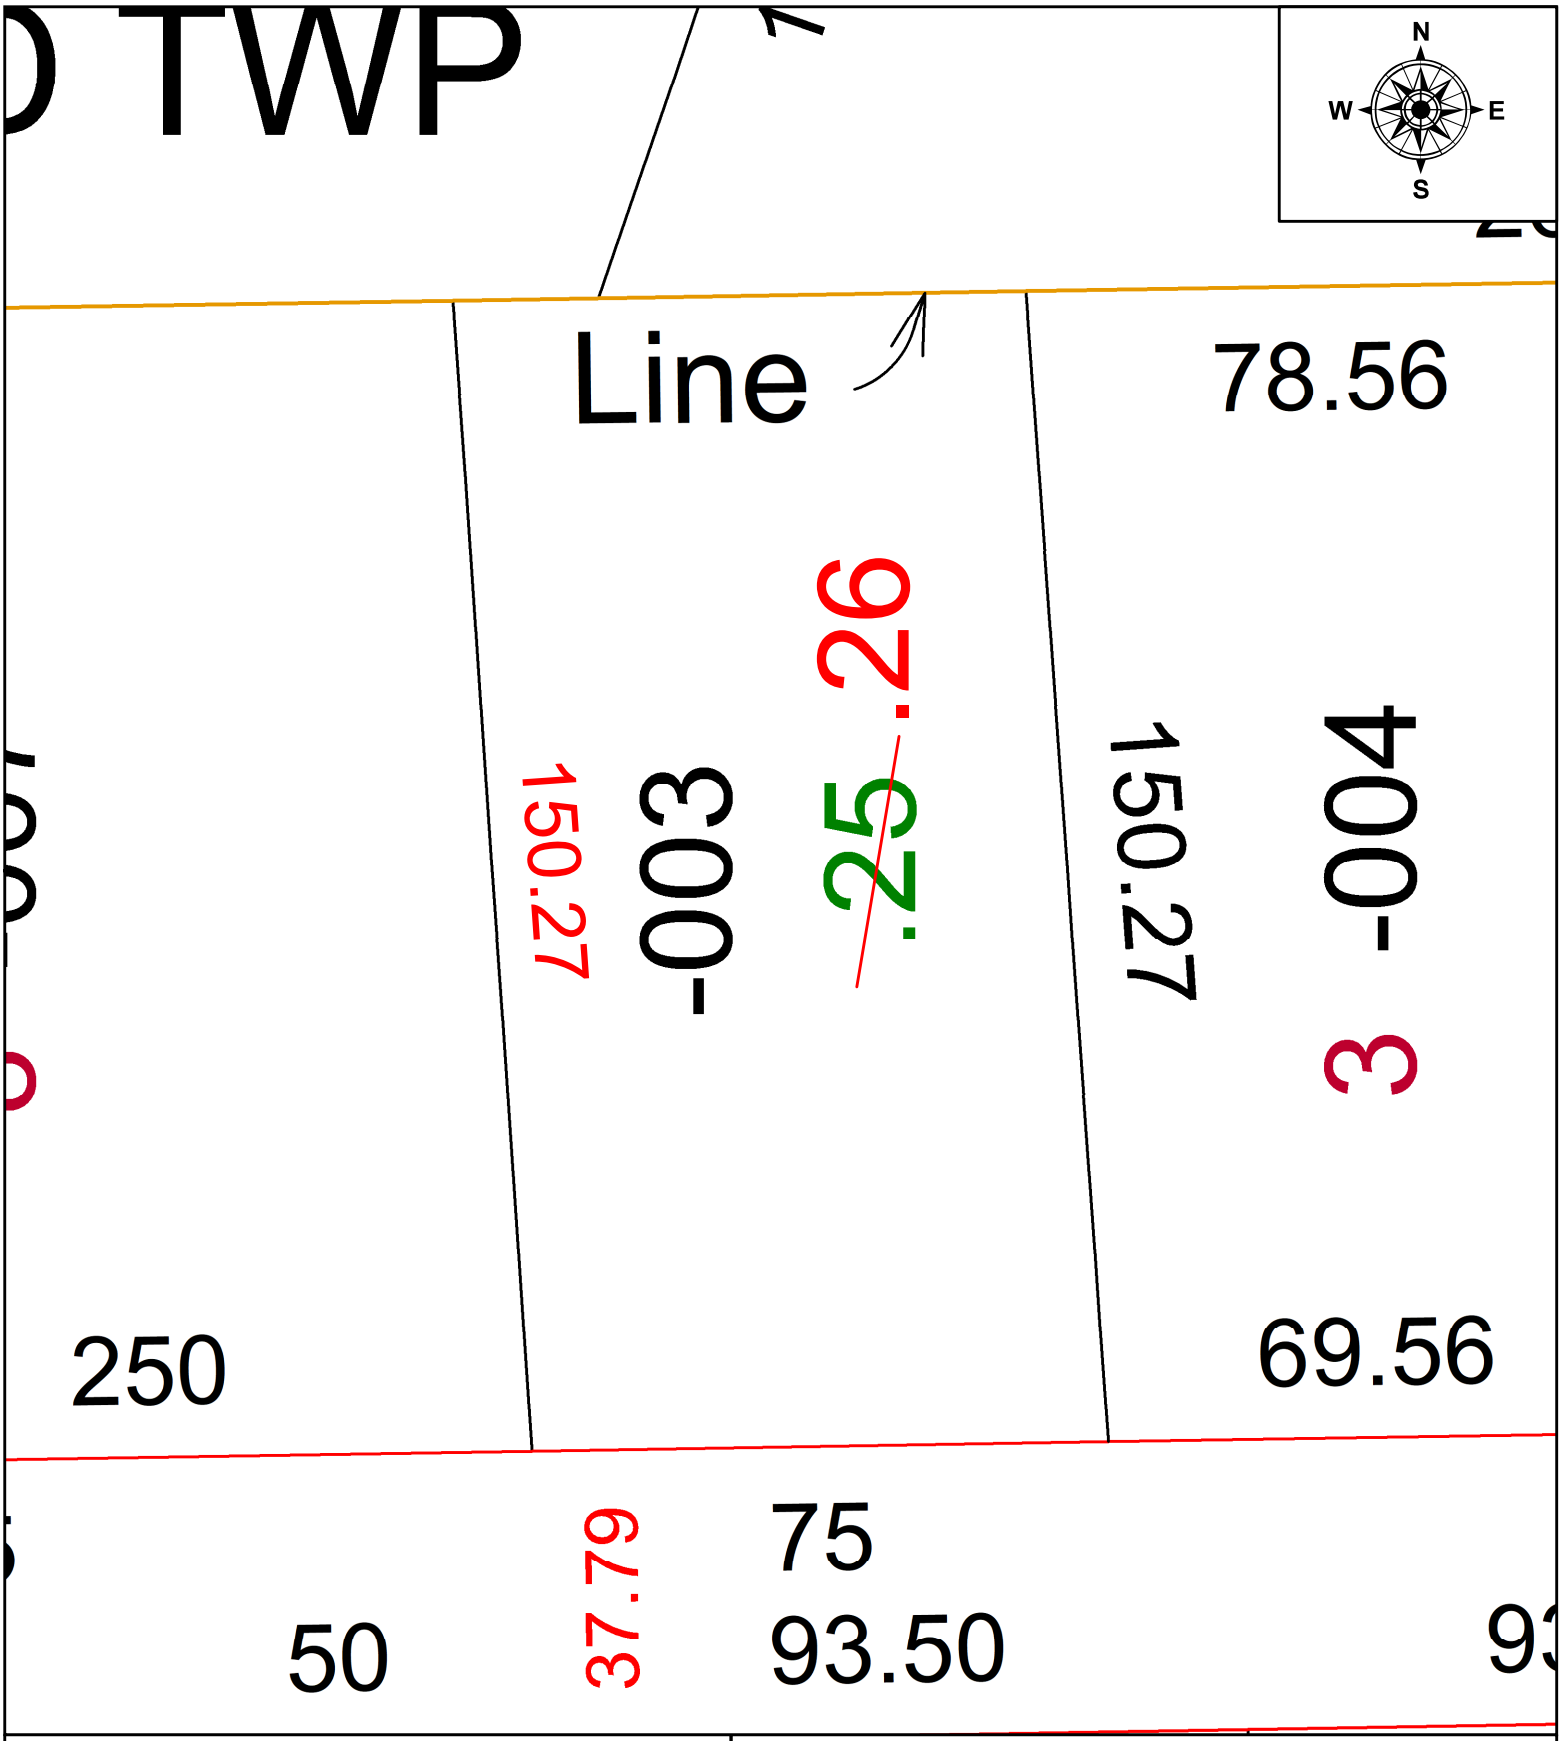

SPLITS/DEEDS PROCESSED
LORAIN COUNTY TAX MAP DEPARTMENT
226 MIDDLE AVE. ELYRIA, OH

SURVEYED BY: N/A **SURVEY #:** N/A
CLOSURE: N/A
MAP PAGE(S): 06-22-012
APPOVED BY: DMA **DATE:** 3/30/2023
SCALE: 1" = 25' **PRIOR INSTRUMENT:** 2015-0541509