PARENT PARCEL: 06-24-040-102-001, -038, & -039

CHILD PARCEL: 06-24-040-102-045

STARTING POINT: SW CORNER OF O/L 40 **AC CORR PER SURV BY THOMAS A. SIMON**

25-05059

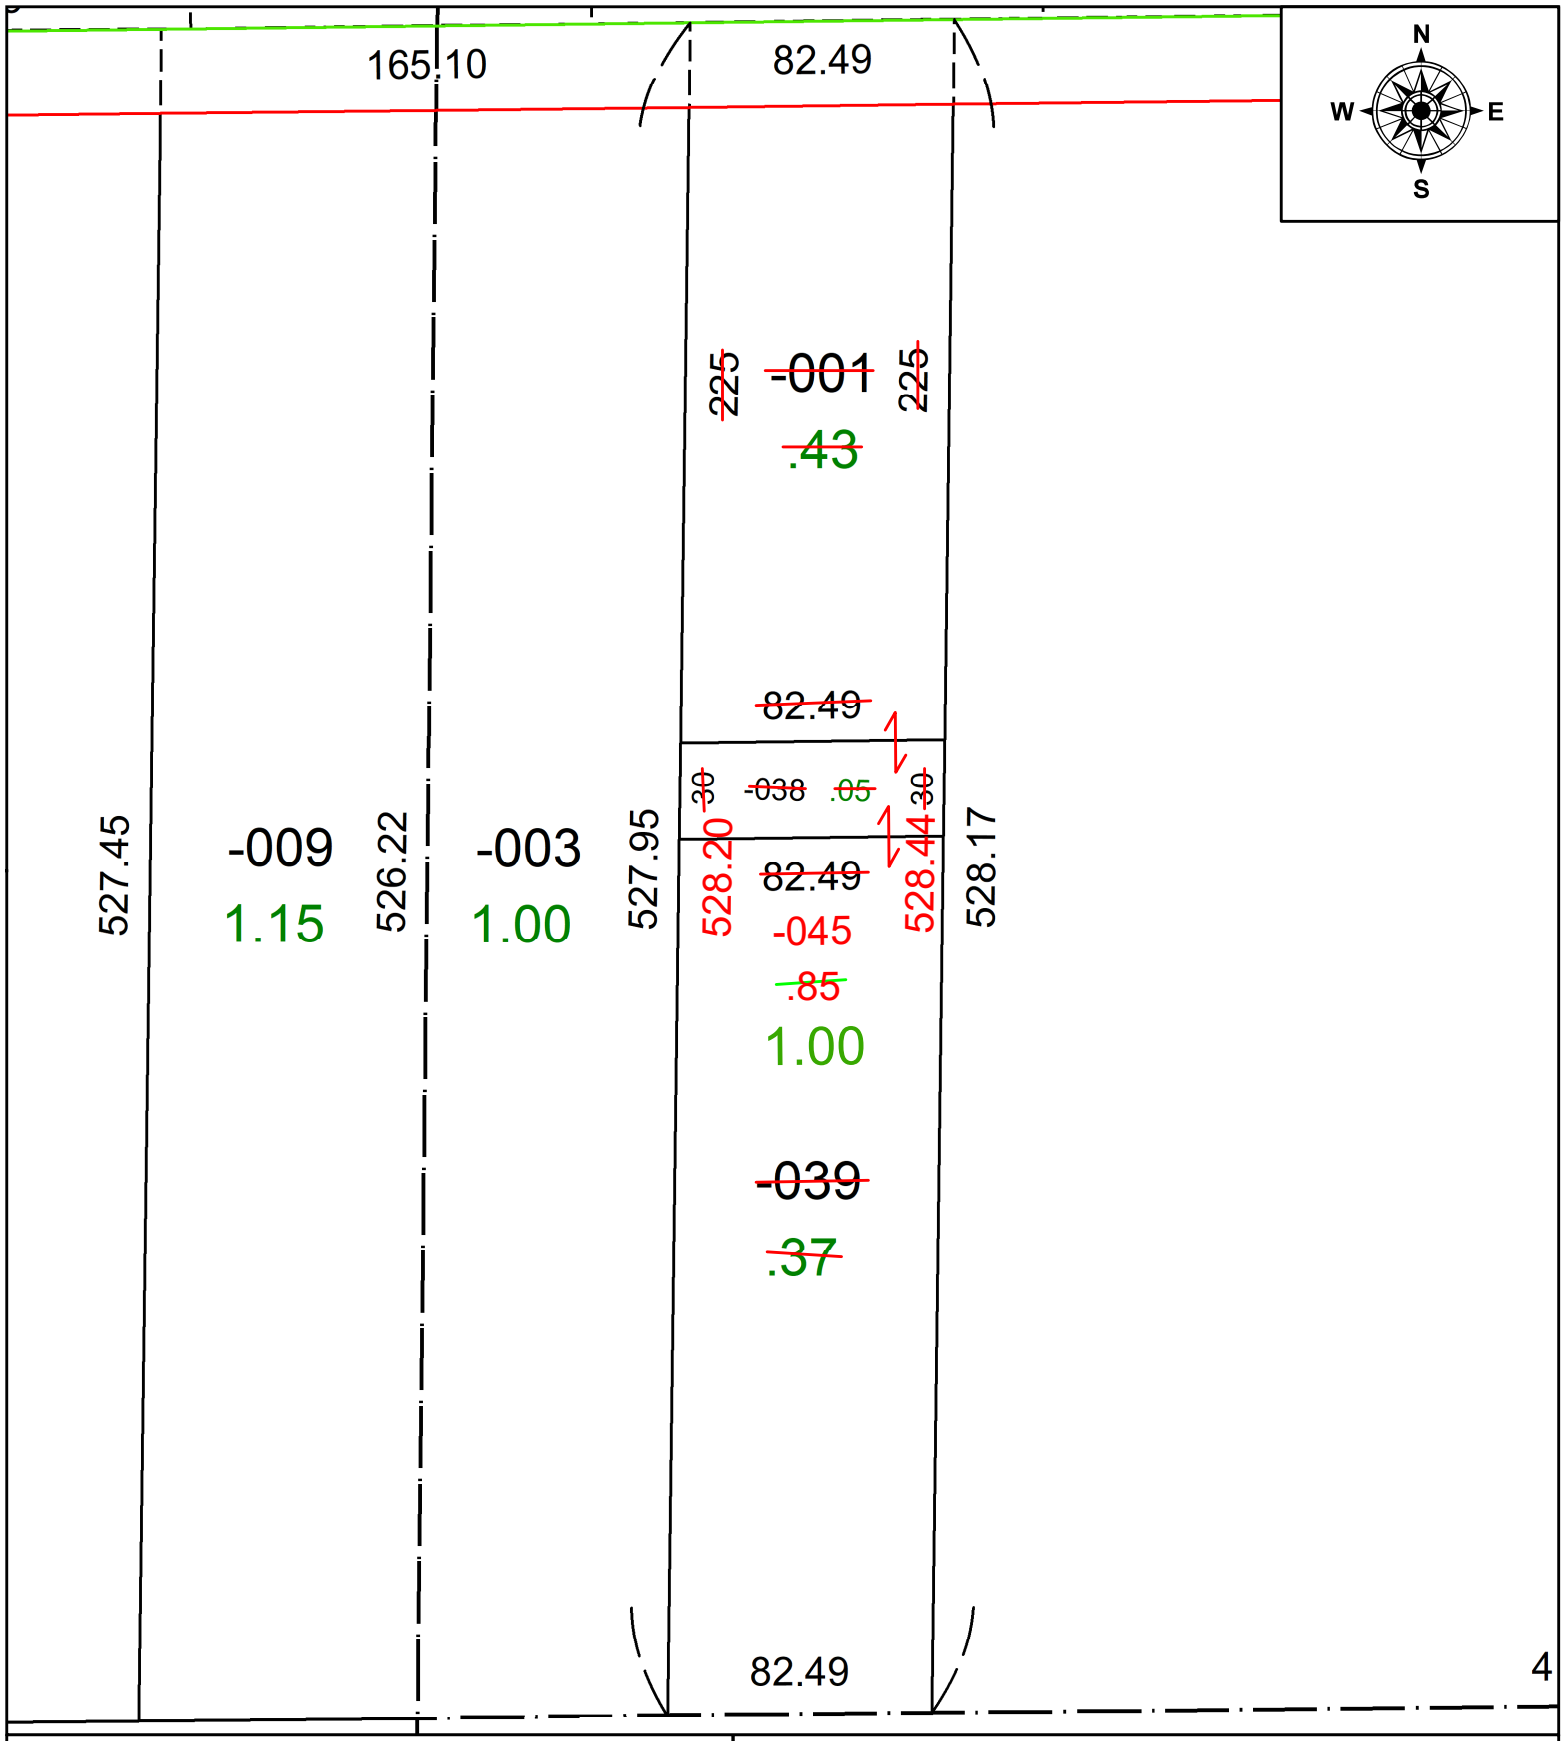

SPLITS/DEEDS PROCESSED

LORAIN COUNTY TAX MAP DEPARTMENT
226 MIDDLE AVE. ELYRIA, OH

SURVEYED BY: THOMAS A. SIMON **SURV # 51538**
CLOSURE: 1: 463190
MAP PAGE(S): 06-24
APPOVED BY: AC **DATE:** September 08, 2025
SCALE: 1 in = 60 ft **PRIOR INSTRUMENT:** 2016- 0585585