PARENT PARCEL: N/A

CHILD PARCEL: 02-02-003-102-093 ADD TO DUPLICATE PER DV 495/115

STARTING POINT: N/A

23-05061-A

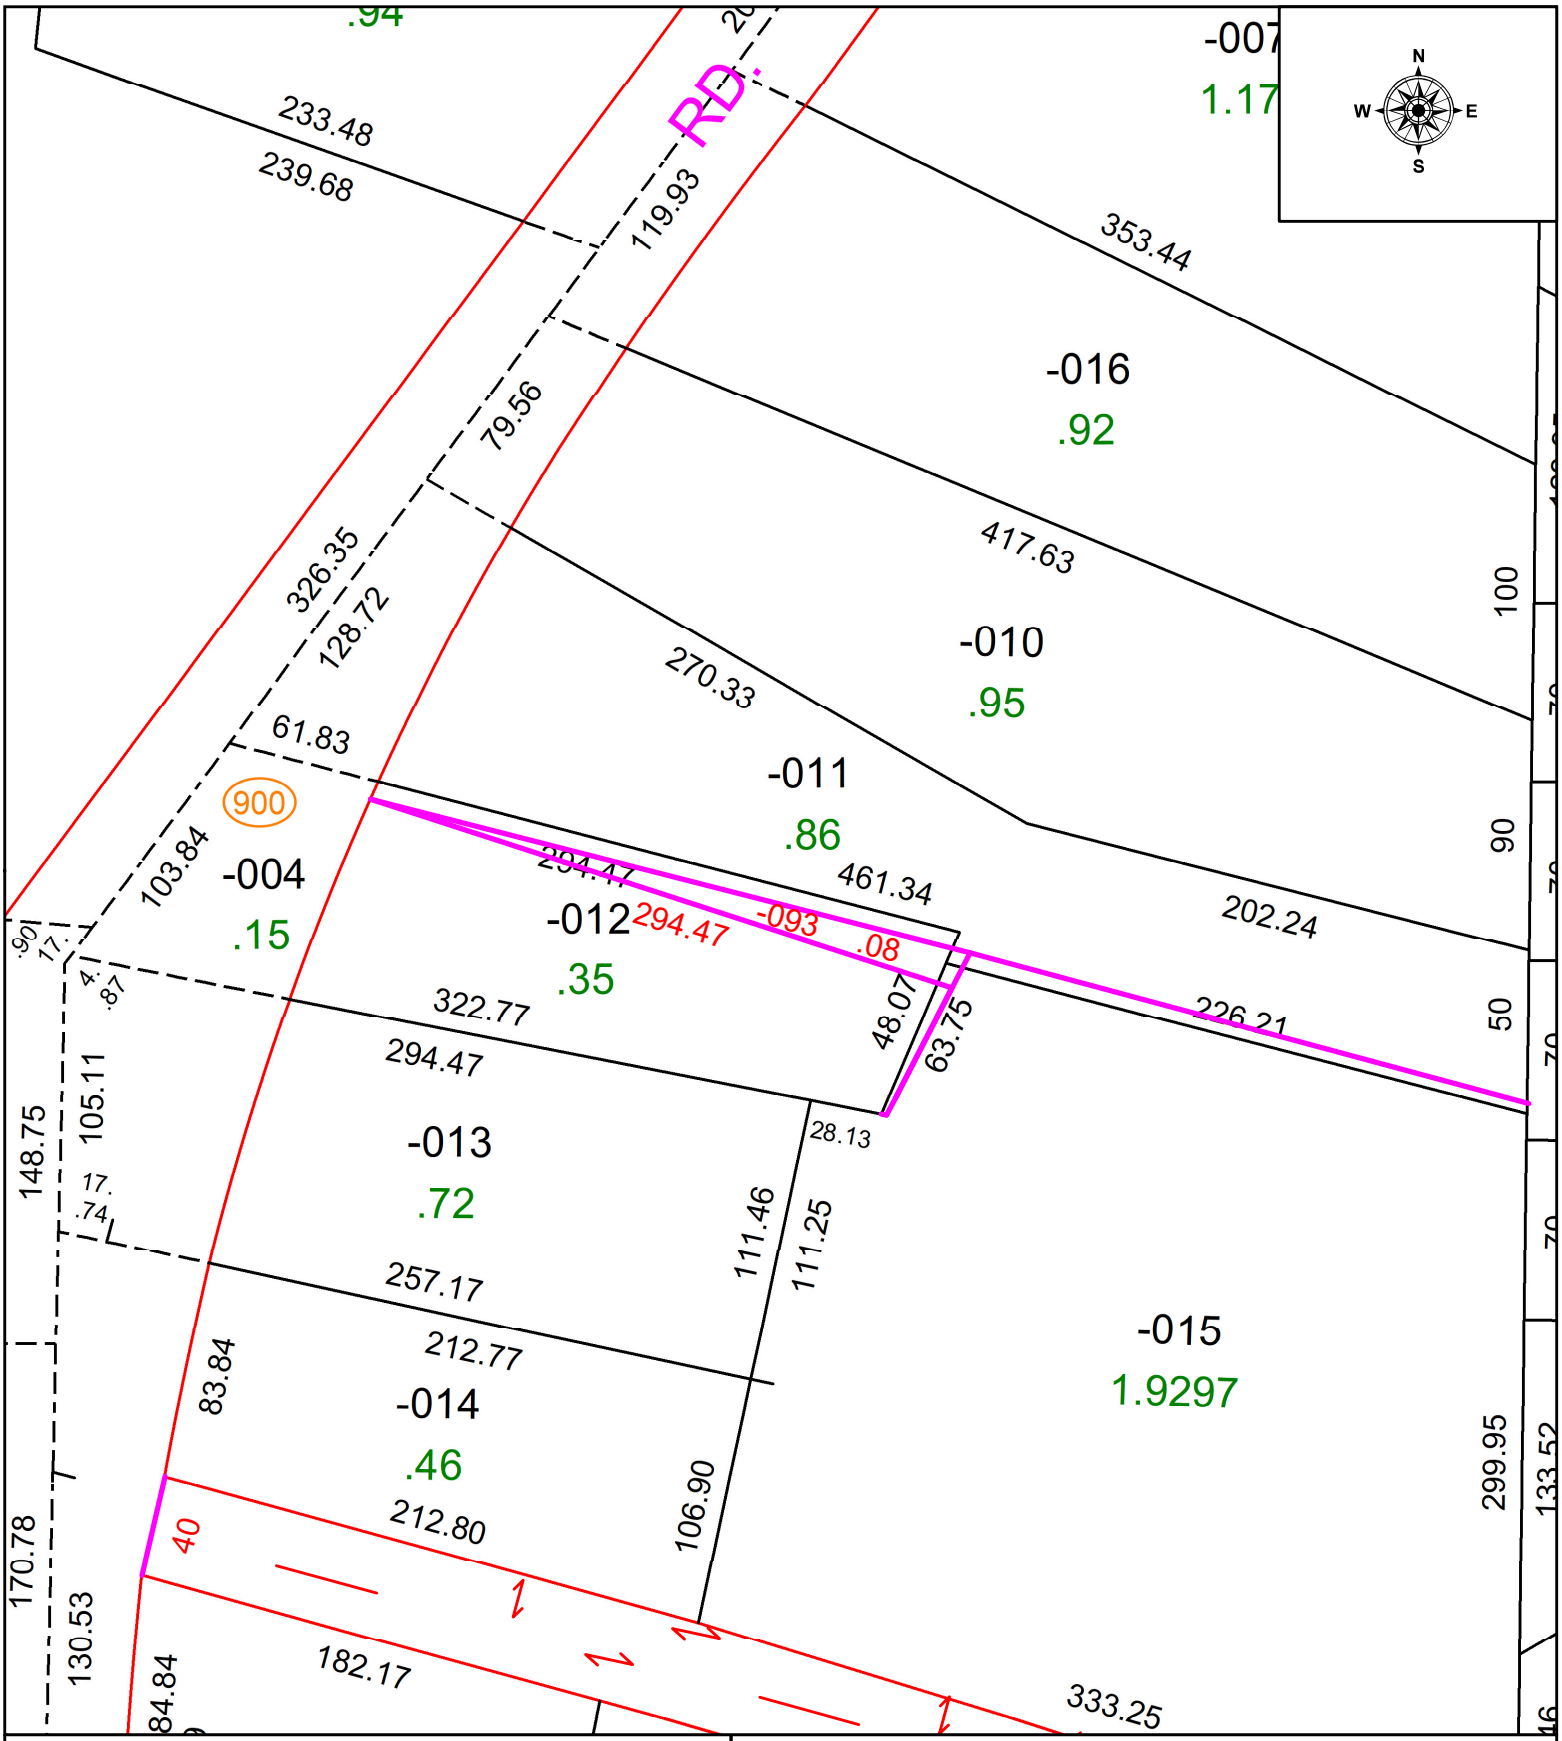

SPLITS/DEEDS PROCESSED

LORAIN COUNTY TAX MAP DEPARTMENT
226 MIDDLE AVE. ELYRIA, OH

SURVEYED BY: N/A SURVEY # N/A
CLOSURE: 1: N/A
MAP PAGE(S): 02-02-003
APPOVED BY: WRZ **DATE:** 3/31/2023
SCALE: 1" = 50 **PRIOR INSTRUMENT:** DV 495/115