PARENT PARCEL: 05-00-059-101-023

CHILD PARCEL: 05-00-059-101-024 & -025

STARTING POINT: NW CORNER OF O/L 59

25-05063

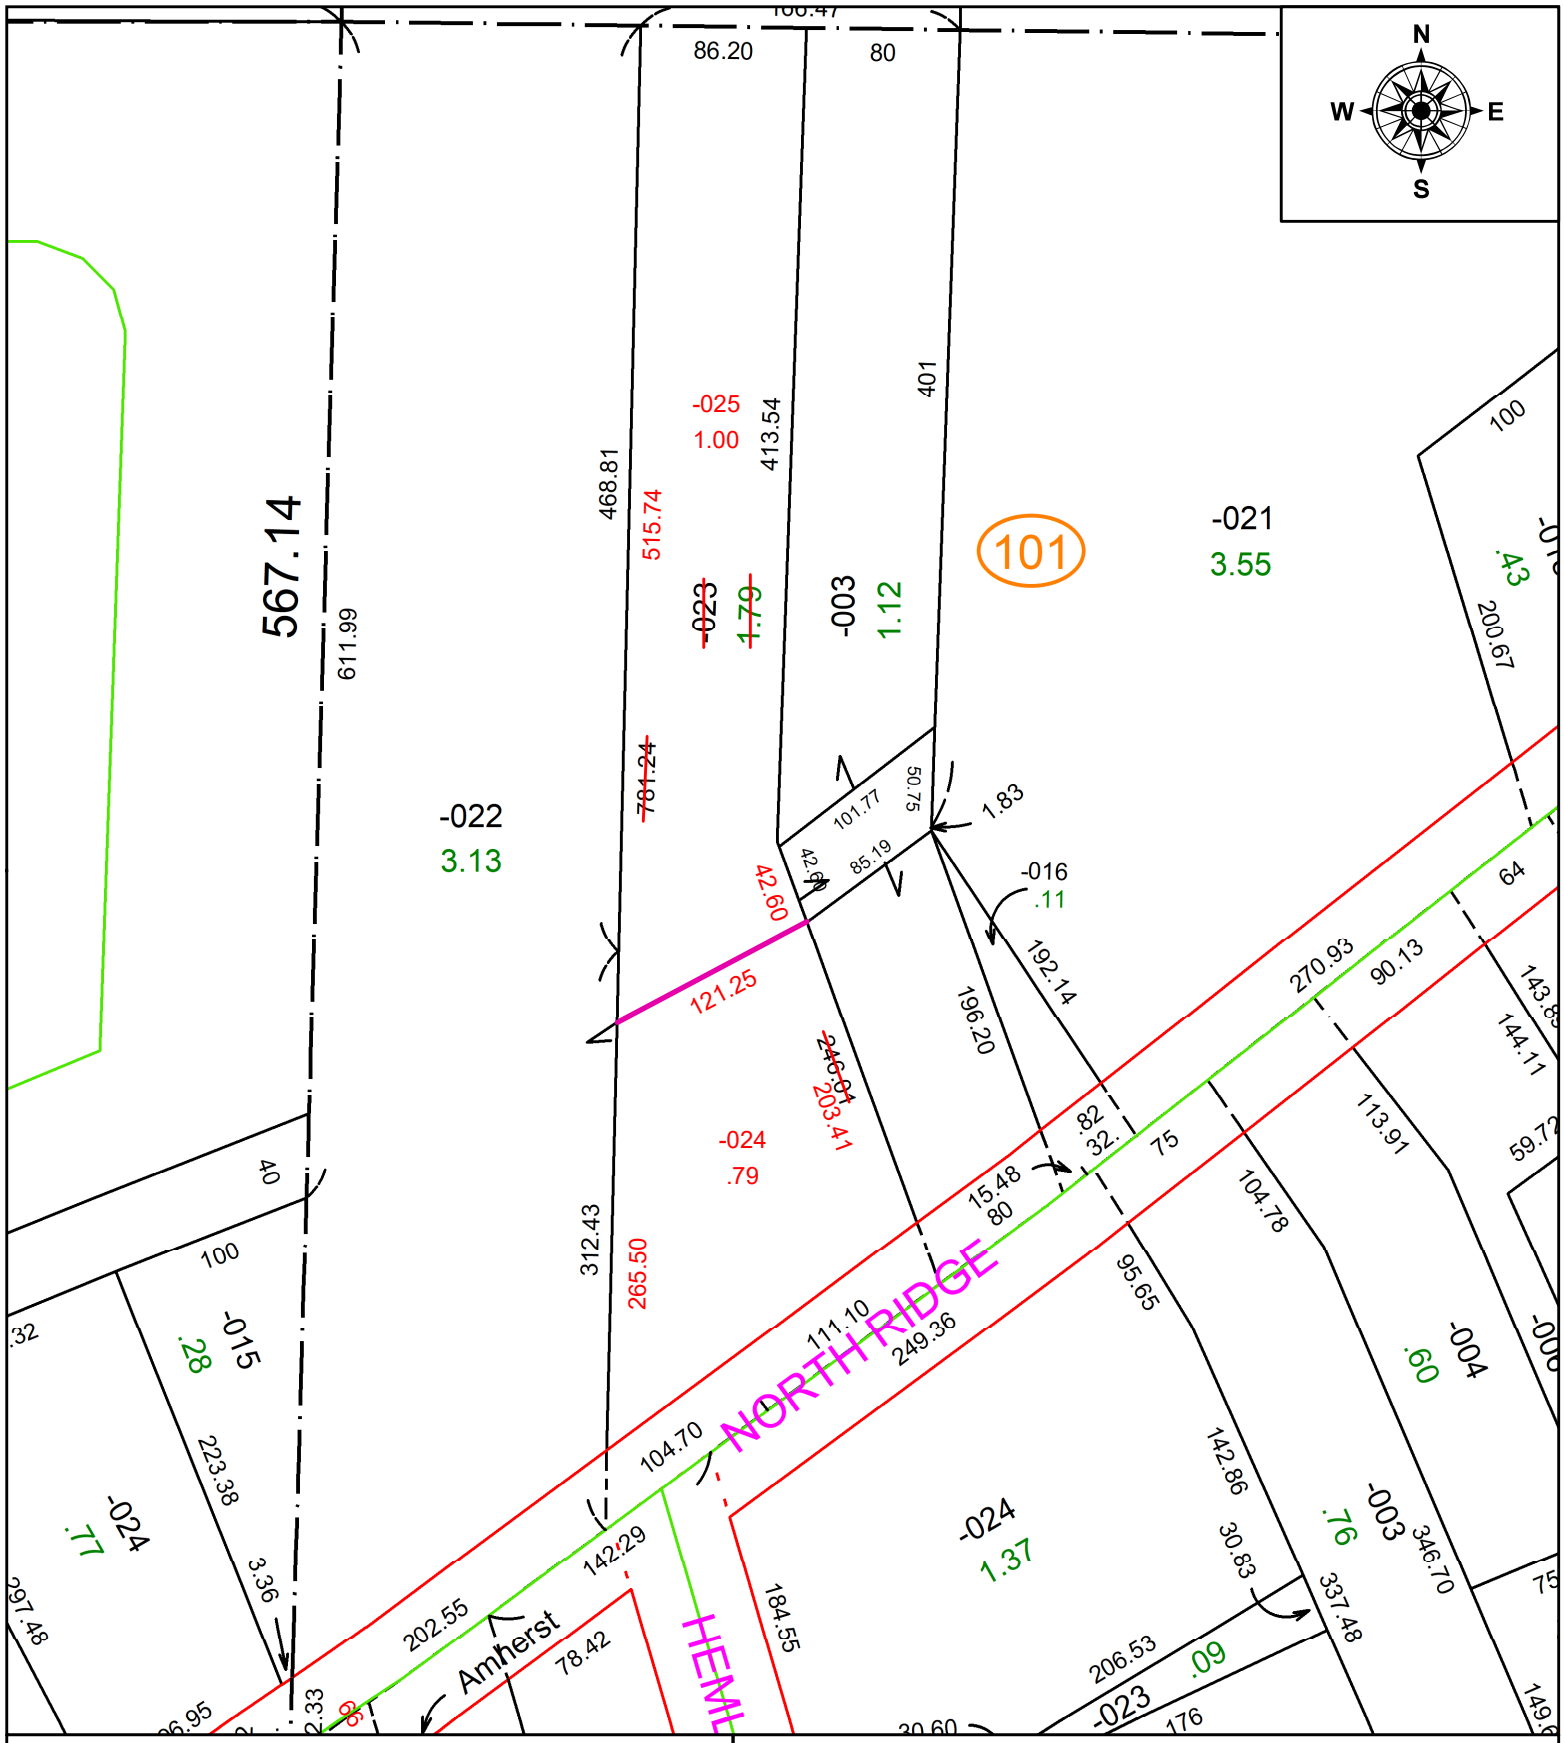

SPLITS/DEEDS PROCESSED

LORAIN COUNTY TAX MAP DEPARTMENT
226 MIDDLE AVE. ELYRIA, OH

SURVEYED BY: THOMAS A. SIMON **SURV # 51545**

CLOSURE: 1: 460603

MAP PAGE(S): 05-00-059

APPOVED BY: AC **DATE:** September 19, 2025

SCALE: 1 in = 100 ft **PRIOR INSTRUMENT:** 2023- 0934698