PARENT PARCEL: 19-04-004-000-001 & -005

CHILD PARCEL: AC CORR PER SURV BY TIMOTHY D. HOZALSKI

STARTING POINT: SE CORNER OF O/L 15

23-05065-A

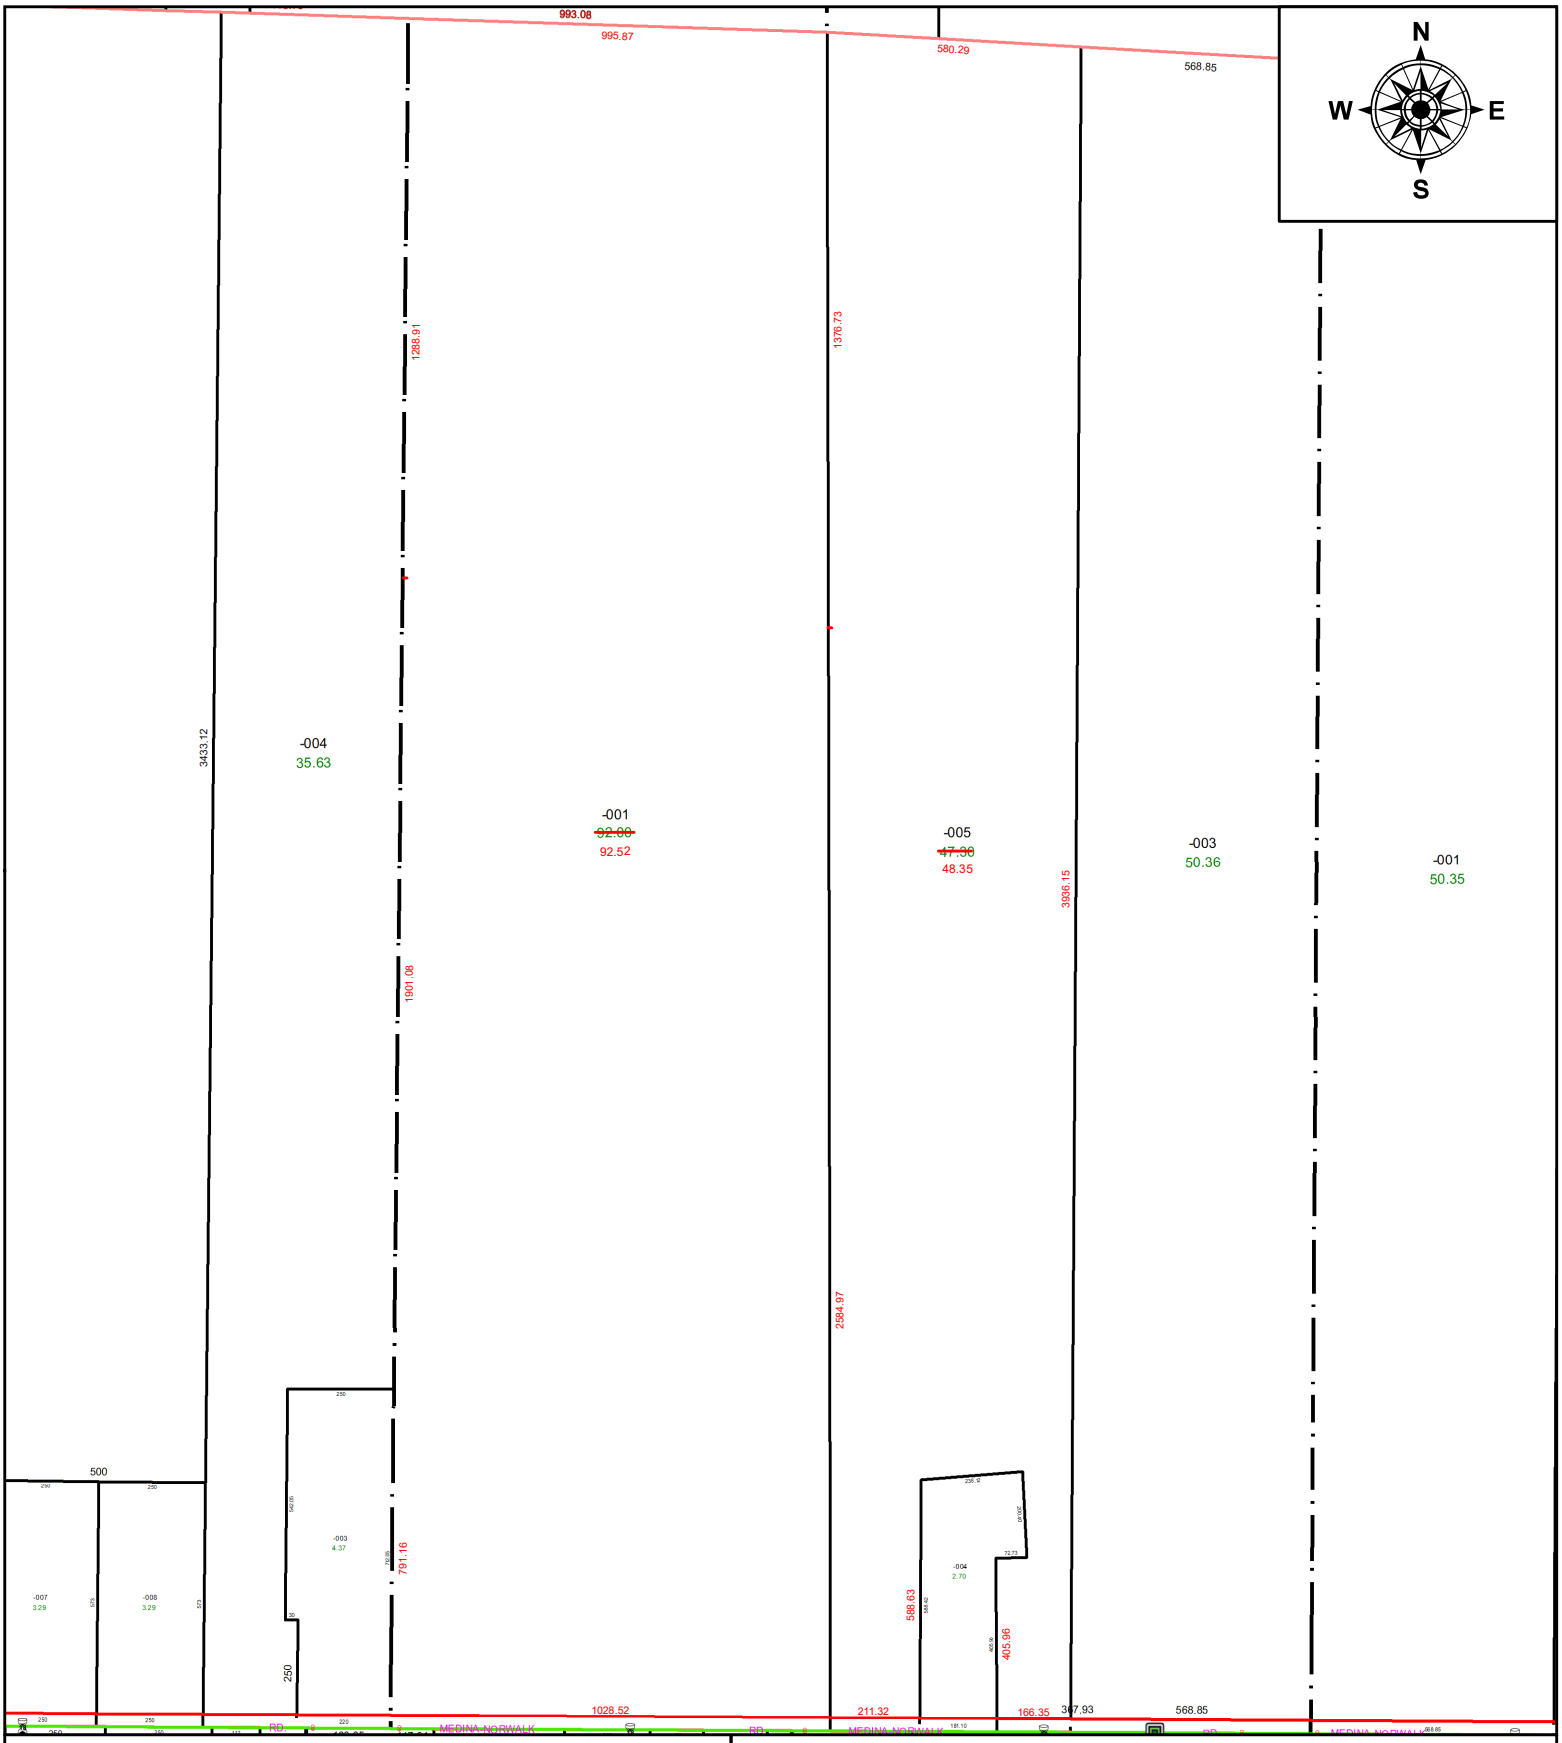

SPLITS/DEEDS PROCESSED

LORAIN COUNTY TAX MAP DEPARTMENT
226 MIDDLE AVE. ELYRIA, OH

SURVEYED BY: TIMOTHY D. HOZALSKI **SURV # 50857**

CLOSURE: 1: 1351299

MAP PAGE(S): 19-04-004

APPOVED BY: AC **DATE:** April 04, 2023

SCALE: 1 in = 450 ft **PRIOR INSTRUMENT:** 2015- 0531938