PARENT PARCEL: 09-00-086-112-036
CHILD PARCEL: 09-00-086-112-046 & -047
STARTING POINT: UNCOMBINATION

23-05069-U

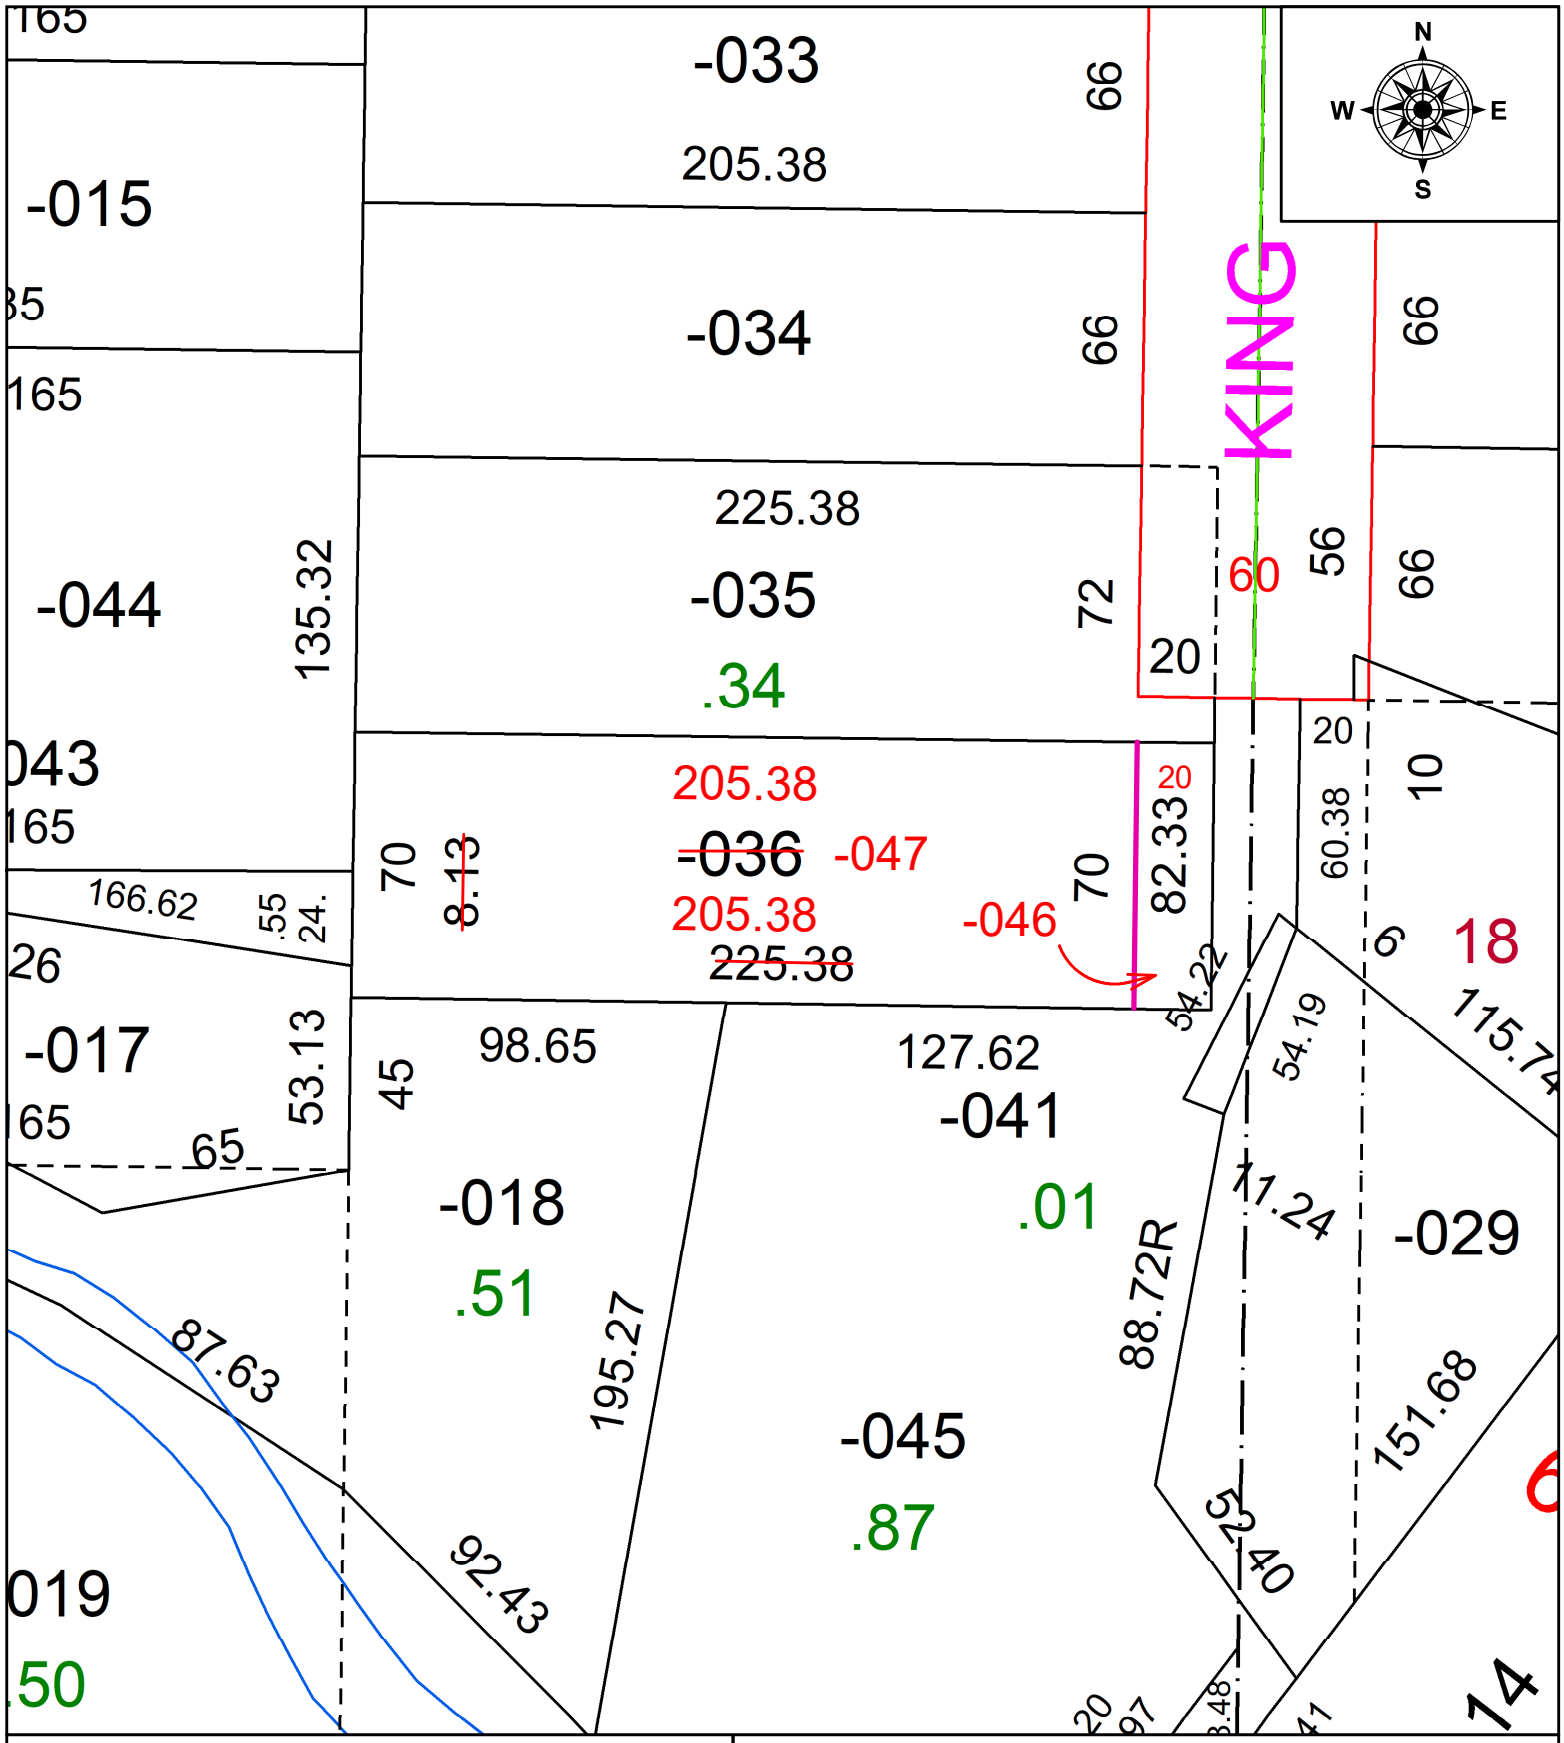

SPLITS/DEEDS PROCESSED
LORAIN COUNTY TAX MAP DEPARTMENT
226 MIDDLE AVE. ELYRIA, OH

SURVEYED BY: N/A **SURV # N/A**
CLOSURE: N/A
MAP PAGE(S): 09-00-086-B
APPOVED BY: AC **DATE:** April 24, 2023
SCALE: 1 in = 50 ft **PRIOR INSTRUMENT:** VOL 506 PG 88