PARENT PARCEL: 07-00-014-103-094

CHILD PARCEL: MAP CORRECTION ONLY

STARTING POINT: C/L OF HONEYCUT DR AND LORAIN RD

23-05070-C

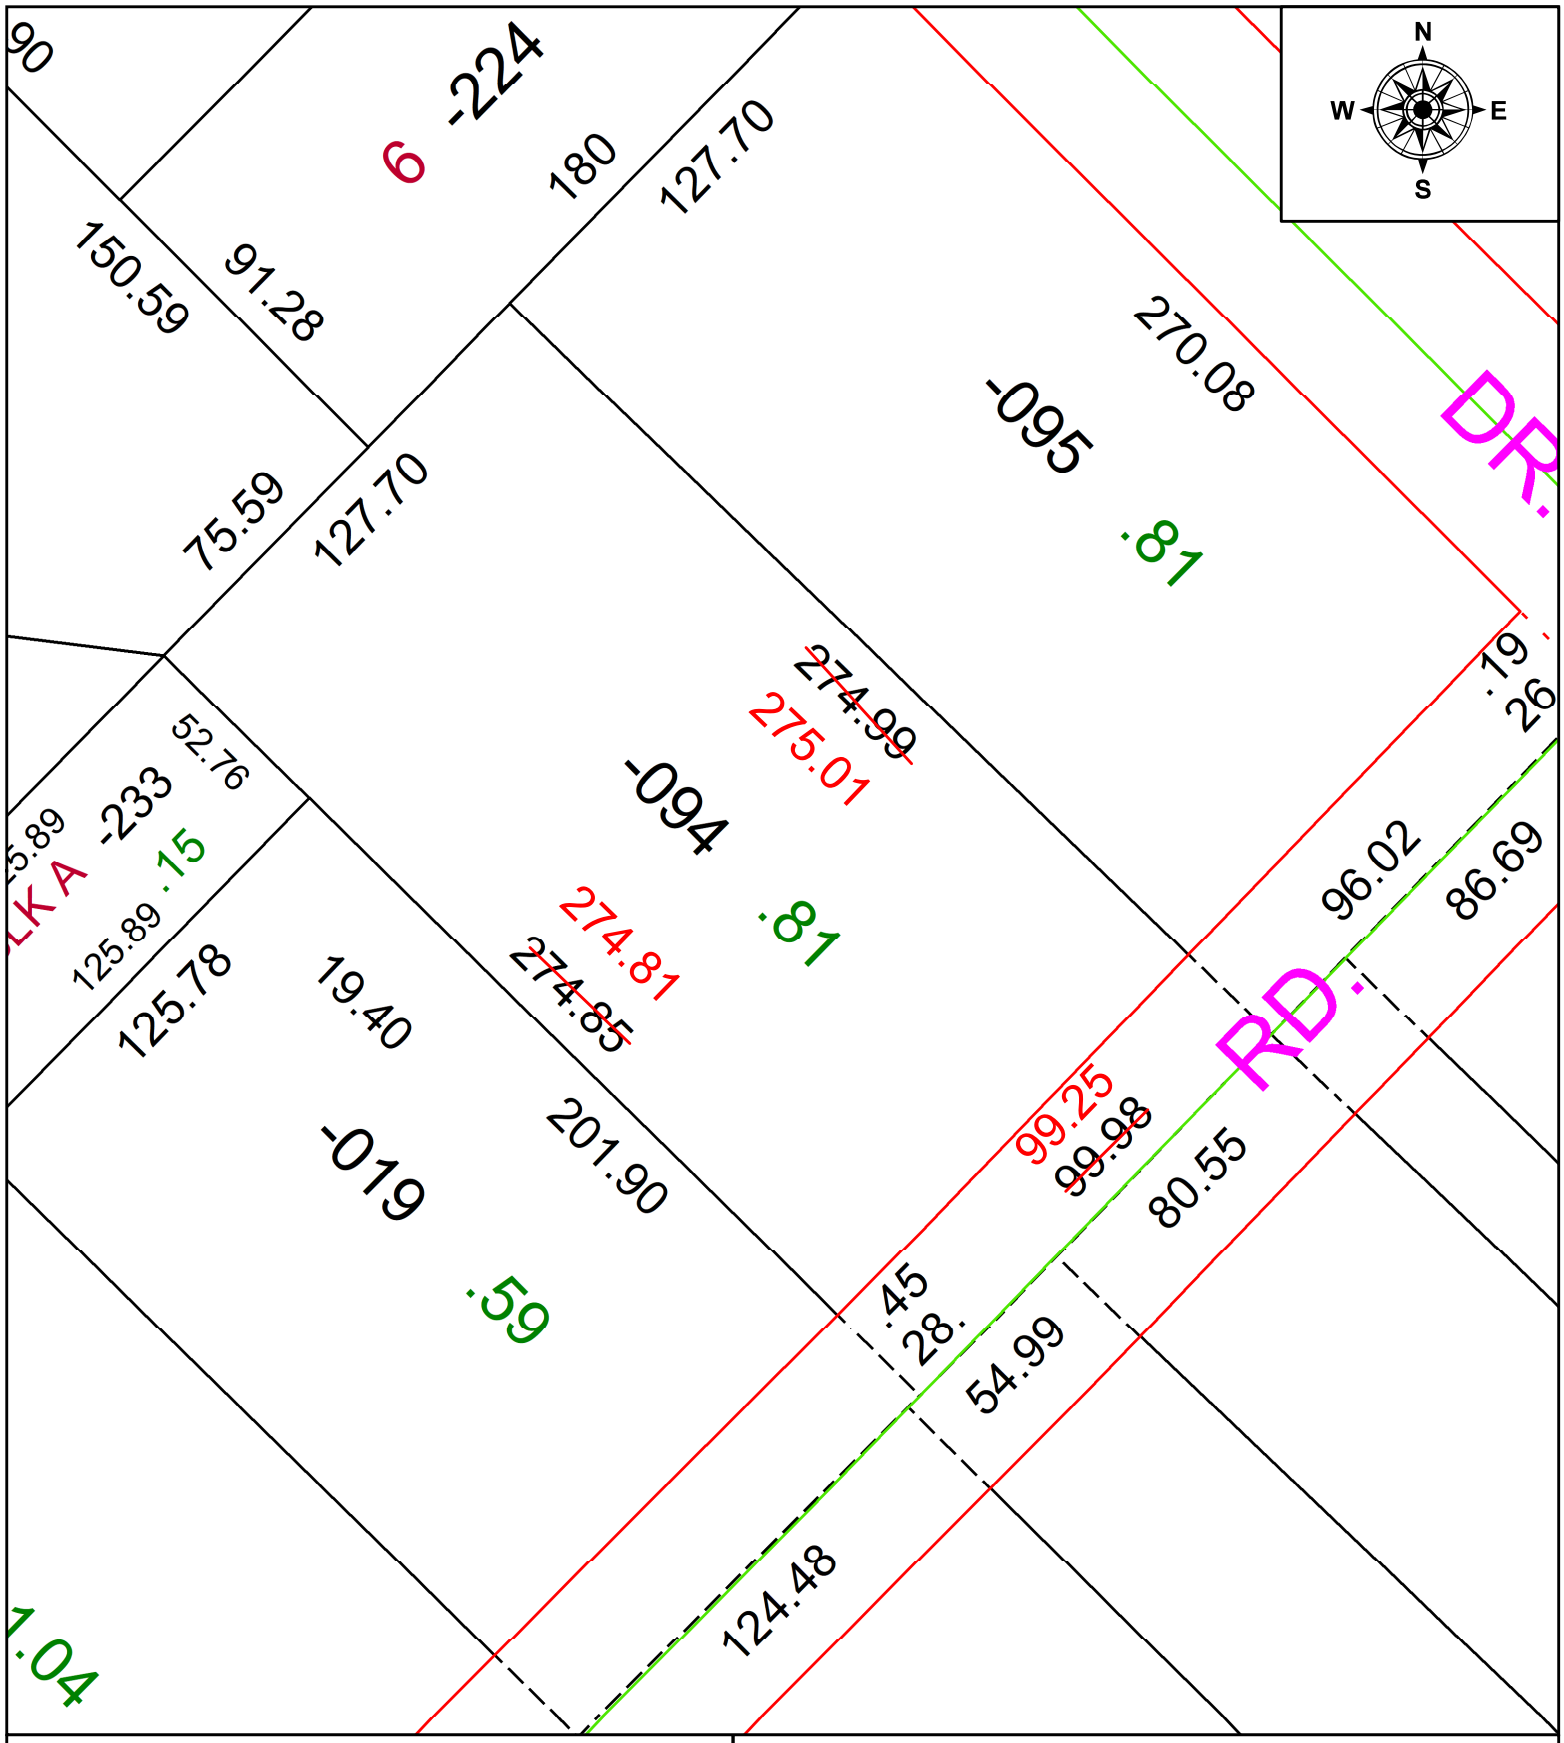

SPLITS/DEEDS PROCESSED

LORAIN COUNTY TAX MAP DEPARTMENT
226 MIDDLE AVE. ELYRIA, OH

SURVEYED BY: SEAN A. BOLAND **SURV # 50873**

CLOSURE: 1: 391642

MAP PAGE(S): 07-00-014

APPOVED BY: AC **DATE:** April 25, 2023

SCALE: 1 in = 50 ft **PRIOR INSTRUMENT:** 2017- 0615065