PARENT PARCEL: 01-00-011-000-004 & 01-00-022-101-002

CHILD PARCEL: AC CORR PER SURV BY ROBERT M. RUFFING

STARTING POINT: C/L OF CLAUS AND BROWNHELM STATION RD

23-05080-A

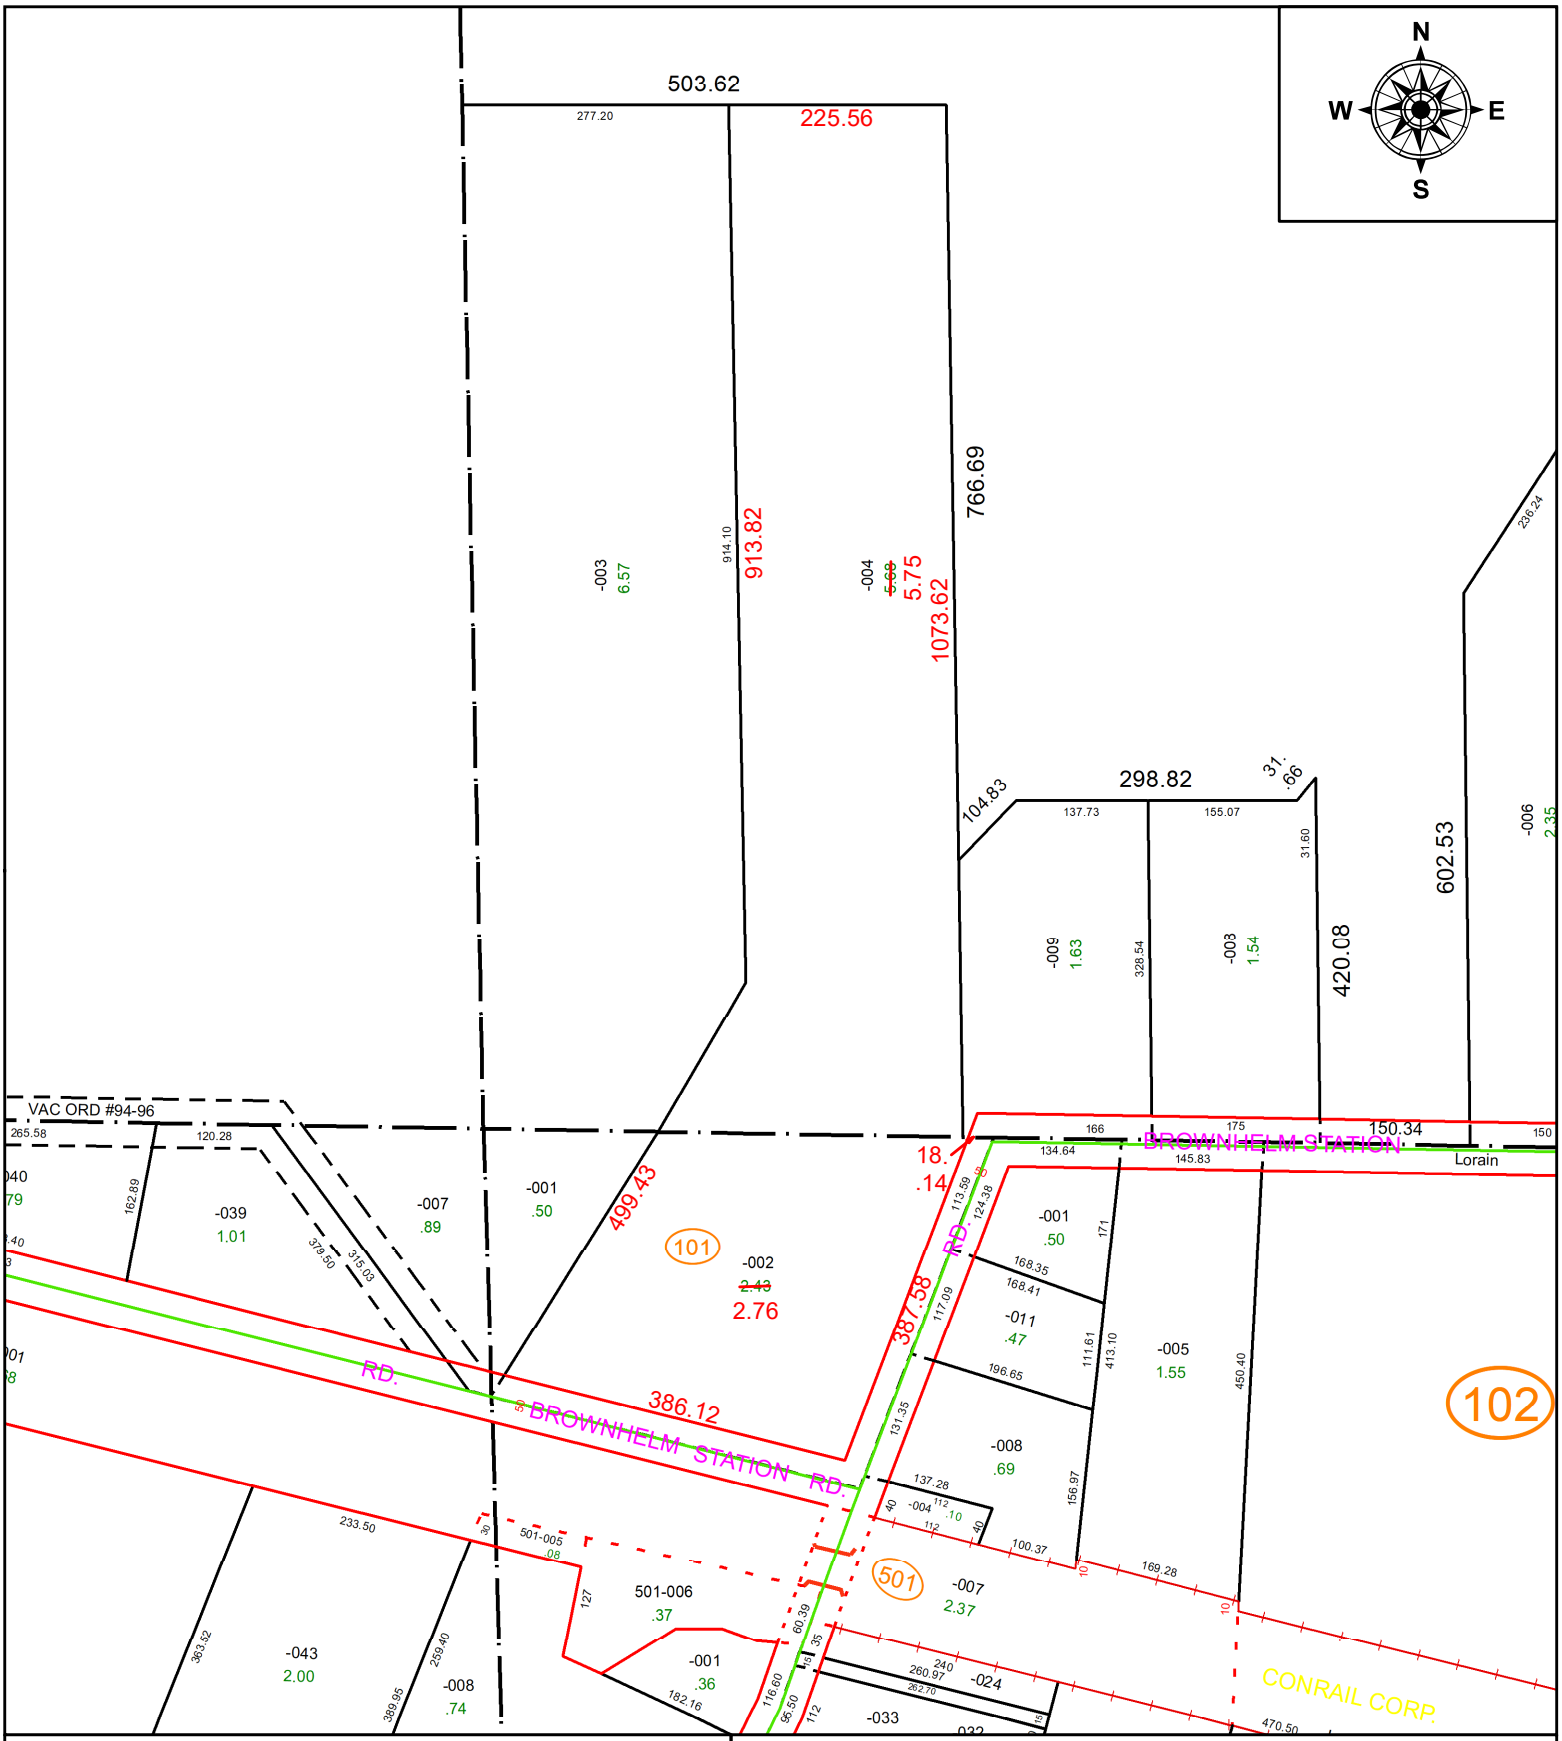

SPLITS/DEEDS PROCESSED

LORAIN COUNTY TAX MAP DEPARTMENT
226 MIDDLE AVE. ELYRIA, OH

SURVEYED BY: ROBERT M. RUFFING **SURV # 50888**

CLOSURE: 1: 549067

MAP PAGE(S): 01-00-022, -011

APPOVED BY: AC **DATE:** May 12, 2023

SCALE: 1 in = 200 ft **PRIOR INSTRUMENT:** 2022- 0870381