PARENT PARCEL: 17-06-024-000-001

CHILD PARCEL: 17-06-024-000-003 & -004

STARTING POINT: C/L OF BIGGS RD

25-05083

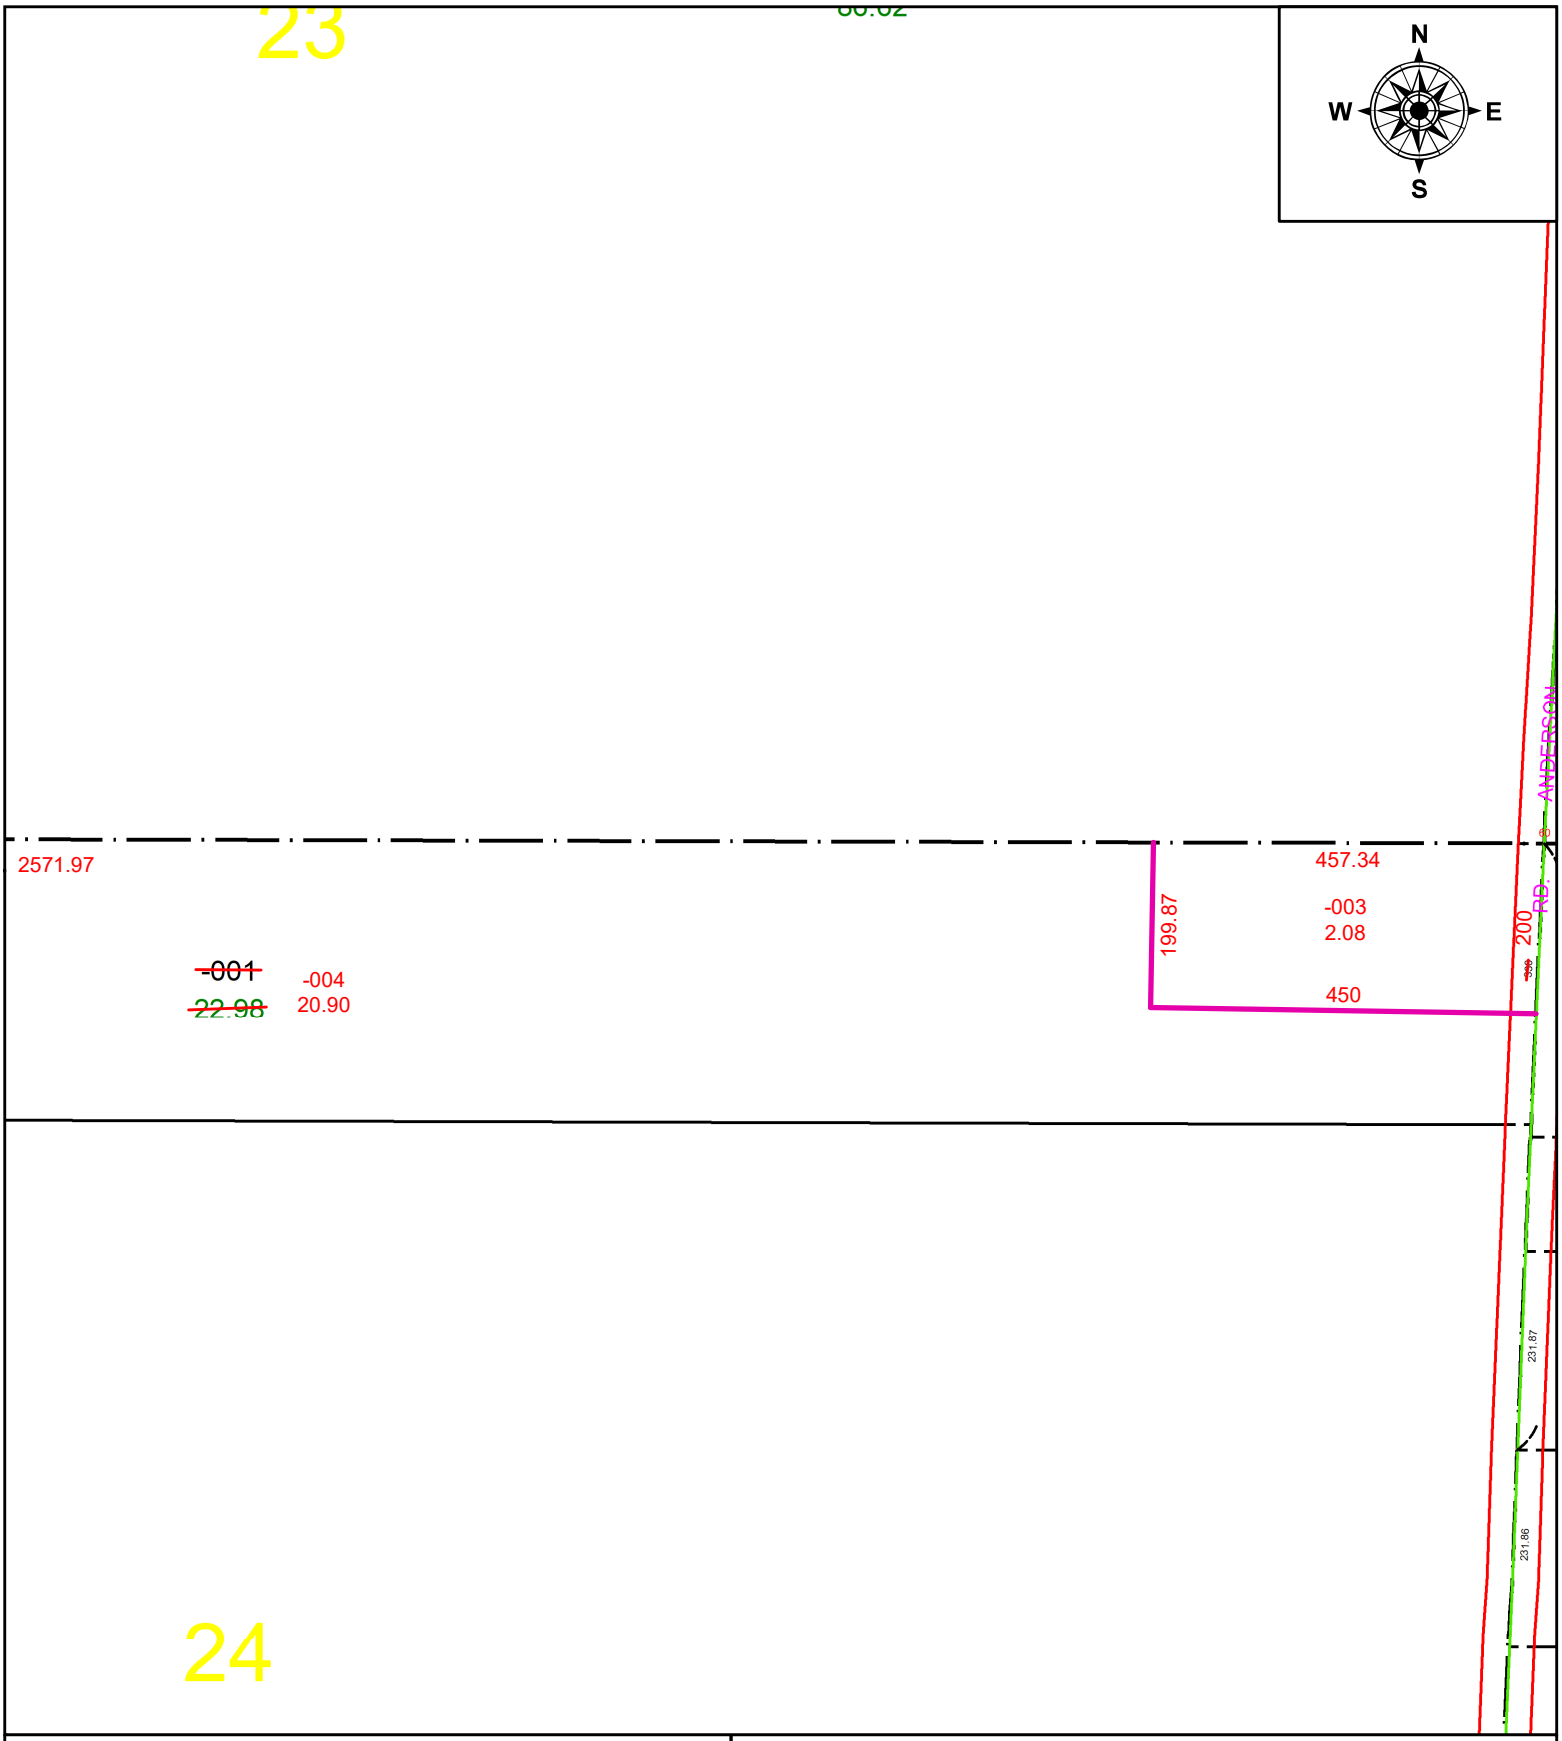

SPLITS/DEEDS PROCESSED

LORAIN COUNTY TAX MAP DEPARTMENT
226 MIDDLE AVE. ELYRIA, OH

SURVEYED BY: JAMES ALLEN COTTRELL **SURV # 51581**

CLOSURE: 1: 274491

MAP PAGE(S): 17-06-024

APPOVED BY: AC **DATE:** October 29, 2025

SCALE: 1 in = 225 ft **PRIOR INSTRUMENT:** 2020- 0763228